

CONSTRUCTION SUMMARY				
Mountainview Heights 3 (G) - Russell Gardens Building Ltd.				
PURCHASERS: Inderpal Singh BASSI and Swati BASSI			TEL: RES.: 647-641-2000 BUS.: 905-488-0448	
LOT / PHASE	REG. PLAN #	HOUSE TYPE		
487 / 4	62M-1266	Springfield One (4 Bedroom) Elev 3		

CABINETRY

1 - CABINETRY - KITCHEN - HARDWARE UPGRADE 1- INCLUDING MINISTACKED UPPERS 28Apr22 Note:		
1 - KITCHEN - CM 11 CROWN MOULDING 01Apr22 Note:		
1 - KITCHEN - LIGHT VALANCE 01Apr22 Note:		
1 - KITCHEN - UPGRADE 1 UPPER CABINETRY WITH UPGRADE 2 BASE CABINETRY & TALL UNITS 01Apr22 Note:		
1 - CABINETRY PROVISION - PROVISION FOR PLUG ON ISLAND (PLUG EXTRA ORDERED SEPARATELY) 01Apr22 Note:		

CABINETRY ACCESSORIES

3 - KITCHEN CABINETRY UPPER – CLEAR GLASS DOOR FOR MINI UPPER – GROUP 1 GLASS – UPGRADE 1 CABINETRY 09May22 Note: PURCHASER ACKNOWLEDGES AND ACCEPTS THAT GLASS BY STOVE IS CORD AND IS DIFFERENT FROM GLASS IN SERVERY		
3 - KITCHEN CABINETRY UPPER - GLASS DOOR - CLEAR GLASS - FINISHED INTERIOR - FITS TALL UPPER CABINETS ONLY - UPGRADE 1 09May22 Note: PURCHASER ACKNOWLEDGES AND ACCEPTS THAT GLASS BY STOVE IS CORD AND IS DIFFERENT FROM GLASS IN SERVERY		
1 - VANITY CABINETRY - RAISE VANITY TO 36" HIGH VANITY IN LIEU OF STANDARD HEIGHT - ENSUITE 3/4 BATHROOM 01Apr22 Note:		
1 - VANITY CABINETRY - RAISE VANITY TO 36" HIGH VANITY IN LIEU OF STANDARD HEIGHT - ENSUITE 2 BATHROOM 01Apr22 Note:		
1 - VANITY CABINETRY - RAISE VANITY TO 36" HIGH VANITY IN LIEU OF STANDARD HEIGHT - MASTER ENSUITE BATHROOM 01Apr22 Note:		
1 - VANITY CABINETRY - RAISE VANITY TO 36" HIGH VANITY IN LIEU OF STANDARD HEIGHT - POWDER ROOM 01Apr22 Note:		
1 - KITCHEN - REDUCE LENGTH OF ISLAND BY APPROX 2' 01Apr22 Note:		
1 - KITCHEN CABINETRY UPPER - UPPER CABINETS - FITS TALL UPPER CABINETS - FILL IN PREVIOUS FRIDGE LOCATION - UPGRADE 2 01Apr22 Note:		
1 - KITCHEN CABINETRY BASE - BASE AND STANDARD COUNTER - FILL IN PREVIOUS FRIDGE LOCATION - UPGRADE 2 01Apr22 Note:		
1 - KITCHEN - RELOCATE FRIDGE - SEE SKETCH 01Apr22 Note:		
1 - CABINETRY FEE FOR FLUSH CUTOUT ON WALL SINGLE MICROWAVE CABINET 01Apr22 Note:		
1 - CABINETRY FEE FOR FLUSH CUTOUT ON WALL OVEN/MICROWAVE COMBO CABINET ONLY 01Apr22 Note:		

CONSTRUCTION SUMMARY				
Mountainview Heights 3 (G) - Russell Gardens Building Ltd.				
PURCHASERS: Inderpal Singh BASSI and Swati BASSI			TEL: RES.: 647-641-2000 BUS.: 905-488-0448	
LOT / PHASE	REG. PLAN #	HOUSE TYPE		
487 / 4	62M-1266	Springfield One (4 Bedroom) Elev 3		
1 - KITCHEN - BLU MOTION DRAWERS 01Apr22 Note:				
1 - KITCHEN - SOFT CLOSING CABINETRY 01Apr22 Note:				
1 - KITCHEN HOOD CABINETS - CONTEMPORARY WOOD HOOD – UPGRADE 1 01Apr22 Note:				
1 - KITCHEN CABINETRY - BUILT-IN FRIDGE CABINET - PRICE IS EACH 01Apr22 Note:				
1 - KITCHEN CABINETRY UPPER - FULL DEPTH ABOVE FRIDGE - WITH GABLES - 600MM - PRICE IS EACH - UPGRADE 2 01Apr22 Note:				
8 - KITCHEN CABINETRY ACCESSORY - PULLOUT SHELVES - PANTRIES ONLY 01Apr22 Note:				
1 - KITCHEN CABINETRY BASE - POT/PAN DRAWERS (CABINET) - UPGRADE 2 01Apr22 Note:				
1 - KITCHEN - CREATE OPENING FOR WINE FRIDGE 01Apr22 Note:				
1 - KITCHEN CABINETRY BASE - BANK OF DRAWERS - UPGRADE 2 01Apr22 Note:				
1 - KITCHEN - RELOCATE STANDARD BANK OF DRAWERS TO ISLAND 01Apr22 Note:				
1 - KITCHEN CABINETRY BASE - PULLOUT RECYCLE 4 BIN - PRICE IS EACH 01Apr22 Note:				
1 - KITCHEN CABINETRY ACCESSORY - LEMANS CORNER MECHANISM - 450MM MIN CABINET - PRICE IS EACH 01Apr22 Note:				
2 - KITCHEN CABINETRY BASE - PULLOUT WIRE SPICE RACK - PRICE IS EACH 01Apr22 Note:				
1 - KITCHEN CABINETRY BASE - TOP DRAWER DOUBLE - UPGRADE 2 01Apr22 Note:				
1 - KITCHEN CABINETRY BASE - POT/PAN DRAWERS (CABINET) SECOND SET BELOW COOKTOP - UPGRADE 2 01Apr22 Note:				
1 - KITCHEN CABINETRY BASE - COOKTOP CABINET WITH POT DRAWERS (2 DRAWERS) - UPGRADE 2 01Apr22 Note:				
1 - KITCHEN CABINETRY - BUILT-IN MICROWAVE/COFFEE MAKER COMBO - UPGRADE 2 01Apr22 Note:				
1 - KITCHEN CABINETRY - BUILT-IN DOUBLE OVEN - UPGRADE 2 01Apr22 Note:				

CONSTRUCTION SUMMARY				
Mountainview Heights 3 (G) - Russell Gardens Building Ltd.				
PURCHASERS: Inderpal Singh BASSI and Swati BASSI			TEL: RES.: 647-641-2000 BUS.: 905-488-0448	
LOT / PHASE	REG. PLAN #	HOUSE TYPE		
487 / 4	62M-1266	Springfield One (4 Bedroom) Elev 3		
4 - KITCHEN CABINETRY UPPER - GLASS DOOR - GLK340 CORD GLASS - FINISHED INTERIOR - FITS TALL UPPER CABINETS ONLY - UPGRADE 1 01Apr22 Note:				
1 - KITCHEN CABINETRY UPPER – GLASS DOOR FOR MINI UPPER – GROUP 1 GLASS – UPGRADE 1 CABINETRY - BACK WALL OF KITCHEN RUN ONLY - DOES NOT INCLUDE ABOVE FRIDGE OR SERVERY 01Apr22 Note:				
1 - KITCHEN CABINETRY – MINI STACKED UPPER CABINETS – UPGRADE 1 CABINETRY - IF CONSTRUCTION PERMITS 01Apr22 Note: PURCHASER DECINES CROWN MOULDING				

CERAMIC TILE

1 - DELETE ALL CERAMIC BATHROOM ACCESSORIES - DELETE TOWEL BAR, PAPER HOLDER & SOAP DISH THROUGHOUT 01Apr22 Note:	
1 - TILE - UPGRADE 4 FLOOR TILE - - MUD ROOM 01Apr22 Note:	
1 - TILE - UPGRADE 4 FLOOR TILE - - POWDER ROOM 01Apr22 Note:	
1 - TILE - UPGRADE 4 FLOOR TILE - - FOYER 01Apr22 Note:	
1 - TILE - UPGRADE 1 FLOOR TILE - - LAUNDRY ROOM 01Apr22 Note:	
1 - TILE - UPGRADE 1 WALL TILE - - ENSUITE BATHROOM - SHOWER 01Apr22 Note:	
1 - TILE - UPGRADE 1 FLOOR TILE - - ENSUITE BATHROOM - FLOOR 01Apr22 Note:	
1 - TILE - UPGRADE 1 WALL TILE - - BATHROOM 3/4 - SHOWER 01Apr22 Note:	
1 - TILE - UPGRADE 1 FLOOR TILE - - BATHROOM 3/4 - FLOOR 01Apr22 Note:	
1 - TILE - UPGRADE 1 WALL TILE - - BATHROOM 2 - SHOWER 01Apr22 Note:	
1 - TILE - UPGRADE 1 FLOOR TILE - - BATHROOM 2 - FLOOR 01Apr22 Note:	

CONSTRUCTION

1 - KITCHEN - CLOSE WALL BETWEEN KITCHEN & STAIRCASE 01Apr22 Note:	
1 - DELETE OR REDUCE BULK HEADS IN KITCHEN TO ACOMMODATE MINI STACKED UPPERS AND CROWN MOULDING - IF CONSTRUCTION PERMITS 01Apr22 Note:	
1 - KITCHEN – PROVISIONS FOR POT FILLER 24Nov21 Note:	

CONSTRUCTION SUMMARY				
Mountainview Heights 3 (G) - Russell Gardens Building Ltd.				
PURCHASERS: Inderpal Singh BASSI and Swati BASSI			TEL: RES.: 647-641-2000 BUS.: 905-488-0448	
LOT / PHASE	REG. PLAN #	HOUSE TYPE		
487 / 4	62M-1266	Springfield One (4 Bedroom) Elev 3		
1 - FIRST FLOOR INCREASE CEILING HEIGHT FROM 9 FEET TO 10 FEET 22Oct21 Note:				
1 - OAK STAIRS TO BASEMENT FROM MAIN FLOOR-NATURAL FINISH 17Jun21 Note:				
3 - ENLARGE BASEMENT WINDOWS (MAY REQUIRE WINDOW WELLS) - WINDOW IS 30 INCHES X 24 INCHES 17Jun21 Note:				
1 - SMOOTH CEILINGS ON FIRST FLOOR ONLY - DET 17Jun21 Note:				
1 - PROVISION FOR SHAMPOO NICHE APPROX. 24" WIDE X 20" HIGH AS PER SKETCH – IF CONSTRUCTION PERMITS 17Jun21 Note:				
2 - PROVISION FOR SHAMPOO NICHE APPROX. 14" WIDE X 20" HIGH AS PER SKETCH – IF CONSTRUCTION PERMITS 17Jun21 Note:				
COUNTER TOP				
1 - ALL BATHROOMS - 3" RETURN ON COUNTERTOPS 01Apr22 Note:				
1 - UPGRADE QUARTZ COUNTERTOP IN LIEU OF STANDARD GRANITE AS PER OFFER - Kitchen 01Apr22 Note:				
1 - UPGRADE HARD SURFACE COUNTERTOP - Powder 01Apr22 Note:				
1 - UPGRADE HARD SURFACE COUNTERTOP - Master 01Apr22 Note:				
1 - UPGRADE HARD SURFACE COUNTERTOP - Bdrm 3/4 01Apr22 Note:				
1 - UPGRADE HARD SURFACE COUNTERTOP - Main 2 01Apr22 Note:				
1 - SHAMPOO NICHE 24" WIDE X 20" HIGH AS PER SKETCH – MARBLE, GRANITE OR QUARTZ – IF CONSTRUCTION PERMITS - REQUIRES PROVISION FROM CONSTRUCTION - MASTER ENSUITE BATHROOM 01Apr22 Note: SUPPLY & INSTALL				
2 - SHAMPOO NICHE 14" WIDE X 20" HIGH AS PER SKETCH – MARBLE, GRANITE OR QUARTZ – IF CONSTRUCTION PERMITS - REQUIRES PROVISION FROM CONSTRUCTION - ENSUITE 2 & ENSUITE 3/4 BATHROOMS 01Apr22 Note: SUPPLY & INSTALL				
DOORS AND TRIM				
1 - LIBRARY - FROSTED GLASS IN LIEU OF CLEAR GLASS ON FRECH DOOR 01Apr22 Note:				
1 - TRIM - UPGRADE 2- 7-¼" BASEBOARD AND 3" CASING 01Apr22 Note:				
ELECTRICAL				

CONSTRUCTION SUMMARY				
Mountainview Heights 3 (G) - Russell Gardens Building Ltd.				
PURCHASERS: Inderpal Singh BASSI and Swati BASSI			TEL: RES.: 647-641-2000 BUS.: 905-488-0448	
LOT / PHASE	REG. PLAN #	HOUSE TYPE		
487 / 4	62M-1266	Springfield One (4 Bedroom) Elev 3		
1 - KITCHEN - RELOCATE PLUG OF FRIDGE - SEE SKETCH 01Apr22 Note:				
1 - BUILT IN MICRO AND COFFEEMAKER PROVISION - PROVISION ONLY - ELECTRICAL ONLY 01Apr22 Note:				
1 - BUILT IN OVEN AND COOKTOP PROVISION - PROVISION ONLY - ELECTRICAL ONLY 01Apr22 Note:				
1 - PLUG - ELECTRICAL PLUG - FOR BUILT-IN MICROWAVE 01Apr22 Note:				
3 - FAN - BATHROOM EXHAUST FAN - ENERGY STAR 80 CFM - IN LIEU OF STANDARD FAN - ENSUITE BATHROOMS ONLY 01Apr22 Note:				
1 - GENERAL AIRE HUMIDIFIER 01Apr22 Note:				
1 - PLUG - ELECTRICAL PLUG - TO BE INSTALLED OVER FIREPLACE 01Apr22 Note:				
1 - PLUG - ELECTRICAL PLUG - ADD TO ISLAND 01Apr22 Note:				
1 - RELOCATE STANDARD KITCHEN LIGHT TO BE CENTERED OVER ISLAND 01Apr22 Note:				
1 - PLUG - ELECTRICAL PLUG WITH GFI AND SWITCH - FOR FESTIVE LIGHTING 17Jun21 Note:				
1 - 200 AMP ELECTRICAL SERVICE 17Jun21 Note:				
FIREPLACE AND ACCESSORIES				
1 - FIREPLACE SURROUND - UPGRADE TO GRANITE IN LIEU OF MARBLE 01Apr22 Note:				
1 - MANTEL - PAINTED - M6 - IN LIEU OF STANDARD MANTEL 01Apr22 Note:				
1 - GAS LINE ROUGH-IN FOR STOVE (INCLUDES ELECTRICAL OUTLET) - FIRST FLOOR 01Apr22 Note:				
HARDWOOD FLOORING				
1 - HARDWOOD - GROUP B SERIES 6 1/2 INCH - - BEDROOM 4 01Apr22 Note:				
1 - HARDWOOD - GROUP B SERIES 6 1/2 INCH - - BEDROOM 3 01Apr22 Note:				
1 - HARDWOOD - GROUP B SERIES 6 1/2 INCH - - BEDROOM 2 01Apr22 Note:				

CONSTRUCTION SUMMARY				
Mountainview Heights 3 (G) - Russell Gardens Building Ltd.				
PURCHASERS: Inderpal Singh BASSI and Swati BASSI			TEL: RES.: 647-641-2000 BUS.: 905-488-0448	
LOT / PHASE	REG. PLAN #	HOUSE TYPE		
487 / 4	62M-1266	Springfield One (4 Bedroom) Elev 3		
1 - HARDWOOD - GROUP B SERIES 6 1/2 INCH - - MASTER BEDROOM				
01Apr22 Note:				
1 - HARDWOOD - GROUP B SERIES 6 1/2 INCH - - FLEX ROOM				
01Apr22 Note:				
1 - HARDWOOD - GROUP B SERIES 6 1/2 INCH - - UPPER HALL				
01Apr22 Note:				
1 - HARDWOOD - GROUP B SERIES 6 1/2 INCH - IN LIEU OF STANDARD TILE - KITCHEN, BREAKFAST & SERVEY				
01Apr22 Note:				
1 - HARDWOOD - GROUP B SERIES 6 1/2 INCH - IN LIEU OF 2 1/4 INCH NATURAL RED OAK - - MAIN HALL				
01Apr22 Note:				
1 - HARDWOOD - GROUP B SERIES 6 1/2 INCH - IN LIEU OF 2 1/4 INCH NATURAL RED OAK - - LIVING ROOM				
01Apr22 Note:				
1 - HARDWOOD - GROUP B SERIES 6 1/2 INCH - IN LIEU OF 2 1/4 INCH NATURAL RED OAK - - LIBRARY/DEN				
01Apr22 Note:				
1 - HARDWOOD - GROUP B SERIES 6 1/2 INCH - IN LIEU OF 2 1/4 INCH NATURAL RED OAK - - FAMILY ROOM				
01Apr22 Note:				
1 - HARDWOOD - GROUP B SERIES 6 1/2 INCH - IN LIEU OF 2 1/4 INCH NATURAL RED OAK - - DINING ROOM				
01Apr22 Note:				
MIRRORS AND GLASS				
1 - ALL BATHROOMS - DELETE STANDARD MIRRORS - DO NOT INSTALL				
01Apr22 Note:				
1 - SHOWER DOOR HANDLE - CHROME D-RING WITH D-RING - MASTER ENSUITE BATHROOM				
01Apr22 Note:				
1 - FOR CONFIRMATION PURPOSES - DELETE WALL ABOVE SEAT AND ADD FRAMELESS GLASS PANEL ALONG WITH FRAMELESS DOOR				
01Apr22 Note:				
1 - FRAMELESS GLASS SHOWER DOOR - INCLUDES CHROME KNOB & HINGES				
17Jun21 Note: FOR MASTER ENSUITE---				
2 - FRAMELESS GLASS SHOWER DOOR FOR 5 FOOT PAN - INCLUDES CHROME KNOB & HINGES				
17Jun21 Note: FOR ENSUITE 3/4 AND ENS. 2				
PAINTING				
1 - THROUGHOUT - INTERIOR DOORS, BASEBAORDS, TRIM & DOORS - UPGRADE WHITE PAINT				
01Apr22 Note:				
PLUMBING				
1 - SINK - UNDERMOUNT SINK - CONTRAC COLLETTE #4220CIY - POWDER ROOM				
01Apr22 Note:				
4 - SINK - UNDERMOUNT SINK - CONTRAC CATENA #4210CIY - ALL ENSUITE BATHROOMS				
01Apr22 Note:				

CONSTRUCTION SUMMARY

Mountainview Heights 3 (G) - Russell Gardens Building Ltd.

PURCHASERS: Inderpal Singh BASSI and Swati BASSI TEL: RES.: 647-641-2000 BUS.: 905-488-0448

LOT / PHASE	REG. PLAN #	HOUSE TYPE		
487 / 4	62M-1266	Springfield One (4 Bedroom) Elev 3		
4 - TOILET - CONTRAC CALI 1 PC TOILET #4710BOVU (UNLINED TANK) WITH SMOOTH CLOSE SEAT - ALL BATHROOMS 01Apr22 Note:				
6 - SOAP DISPENSER - CHROME FINISH - MOEN S3947C - INSTALLED ON LEFT SIDE OF THE SINKS - ALL BATHROOMS & KITCHEN 01Apr22 Note:				
3 - TOE TESTER - ADD TOE TESTER TO SHOWER - ALL ENSUITE BATHROOMS 01Apr22 Note:				
1 - SINK - UNDERMOUNT SINK - BLANCO QUATRUS R15 U2 #401519 01Apr22 Note:				
1 - KITCHEN – POT FILLER – MOEN MODERN TWO HANDLE POT FILLER FAUCET WITH DUAL SHUT OFFS – #S665 CHROME 24Nov21 Note:				
1 - WATER LINE FOR FRIDGE - ROUGH-IN ONLY 17Jun21 Note:				
1 - add---- ENSUITE 3/4-----5 FOOT SHOWER WITH SLIDING GLASS CHROME DOORS IN LIEU OF TUB 17Jun21 Note:				
3 - MOEN 90 DEGREE POSI-TEMP SHOWER ONLY WITH 3 FUNCTION TRANSFER VALVE/TRIM AND SLIDE BAR WITH HAND SHOWER – CHROME #TS2712EP/U361CI/UTS4172/62320/S3879EP/A721 17Jun21 Note: FOR ALL SHOWERS				

PROMOTIONAL

1 - LESS CREDIT FROM PURCHASER EXTRA SHEET IN OFFER 17Jun21 Note:	
--	--

STAIRS AND RAILINGS

1 - STAINED STAIRS – STANDARD STAIRCASE - PRICE IS PER SET 01Apr22 Note:	
1 - STAIRCASE - EUROLINE 1 IRON PICKETS - BLACK 01Apr22 Note:	

EXTRAS AS PER OFFER

PURCHASER(S) ACKNOWLEDGES THAT THE PURCHASE PRICE IS INCLUSIVE OF ALL CREDITS AND PROMOTIONAL PACKAGES AVAILABLE AT TIME OF PURCHASE. Worksheet Note:	
(1) The Vendor agrees that notwithstanding any other term or provision in this Agreement included in the Purchase Price and in addition to those items detailed in Schedule GP to the Agreement of Purchase and Sale, the Purchaser is entitled to a credit of Worksheet Note:	
Granite kitchen counter top, from Vendor?s standard samples Worksheet Note:	

This Document is Extremely Time Sensitive - Printed 9 May 22 at 16:40

Purchasers: Inderpal Singh BASSI & Swati BASSI

Property: 487

Telephone Res. / Bus: (647) 641-2000 / (905) 488-0448

Project: Russell Gardens Building Ltd.

Decor Advisor: Candace Forza

Model and Elevation: Springfield One (4 Bedroom) Elev 3

Lock Date: 28-Apr-22

1-Apr-22

Plan #: 62M-1266

Layout Changes: ☒ Yes ☐ No

Sketch Attached: ☒ Yes ☐ No

Exterior Colour Scheme:

1. Cabinetry

	Style and Colour	Hardware
Kitchen / Breakfast	SEE BELOW	593SC
Laundry Room	ELISSE	Standard
Powder Room	MONACO 350 PLATINUM SILVER	468SA
Master Ensuite Bathroom	DORAL K38 RIVERSIDE	467SA
Ensuite Bath - Bedroom 2	DORAL H3078 HACIENDA WHITE	468SA
Ensuite Bath - Bedroom 3/4	DORAL H3453 LAVA GREY FLEETWOOD	468SA
	N/A	N/A
	N/A	N/A
	N/A	N/A

Appliances:

Built In Appliances ☒ Yes ☐ No

Slide In Stove ☐ Yes ☒ No

Dishwasher Cabinet ☐ Closed ☒ Open

41" Upper Cabinets ☒ Yes ☐ No

Please NOTE: Standard Cabinet Height is 30"

Stove Opening

NOTE: If not specified, opening will be set to builder's standard opening of approximately 30" width

Fridge Opening

NOTE: If not specified, opening will be set to builder's standard opening of approximately 37" width x 74" height

KITCHEN - BASE & TALL UNITS-HAMPTON 350 PLATINUM SILVER *** UPPERS - ARCADIA HD-23 CANYON BIANCO

** Refer to Construction Summary


2. Counters

	Counter	Edge
Kitchen / Breakfast	QUARTZ-MISTRAL	#360
Laundry Room	N/A	
Powder Room	QUARTZ-FUSION WHITE	#360
Master Ensuite Bathroom	GRANITE-COLONIAL WHITE	#360
Ensuite Bath - Bedroom 2	QUARTZ-BELLAGIO	#360
Ensuite Bath - Bedroom 3/4	QUARTZ-VICTORIA	#360
	N/A	
	N/A	
	N/A	

** Refer to Construction Summary

THIS LAYOUT CONTAINS EXTRAS
THAT ARE NOT PART OF CONTRACT

THIS LAYOUT CONTAINS EXTRAS
THAT ARE NOT PART OF CONTRACT

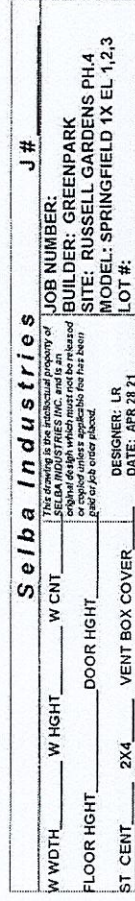

<i>This drawing is the intellectual property of SELBA INDUSTRIES INC. and it is not to be reproduced, stored in a retrieval system, or employed unless a specification has been paid or job order placed.</i>		<i>This drawing is the intellectual property of SELBA INDUSTRIES INC. and it is not to be reproduced, stored in a retrieval system, or employed unless a specification has been paid or job order placed.</i>	
W WIDTH _____ W HIGHT _____ W CNT _____		JOB NUMBER: _____	
FLOOR HIGHT _____ DOOR HIGHT _____		BUILDER: GREENPARK	
ST CNT _____ 2X4 _____ VENT BOX COVER _____		SITE: RUSSELL GARDENS PH.4	
_____		MODEL: SPRINGFIELD 1X EL 12.3	
_____		LOT #: _____	
_____		DESIGNER: LR	
_____		DATE: APR 28 '21	

W WIDTH _____	W HIGHT _____	W CNT _____	This drawing is the intellectual property of SELMA INDUSTRIES INC. and its original design which must not be released or copied unless a specific/allow has been paid or job order placed.	JOB NUMBER:
FLOOR HIGHT _____	DOOR HIGHT _____			BUILDER: GREENPARK
				SITE: RUSSELL GARDENS PH.4
				MODEL: SPRINGFIELD 1X EL 1,2,3
ST CNT _____	2X4 _____	VENT BOX COVER _____		LOT #:
			DESIGNER: LR	
			DATE: APR 28 21	


W WIDTH _____ W HEIGHT _____ W CWT _____
 FLOOR HEIGHT _____ DOOR HEIGHT _____
 ST CENT _____ 2X4 _____ VENT BOX COVER _____
 LOT # _____
 BUILDING: GREENPARK
 SITE: RUSSELL GARDENS PH.4
 MODEL: SPRINGFIELD 1X EL 1,2,3
 DESIGNER: LR
 DATE: APR 28 '81
 SELDA INDUSTRIES INC. and its an
 original design which must not be re-used
 without the written permission of Selda
 Inc. or its agent. No part of this drawing
 can be copied or used for any other
 project or job order placed.

FLOOR FRONT _____ DOOR RIGHT _____
 ST CENT _____ 2X4 _____ VENT BOX COVER _____
 DESIGNER: LR _____
 DATE: APR 28 21 _____
 LOT #: _____
 MODEL: SPRINGFIELD 1X EL 1,2,3 _____
 SHEL: ROSS/ELL GARDENING FIRM _____


ST CENT _____ 2X4 _____ VENT BOX COVER _____
DESIGNER: LR
DATE: APR 28 21
LOT #:
MODEL: SPRINGFIELD 1X EL 1,2,3

ST CENT _____ 2X4 _____ VENT BOX COVER _____
DESIGNER: LR
DATE: APR 28 21
LOT #:
MODEL: SPRINGFIELD 1X EL 1,2,3

SI CENT _____
2X4 _____
VENT BOX COVER _____
DATE: APR 28 21
LOI #: _____

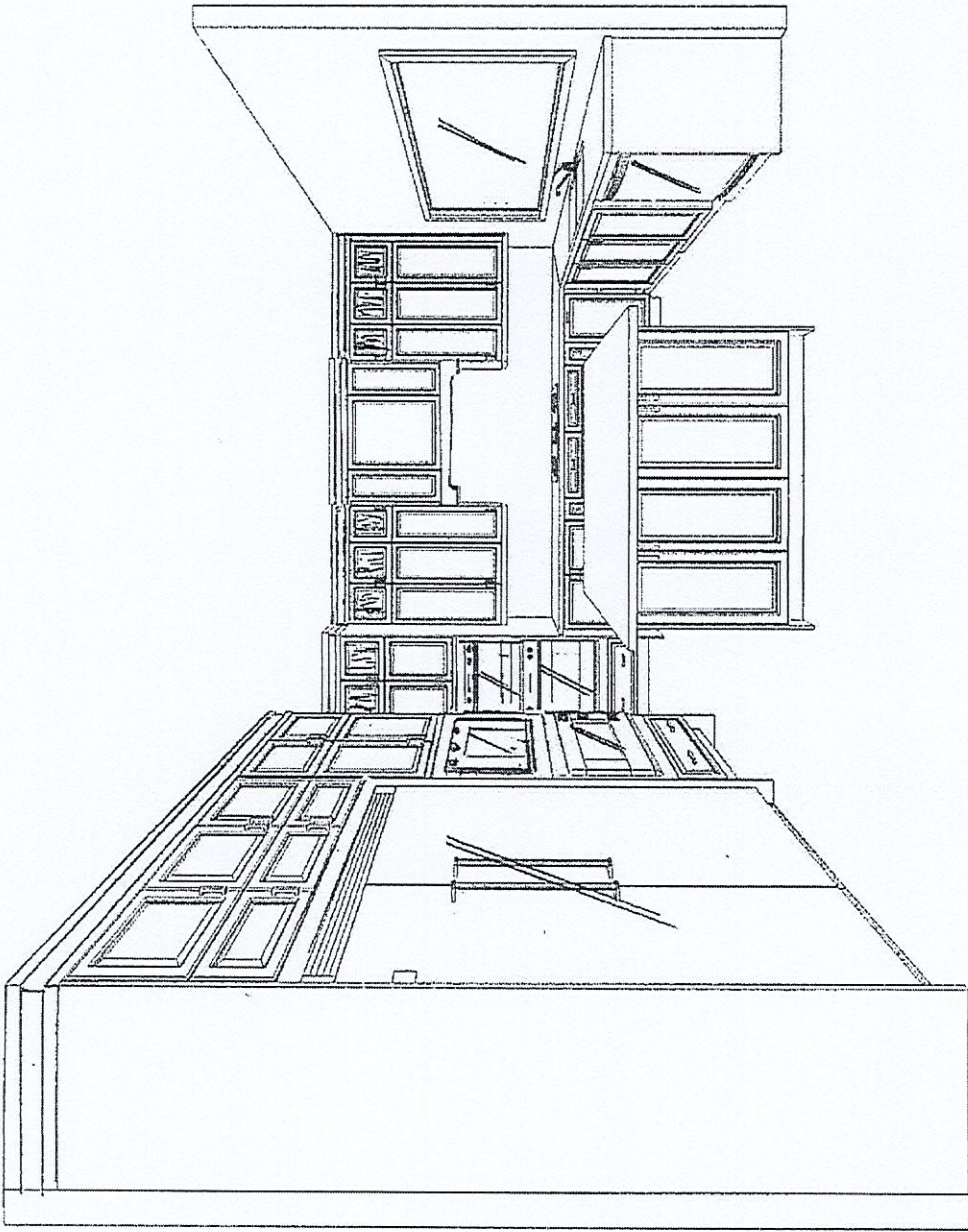

This drawing is the intellectual property of
SELBA INDUSTRIES INC. and is an
artistic
interpretation of the general
appearance of the design. It is
not meant to be an exact rendition.

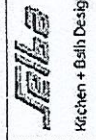


Designed: 4/27/2022
Printed: 5/4/2022

3-D VIEW

RUSSEL GARDENS LOT 487

LAYOUT

Drawing #: 1

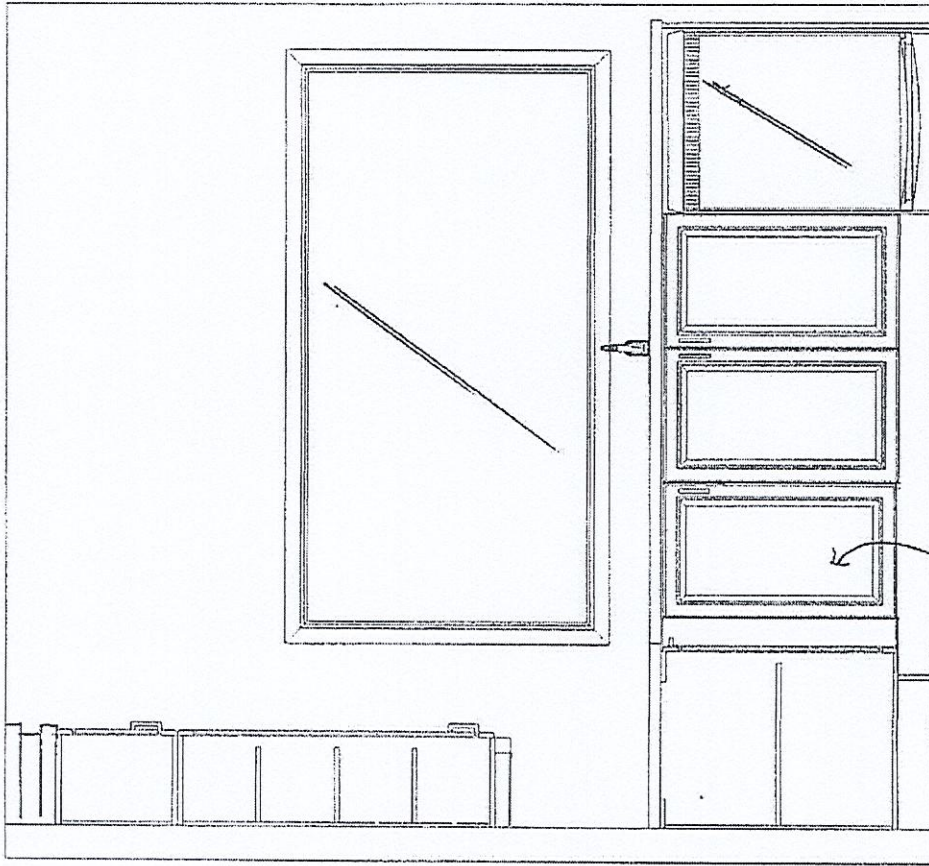

This drawing is the intellectual property of
SELBA INDUSTRIES INC. and is an
artistic
interpretation of the general
appearance of the design. It is
not meant to be an exact rendition.



Designed: 4/27/2022
Printed: 4/27/2022


SINK WALL

RUSSEL GARDENS LOT 487

LAYOUT


Drawing #: 1

GLC 340 CORD GLASS.

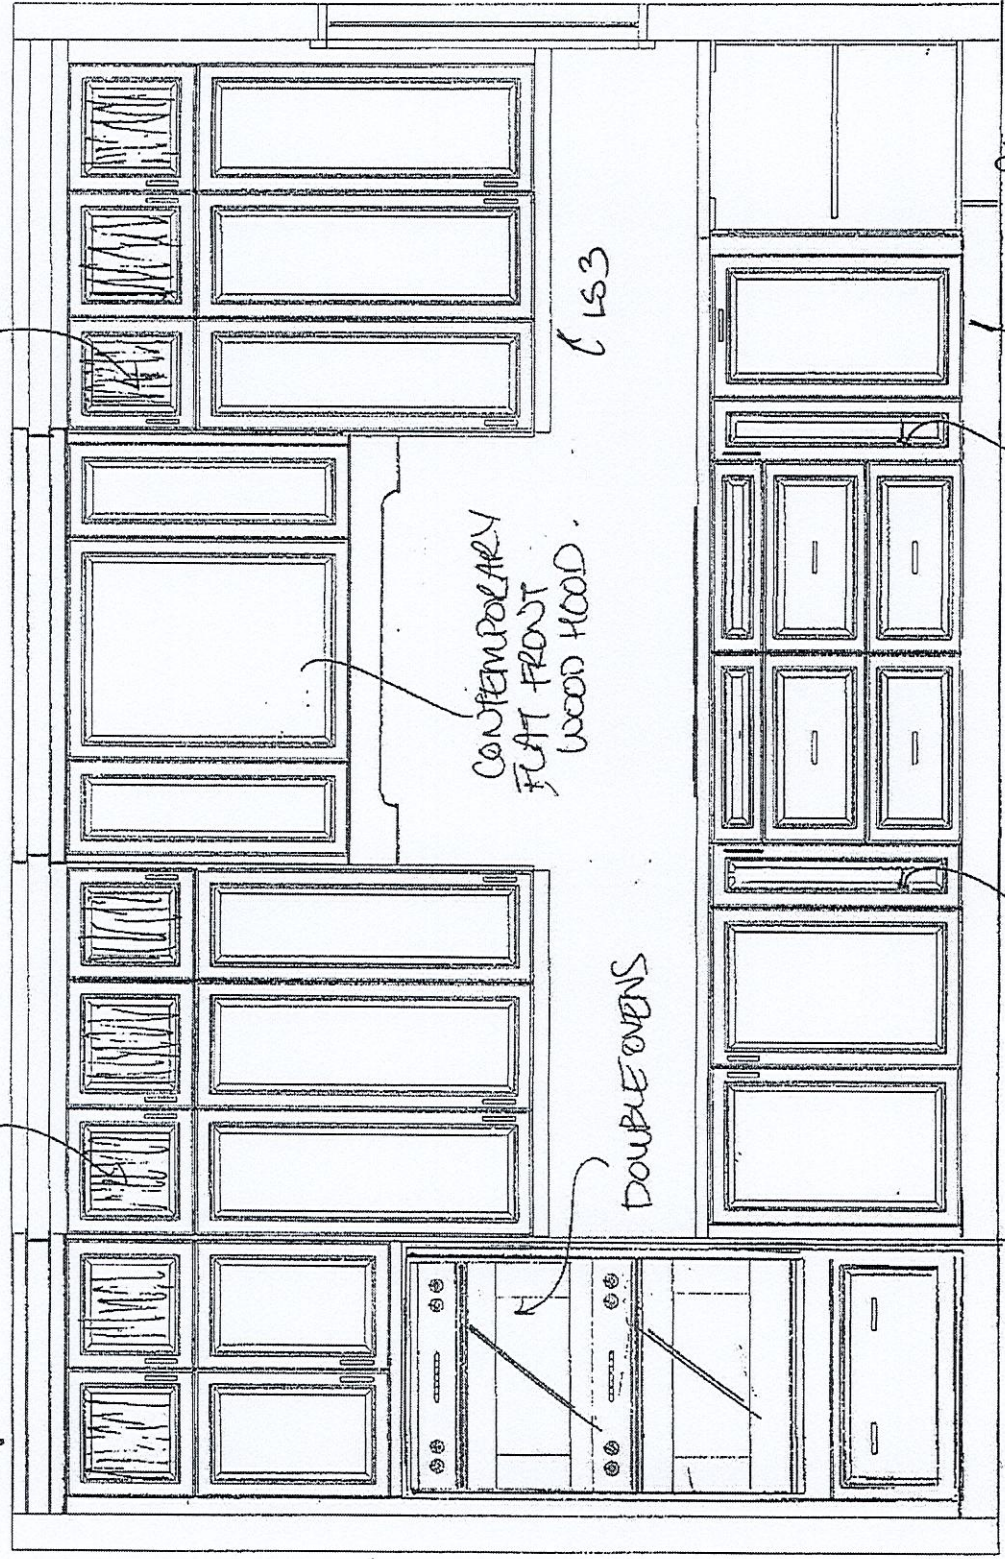


 Kitchen + Bath Designs	Designed: 4/27/2022 Printed: 5/4/2022
	STATE WASH
RUSSEL GARDENS LOT 487	
LAYOUT	Drawing #: 1

This drawing is the intellectual property of SELBA INDUSTRIES INC. and is an artistic interpretation of the general appearance of the design. It is not meant to be an exact rendition.

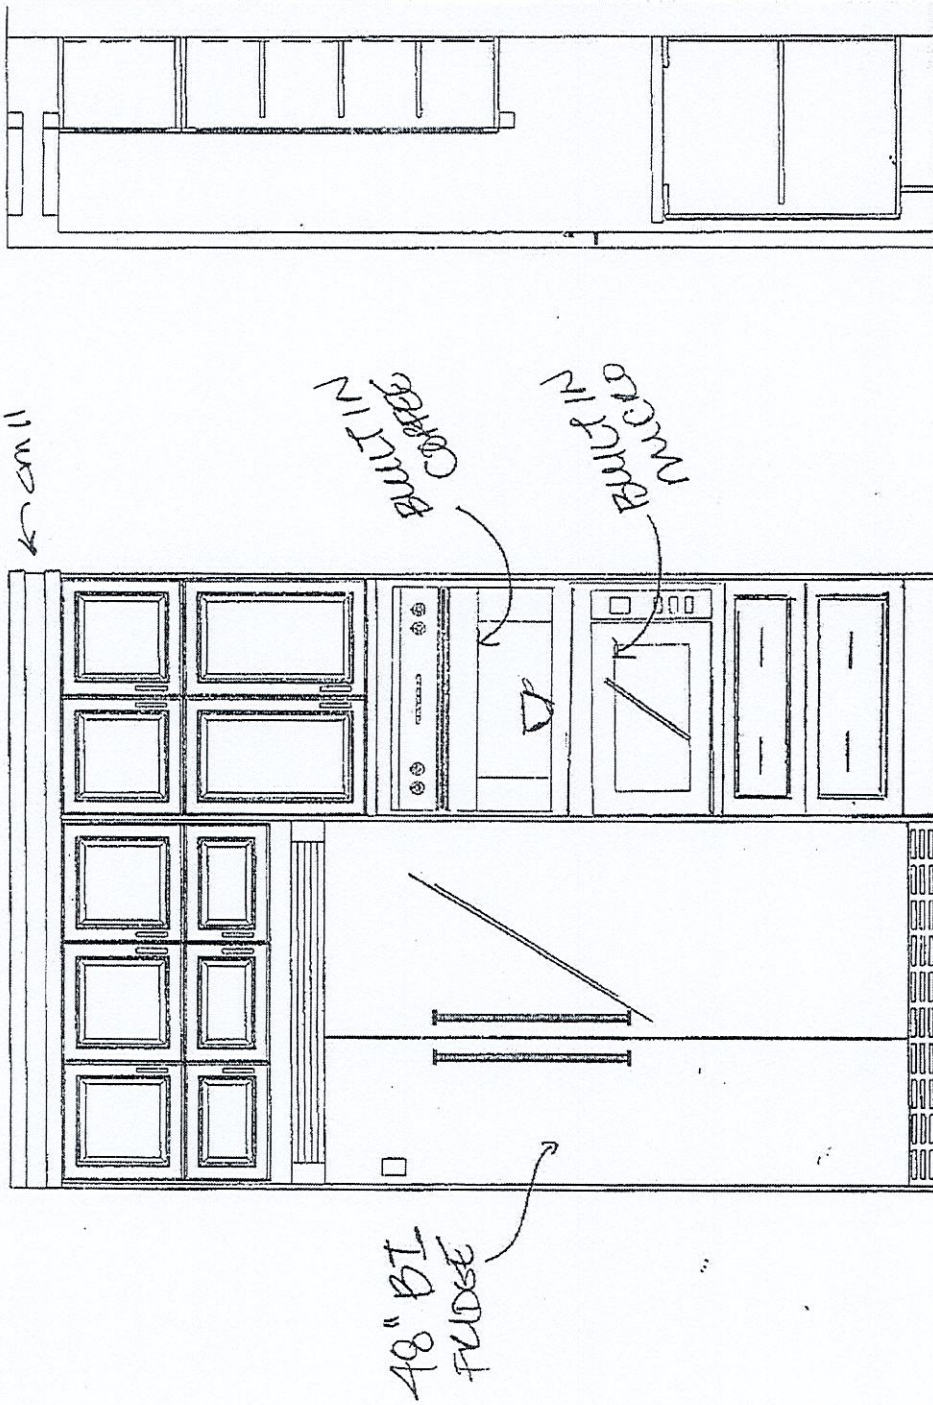


This drawing is the intellectual property of SELBA INDUSTRIES INC. and is an artistic interpretation of the general appearance of the design. It is not meant to be an exact rendition.	 Kitchen • Bath Designs	Designed: 4/27/2022 Printed: 4/27/2022
	FRIDGE WALL	
RUSSEL GARDENS LOT 487		LAYOUT Drawing #: 1

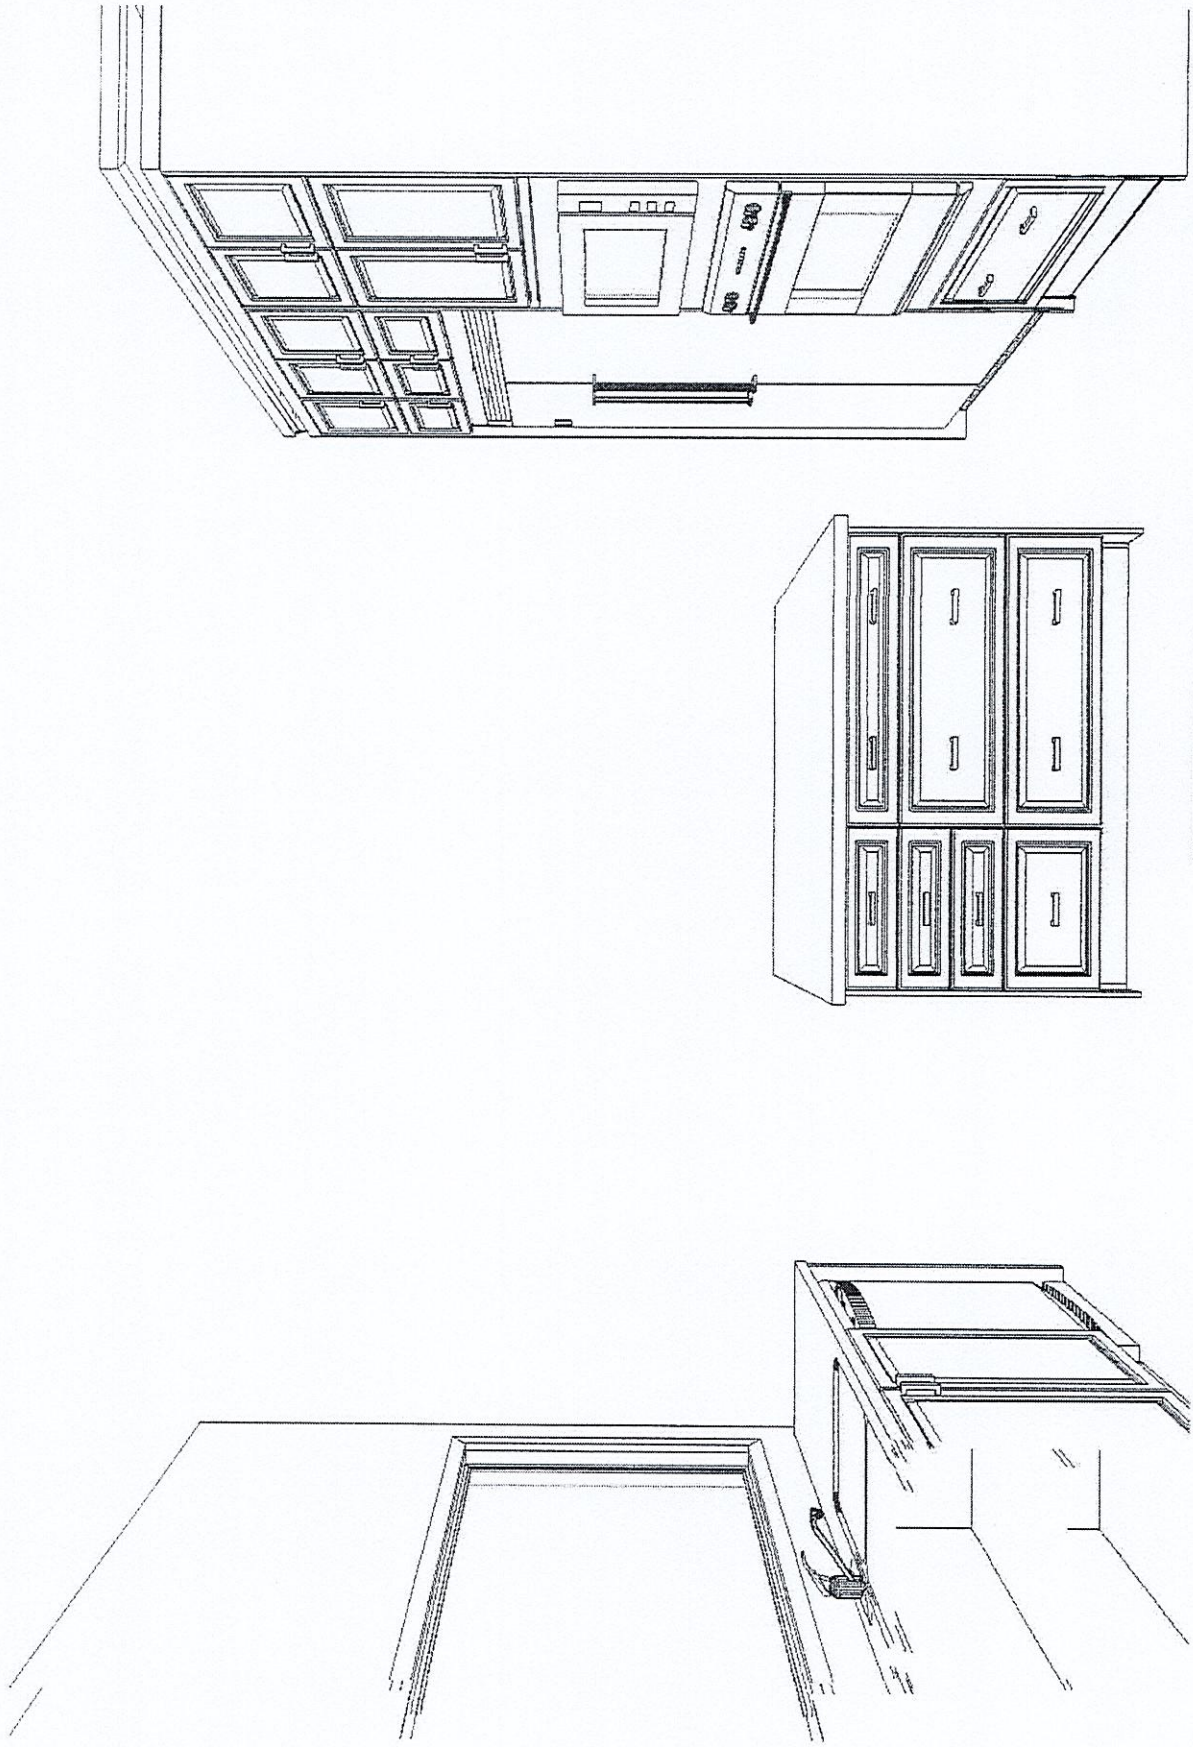

This drawing is the intellectual property of SELBA INDUSTRIES INC. and is an artistic interpretation of the general appearance of the design. It is not meant to be an exact rendition.		Designed: 5/6/2022 Printed: 5/6/2022
		INSIDE ISLAND VIEW
RUSSEL GARDENS 487		LAYOUT Drawing #: 1



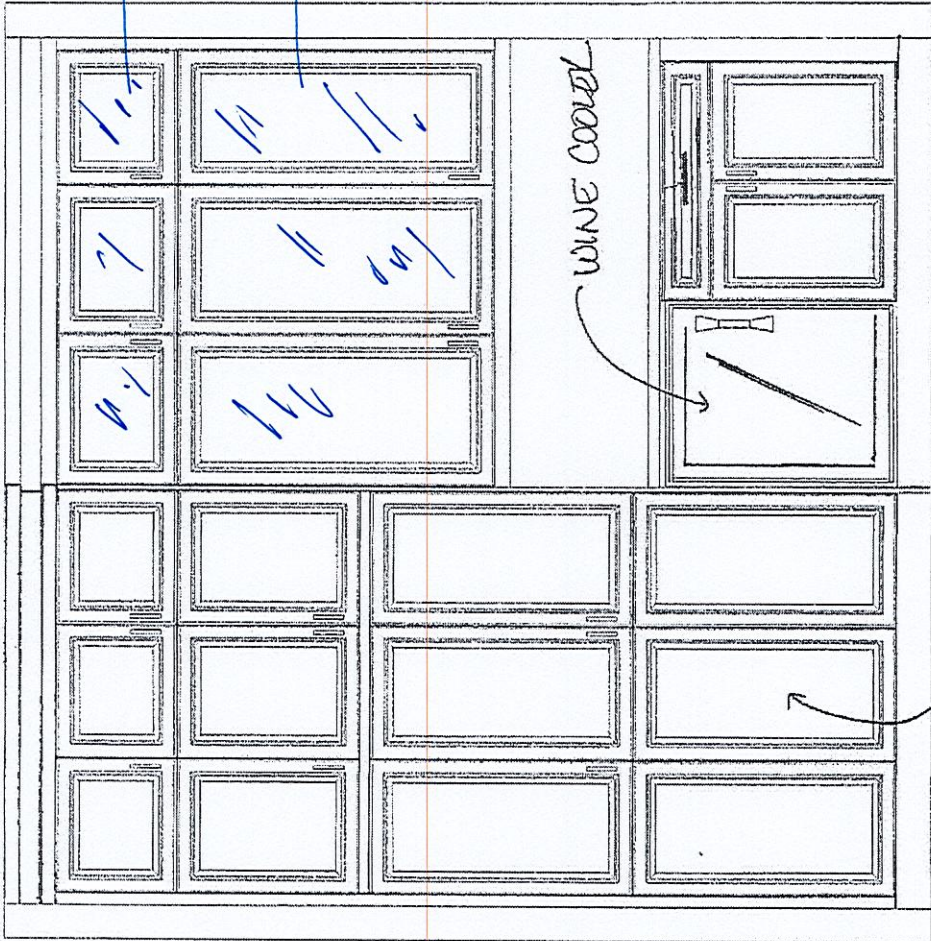

Clear Glass
on Mini Uppers
x3

Clear Glass
on 41" Uppers
x3

WINE COOLER

4 PULL OUTS

This drawing is the intellectual property of SELBA INDUSTRIES INC. and is an artistic interpretation of the general appearance of the design. It is not meant to be an exact rendition.	 Kitchen - Bath Designs	Designed: 4/27/2022
		Printed: 4/27/2022
RUSSEL GARDENS LOT 487 <u>SEALY</u>		LAYOUT
		Drawing #: 1