


THIS LOT GRADING PLAN HAS BEEN REVIEWED BY METROPOLITAN CONSULTING INC. FOR CONFORMANCE WITH THE APPROVED SUBDIVISION GRADING DESIGN. THE PROPOSED GRADES ON THIS PLAN ARE IN GENERAL CONFORMITY WITH THE APPROVED GRADING PLAN AS IT RELATES TO THIS LOT AND ADJACENT LOTS. WHERE THE BASEMENT FLOOR OR OTHER FOUNDATION ELEVATIONS ARE PROPOSED AT A DIFFERENT ELEVATION THAN THAT SHOWN ON THE APPROVED SUBDIVISION PLANS THE SEWER LATERALS HAVE BEEN REVIEWED AND WE ARE SATISFIED THAT THE MINIMUM GRADES FOR THESE LATERALS CAN BE MAINTAINED IN ACCORDANCE WITH THE REQUIREMENTS OF THE O.B.C. AND CITY DESIGN CRITERIA. NOTE, THIS CERTIFICATION DOES NOT REPLACE THE BUILDER'S RESPONSIBILITY TO EXPOSE THE SEWER LATERALS AND CONFIRM ELEVATIONS PRIOR TO EXCAVATING FOR THE FOUNDATION. BY USE OF THIS PLAN THE BUILDER AGREES THAT THEY SHALL BE RESPONSIBLE FOR IMMEDIATELY REPORTING TO METROPOLITAN CONSULTING ANY DISCREPANCY OR VARIATION BETWEEN THE LATERAL INFORMATION AND GRADES DEPICTED ON THIS PLAN AND THE CONDITIONS FOUND IN THE FIELD.

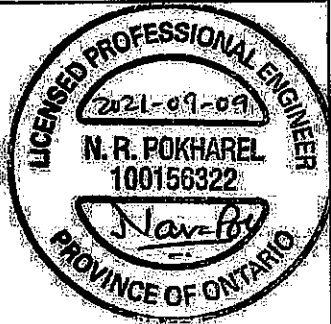

It is the builder's complete responsibility to ensure that all plans submitted for approval fully comply with the Architectural Guidelines and all applicable regulations and requirements including zoning provisions and any provisions in the subdivision agreement. The Control Architect is not responsible in any way for examining or approving site (lotting) plans or working drawings with respect to any zoning or building code or permit matter or that any house can be properly built or located on its lot.

This is to certify that these plans comply with the applicable Architectural Design Guidelines approved by the City of Hamilton.

JOHN G. WILLIAMS LTD., ARCHITECT
ARCHITECTURAL CONTROL REVIEW
AND APPROVAL

APPROVED BY:


DATE: SEP 10, 2021

This stamp certifies compliance with the applicable Design Guidelines only and bears no further professional responsibility.

CITY OF HAMILTON
BUILDING DIVISION
Planning & Development Department

NOV 16 2021

REC'D BY _____ DATE _____
REF'D TO _____ DATE _____

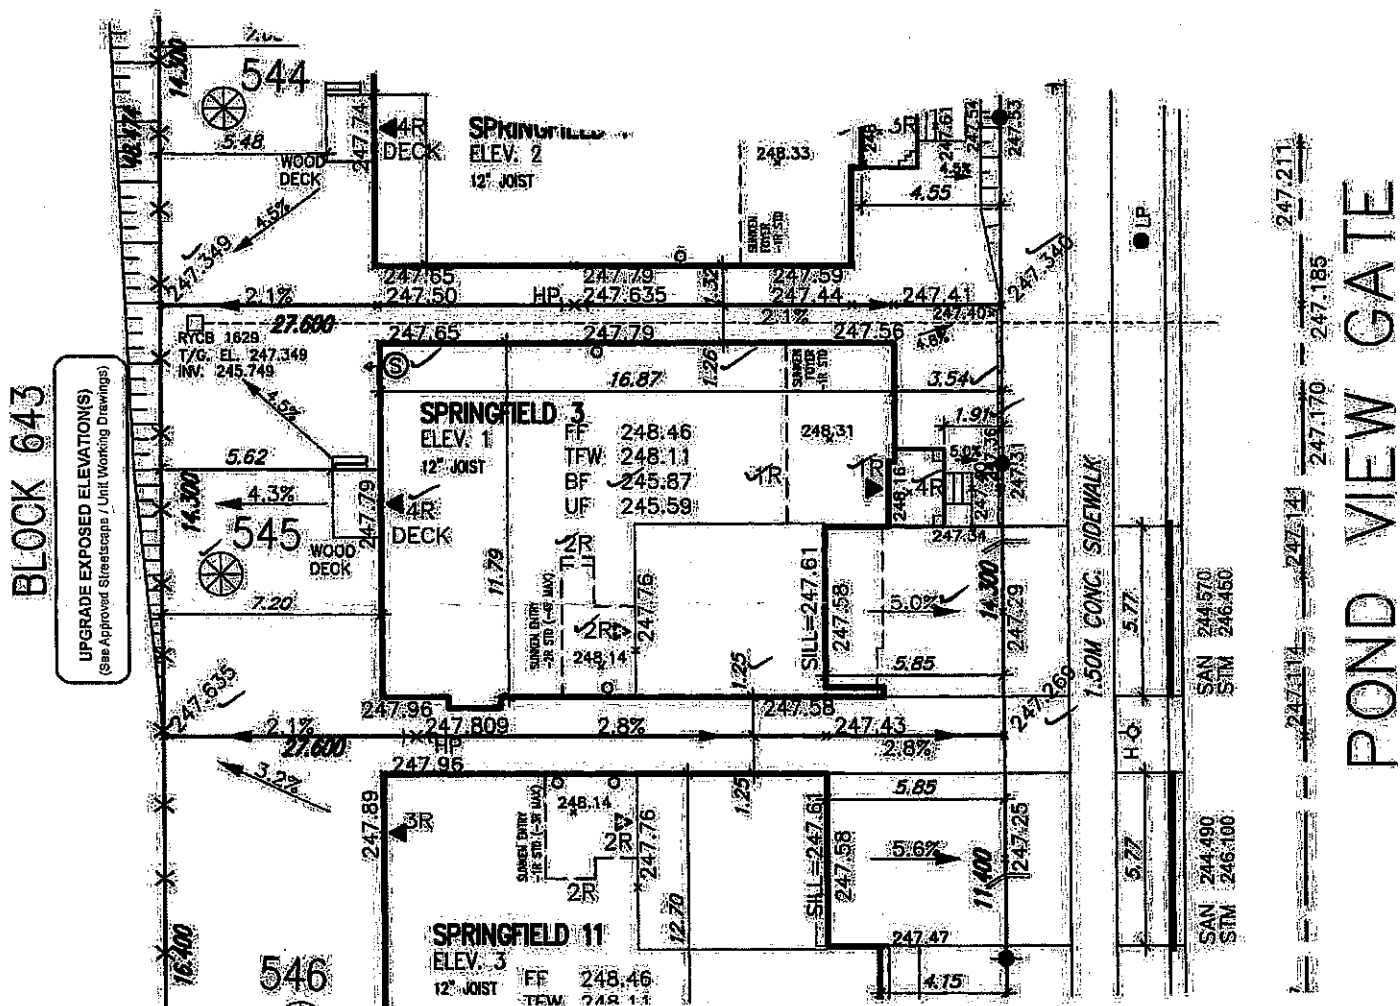

CITY OF HAMILTON
Building Division

Permit No. 21-161868

THESE STAMPED DRAWINGS SHALL BE AVAILABLE ON SITE

THE OWNER AND/OR CONTRACTOR SHALL COMPLY WITH
THE ONTARIO BUILDING CODE AND ALL OTHER APPLICABLE LAW

These drawings and/or specifications have been reviewed by

FOR CHIEF BUILDING OFFICIAL DATE 2/25/22

LOT 545		
LOT No.	LOT WIDTH (M) (@ 5.8m)	LOT AREA (M ²)
545	14.30	394.68

Grading Notes:

It shall be the responsibility of the builder to have all grades and services verified and checked before construction by an approved grading engineer. These grades and the placement of storm and sanitary services off the street are to meet the requirements of the municipality having jurisdiction.

VAS Design Inc. is to be notified promptly of any discrepancies at least 1 (one) week prior to excavation commences in order that the building can be re-sited. Failure to observe these conditions may require expensive remedial action that will not be the responsibility of or cost to VAS Design Inc. Foundation wall shall be poured to a minimum of 6" above approved grades.

Finished grade lines as indicated on the house prototype are for reference only and do not necessarily depict finish grading conditions of any particular lot.

These drawings are to be read in conjunction with municipal approved site engineering drawings prepared by Metropolitan Consulting Inc.

NOTE: REFER TO LANDSCAPE DRAWINGS FOR ALL FENCING TYPES, HEIGHTS AND LOCATIONS. CONTRACTOR TO VERIFY PRIOR TO INSTALLATION.

- PROPOSED VALVE
LIGHT POLE
WATER SERVICE
DOUBLE STW/SAN. CONNECTION
SINGLE STW/SAN. CONNECTION
CATCH BASIN
CABLE TELEVISION PEDESTAL
BELL PEDESTAL
- HYDRANT
TRANSFORMER
- NO. OF RISERS
FINISHED FLOOR ELEVATION
FINISHED MAIN LEVEL ELEVATION
UNDERSIDE FOOTING ELEVATION
FIN. BASEMENT FLOOR SLAB
TOP OF FOUNDATION WALL
UNDERSIDE FOOTING AT REAR
UNDERSIDE FOOTING AT FRONT
UNDERSIDE FOOTING AT SIDE
W.O.B. WALK OUT DECK
W.O.B. WALK OUT BASEMENT
REV. REVERSE PLAN
- STREET SIGN
MAIL BOX
RETAINING WALL
CHAIN LINK FENCE (SEE LANDSCAPE PLAN)
ACQUACULTURE FENCE (SEE LANDSCAPE PLAN)
WOOD SCREEN FENCE (SEE LANDSCAPE PLAN)
HYDRO SERVICE LATERAL
HYDRO METER
GAS METER
ENLIGHTENMENT (3/4" SLOPE unless otherwise noted)
- PROVIDE 3/4" DIA. CLEAR STONE IN THIS AREA
THIS LOT CONTAINS ENGINEERED FILL
AIR CONDITIONER REQUIRED
RAIN WATER DOWNSPOUT LOCATION (DISCHARGE ONTO SPLASHPAD)
SIDE WINDOW LOCATION
OPT. DOOR LOCATION
EXTERIOR DOOR LOCATION
REDUCE SIDE WIND

no.	description	date	by
1	ISSUED FOR PERMIT	AUG 27/21	GW
2			
3			
4			
5			
6			
7			
8			
9			

By the undersigned, I hereby certify that the drawings and specifications are true and correct and that the same are in accordance with the requirements of the City of Hamilton Building Code and all other applicable laws.

Signature:
Name: Richard Vink
Qualification: Professional Engineer
Registration No.: 24488
Firm: VAS Design Inc.
Firm Registration No.: 42658

Builder to verify location of all hydrants, street lights, transformers and other services. If minimum dimensions are not maintained, builder is to relocate at his own expense.
Builder to verify service connection elevations prior to constructing foundations. Developments NOT to be scaled 1/4".

VAS DESIGN
255 Consumers Rd. Suite 120
Toronto, ON M2J 1R4
416.630.2255 / 416.630.4782
vasdesign.com

Greenpark
Project name: RUSSELL GARDENS PHASE 4
City: HAMILTON
Date: JUL 2021
Drawn by: GW
Checked by: GW
Scale: 1:250
Project no.: 20027
Drawing no.: 1

LOT SITING/GRADING
20027-RG4-SITE-LAYOUTS
DATE: AUG 27, 2021
BY: GW