


THIS LOT GRADING PLAN HAS BEEN REVIEWED BY METROPOLITAN CONSULTING INC. FOR CONFORMANCE WITH THE APPROVED SUBDIVISION GRADING DESIGN. THE PROPOSED GRADES ON THIS PLAN ARE IN GENERAL CONFORMITY WITH THE APPROVED GRADING PLAN AS IT RELATES TO THIS LOT AND ADJACENT LOTS. WHERE THE BASEMENT FLOOR OR OTHER FOUNDATION ELEVATIONS ARE PROPOSED AT A DIFFERENT ELEVATION THAN THAT SHOWN ON THE APPROVED SUBDIVISION PLANS THE SEWER LATERALS HAVE BEEN REVIEWED AND WE ARE SATISFIED THAT THE MINIMUM GRADES FOR THESE LATERALS CAN BE MAINTAINED IN ACCORDANCE WITH THE REQUIREMENTS OF THE O.B.C. AND CITY DESIGN CRITERIA. NOTE, THIS CERTIFICATION DOES NOT REPLACE THE BUILDER'S RESPONSIBILITY TO EXPOSE THE SEWER LATERALS AND CONFIRM ELEVATIONS PRIOR TO EXCAVATING FOR THE FOUNDATION. BY USE OF THIS PLAN THE BUILDER AGREES THAT THEY SHALL BE RESPONSIBLE FOR IMMEDIATELY REPORTING TO METROPOLITAN CONSULTING ANY DISCREPANCY OR VARIATION BETWEEN THE LATERAL INFORMATION AND GRADES DEPICTED ON THIS PLAN AND THE CONDITIONS FOUND IN THE FIELD.

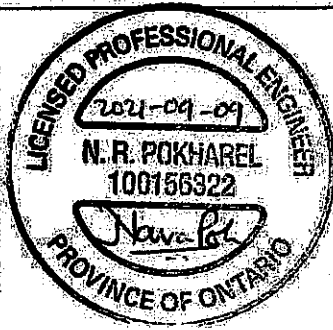

It is the builder's complete responsibility to ensure that all plans submitted for approval fully comply with the Architectural Guidelines and all applicable regulations and requirements including zoning provisions and any provisions in the subdivision agreement. The Control Architect is not responsible in any way for examining or approving site (lotting) plans or working drawings with respect to any zoning, building, code or permit matter or that any house can be properly built or located on its lot.


This is to certify that these plans comply with the applicable Architectural Design Guidelines approved by the City of Hamilton.

JOHN G. WILLIAMS LTD., ARCHITECT  
ARCHITECTURAL CONTROL REVIEW  
AND APPROVAL

APPROVED BY:

DATE: SEP 10, 2021

This stamp certifies compliance with the applicable Design Guidelines only and bears no further professional responsibility.

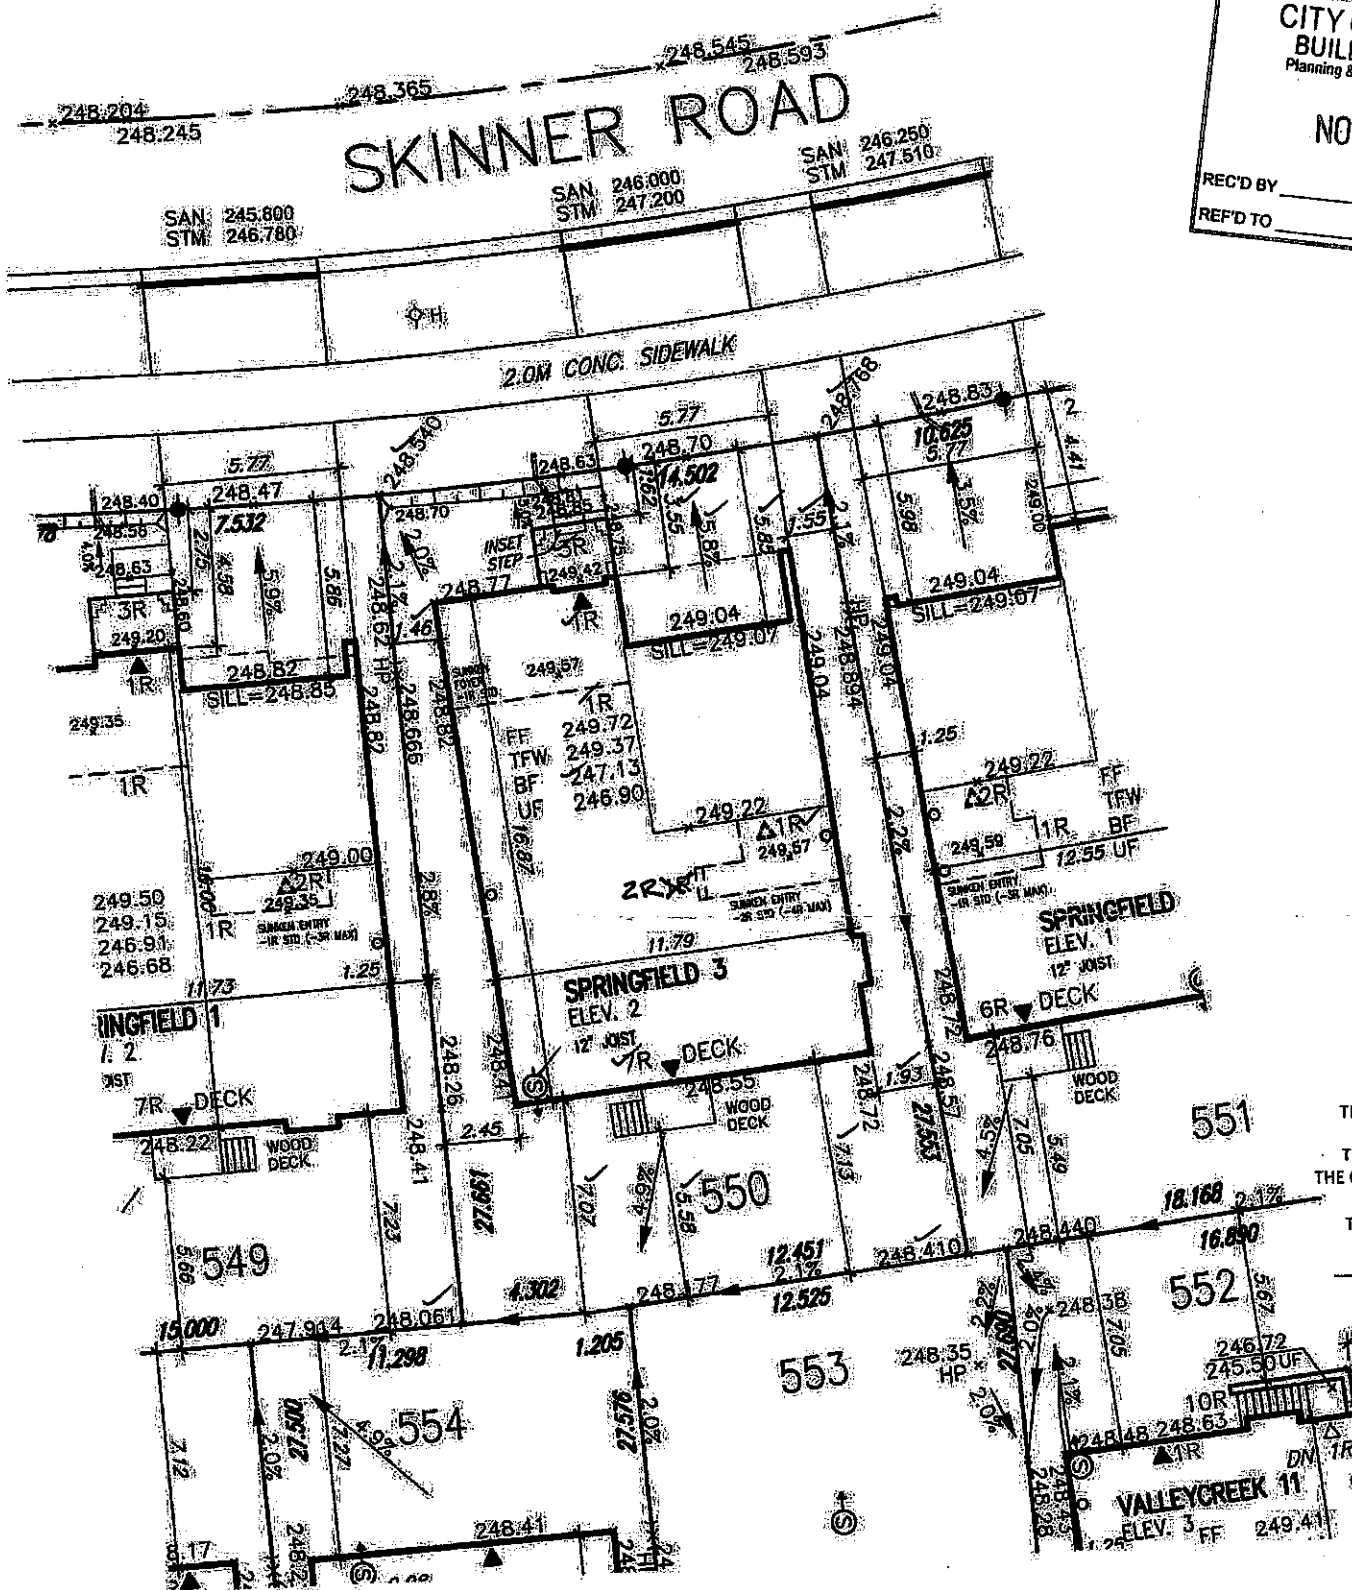

CITY OF HAMILTON  
Building Division

Permit No. 21-161866

THESE STAMPED DRAWINGS SHALL BE AVAILABLE ON SITE

THE OWNER AND/OR CONTRACTOR SHALL COMPLY WITH THE ONTARIO BUILDING CODE AND ALL OTHER APPLICABLE LAWS

These drawings and/or specifications have been reviewed by 3/02/22  
FOR CHIEF BUILDING OFFICIAL DATE

LOT 550		
LOT No.	LOT WIDTH (M) (± 0.3m)	LOT AREA (M²)
550	14.971	431.14

Grading Notes:

If shall be the responsibility of the builder to have all grades and services verified and checked before construction by an approved grading engineer. These grades and the placement of storm and sanitary services off the street are to meet the requirements of the municipality having jurisdiction.


VA3 Design Inc. is to be notified promptly of any discrepancies at least 1 (one) week prior to excavation commences in order that the building can be re-sited. Failure to observe these conditions may require expensive remedial action that will not be the responsibility of or cost to VA3 Design Inc. Foundation wall shall be poured to a minimum of 6" above approved grades.

Finished grade lines as indicated on the house prototype are for reference only and do not necessarily depict finish grading conditions of any particular lot.

These drawings are to be read in conjunction with municipal approved site engineering drawings prepared by Metropolitan Consulting Inc.

NOTE: REFER TO LANDSCAPE DRAWINGS FOR ALL FENCING TYPES, HEIGHTS AND LOCATIONS. CONTRACTOR TO VERIFY PRIOR TO INSTALLATION.

PROPOSED VALVE	WATER SERVICE	DOUBLE STW/SAN CONNECTION	SINGLE STW/SAN CONNECTION	CATCH BASIN	CABLE TELEVISION/PEDESTAL BELL PEDESTAL	HYDRANT	TRANSFORMER	NO. OF RISERS	FINISHED FLOOR ELEVATION	FINISHED MAIN LEVEL ELEVATION	UNDERSIDE FOOTING ELEVATION	FIN. BASEMENT FLOOR SLAB	TOP OF FOUNDATION WALL	UNDERSIDE FOOTING AT REAR	UNDERSIDE FOOTING AT FRONT	UNDERSIDE FOOTING AT SIDE	WALK-OUT DECK	WALK-OUT BASEMENT	REVERSE PLAN	STREET SIGN	MAIL BOX	RETAINING WALL	CHAIN LINK FENCE (SEE LANDSCAPE PLAN)	ACoustical FENCE (SEE LANDSCAPE PLAN)	WOOD SCREEN FENCE (SEE LANDSCAPE PLAN)	HYDRO SERVICE LATERAL	HYDRO METER	GAS METER	FOUNDATION (1:1 SLOPE unless otherwise noted)	PROVIDE 3/4" DIA. CLEAR STONE IN THIS AREA	THIS LOT CONTAINS ENGINEERED PILE	AIR CONDITIONER REQUIRED	RAN WATER DOWNSPOUT LOCATION (DISCHARGE ONTO SPLASHPAD)	SIDE WINDOW LOCATION	OPT. DOOR LOCATION	EXTERIOR DOOR LOCATION	REDUCE SIDE YARD
----------------	---------------	---------------------------	---------------------------	-------------	-----------------------------------------	---------	-------------	---------------	--------------------------	-------------------------------	-----------------------------	--------------------------	------------------------	---------------------------	----------------------------	---------------------------	---------------	-------------------	--------------	-------------	----------	----------------	---------------------------------------	---------------------------------------	----------------------------------------	-----------------------	-------------	-----------	-----------------------------------------------	--------------------------------------------	-----------------------------------	--------------------------	---------------------------------------------------------	----------------------	--------------------	------------------------	------------------

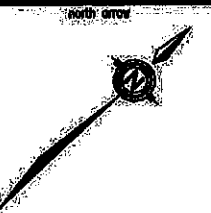

ISSUED FOR PERMIT: AUG 27/21

no. description

VA3 DESIGN

255 Consumers Rd Suite 120  
Toronto, ON M2J 1R4  
1-416-830-2255 1-416-830-4782  
va3design.com

Greenpark

RUSSELL GARDENS PHASE 4

HAMILTON

LOT SITING/GRADING

20027-RG4-SITE-LAYOUTS

1

550

registered plan no. 62M-1266

project no. 20027

drawing no. 1