

| CONSTRUCTION SUMMARY | | | | |
|--|-------------------------|--|-------------------------|--|
| Mountainview Heights 3 (G) - Russell Gardens Building Ltd. | | | | |
| PURCHASERS: Natasha Reddy VENKATAPURAM and Srinivas Reddy VENKATAPURAM | | | TEL: RES.: 416-400-4914 | |
| LOT / PHASE 570 / 4 | REG. PLAN # 62M-1266 | HOUSE TYPE Springfield Eleven (4 Bed with Guest Suite) Elev 3 | | |

CABINETRY ACCESSORIES

| | |
|--|--|
| 1 - VANITY CABINETRY - RAISE VANITY TO 36" HIGH VANITY IN LIEU OF STANDARD HEIGHT MASTER ENSUITE 03Jun22 Note: | |
| 1 - VANITY CABINETRY - RAISE VANITY TO 36" HIGH VANITY IN LIEU OF STANDARD HEIGHT ENSUITE #4 / FLEX 03Jun22 Note: | |
| 1 - VANITY CABINETRY - RAISE VANITY TO 36" HIGH VANITY IN LIEU OF STANDARD HEIGHT ENSUITE BATH 2/3 03Jun22 Note: | |
| 1 - VANITY CABINETRY - RAISE VANITY TO 36" HIGH VANITY IN LIEU OF STANDARD HEIGHT POWDER RM 03Jun22 Note: | |
| 1 - VANITY CABINETRY - RAISE VANITY TO 36" HIGH VANITY IN LIEU OF STANDARD HEIGHT GUEST SUITE 03Jun22 Note: | |
| 1 - KITCHEN CABINETRY BASE - PIE CUT CORNER CABINET - BASE CABINETRY - STANDARD 03Jun22 Note: | |
| 1 - KITCHEN CABINETRY BASE - PULLOUT WIRE SPICE RACK - PRICE IS EACH 03Jun22 Note: INSTALL ON LEFT SIDE OF STOVE ***SEE SKETCH | |

CERAMIC TILE

| | |
|---|--|
| 1 - GROUT COLOUR - UPGRADE GROUT COLOUR THROUGHOUT - FLAT FEE 03Jun22 Note: | |
| 1 - DELETE ALL CERAMIC BATHROOM ACCESSORIES - DELETE TOWEL BAR, PAPER HOLDER & SOAP DISH THROUGHOUT 03Jun22 Note: | |
| 1 - TILE - UPGRADE 2 FLOOR TILE - - ENSUITE BATHROOM - FLOOR 03Jun22 Note: | |
| 1 - TILE - UPGRADE 4 FLOOR TILE - - KITCHEN 03Jun22 Note: | |
| 1 - TILE - UPGRADE 1 FLOOR TILE - - OPTIONAL ENSUITE - FLOOR AREA 03Jun22 Note: GUEST ENSUITE | |

ELECTICAL

| | |
|---|--|
| 1 - PLUG – ROUGH-IN FOR ELECTRIC CAR PLUG IN GARAGE – FOR FUTURE ELECTRIC CAR – 240V / 40-50 AMPS 03Jun22 Note: SPECIFICATIONS REQUIRED | |
|---|--|

ELECTRICAL

| | |
|---|--|
| 4 - FAN - BATHROOM EXHAUST FAN - ENERGY STAR 80 CFM - IN LIEU OF STANDARD FAN GUEST SUITE MASTER ENSUITE ENSUITE 2/3 ENSUITE 4/FLEX 03Jun22 Note: | |
| 1 - INSTALL LIGHT CENTERED IN THE LIVING ROOM/ DINING ROOM- CONSTRUCTION PERMITTING ** SEE SKETCH 03Jun22 Note: | |

CONSTRUCTION SUMMARY

Mountainview Heights 3 (G) - Russell Gardens Building Ltd.

PURCHASERS: Natasha Reddy VENKATAPURAM and Srinivas Reddy VENKATAPURAM

TEL: RES.: 416-400-4914

| LOT / PHASE | REG. PLAN # | HOUSE TYPE | | |
|---|-------------|--|--|--|
| 570 / 4 | 62M-1266 | Springfield Eleven (4 Bed with Guest Suite) Elev 3 | | |
| 1 - RELOCATE STANDARD KITCHEN LIGHT TO BE CENTERED OVER ISLAND 03Jun22 Note: | | | | |
| 1 - PLUG - ELECTRICAL PLUG ** IN FAMILY ROOM - APPRIMATELY 5FT HIGH AND CENTERED ON WALL -IF CONSTRUCTION PERMITS **SEE SKETCH FOR LOCATION 03Jun22 Note: | | | | |
| 1 - PLUG - ELECTRICAL PLUG - TO BE INSTALLED OVER FIREPLACE **FAMILY ROOM - SEE SKETCH 03Jun22 Note: | | | | |
| 8 - POT LIGHT - EXTERIOR - SOFFIT MOUNT - REGULAR VOLTAGE 29Jul21 Note: | | | | |
| 12 - POT LIGHT - LED - FIRST FLOOR INSTALLATION 29Jul21 Note: SEE SKETCH FOR LOCATIONS | | | | |
| 1 - PLUG - ELECTRICAL PLUG WITH GFI AND SWITCH - FOR FESTIVE LIGHTING 29Jul21 Note: SEE SKETCH | | | | |
| 1 - 200 AMP ELECTRICAL SERVICE 29Jul21 Note: | | | | |

FIREPLACE AND ACCESSORIES

| | |
|---|--|
| 1 - GAS LINE ROUGH-IN FOR STOVE (INCLUDES ELECTRICAL OUTLET) - FIRST FLOOR 03Jun22 Note: | |
| 1 - GAS LINE ROUGH-IN FOR BARBECUE - FIRST FLOOR **SEE SKETCH FOR LOCATION - CONSTRUCTION PERMITTING 03Jun22 Note: | |

HARDWOOD FLOORING

| | |
|---|--|
| 1 - HARDWOOD - GROUP A SERIES 3 1/4 INCH - IN LIEU OF 2 1/4 INCH NATURAL RED OAK - - MAIN HALL 03Jun22 Note: | |
| 1 - HARDWOOD - GROUP A SERIES 3 1/4 INCH - IN LIEU OF 2 1/4 INCH NATURAL RED OAK - - LIVING AND DINING ROOM 03Jun22 Note: | |
| 1 - HARDWOOD - GROUP A SERIES 3 1/4 INCH - IN LIEU OF 2 1/4 INCH NATURAL RED OAK - - GUEST SUITE 03Jun22 Note: | |
| 1 - HARDWOOD - GROUP A SERIES 3 1/4 INCH - IN LIEU OF 2 1/4 INCH NATURAL RED OAK - - FAMILY ROOM 03Jun22 Note: | |

HEATING AND AIR CONDITIONING

| | |
|--|--|
| 1 - HUMIDIFIER-GENERAL AIRE 1099 OR EQUIVALENT 03Jun22 Note: | |
|--|--|

MIRRORS AND GLASS

| | |
|---|--|
| 2 - UPGRADE TO TOWEL BAR/HANDLE COMBO (IN LIEU OF KNOB) - CHROME FINISH GUEST SUITE MASTER ENSUITE 03Jun22 Note: | |
| 1 - MASTER ENSUITE - FRAMELESS GLASS SHOWER DOOR - INCLUDES CHROME KNOB & HINGES 29Jul21 Note: UPGRADED TO TOWEL BAR /HANDLE COMBO - CHROME - SEE INVOICE DATED JUNE 3/22. | |

CONSTRUCTION SUMMARY

Mountainview Heights 3 (G) - Russell Gardens Building Ltd.

PURCHASERS: Natasha Reddy VENKATAPURAM and Srinivas Reddy VENKATAPURAM

TEL: RES.: 416-400-4914

| | | | | |
|-------------|-------------|--|--|--|
| LOT / PHASE | REG. PLAN # | HOUSE TYPE | | |
| 570 / 4 | 62M-1266 | Springfield Eleven (4 Bed with Guest Suite) Elev 3 | | |

1 - GUEST BATH -FRAMELESS GLASS SHOWER ENCLOSURE FOR 5 FOOT SHOWER – INCLUDES CHROME KNOB & HINGES

29.Jul21 Note:

UPGRADED TO TOWEL BAR /HANDLE COMBO - CHROME - SEE INVOICE DATED JUNE 3/22.

PLUMBING

1 - SOAP DISPENSER - CHROME FINISH # S3946

** RIGHT SIDE OF SINK IF CONSTRUCTION PERMITS

03.Jun22 Note:

1 - NOTE: ***5 FOOT SHOWER WITH SLIDING GLASS CHROME DOORS IN LIEU OF TUB

02.Jun22 Note:

GUEST ENSUITE (UPGRADED TO FRAMELESS GLASS - INVOICE JUNE 3/22)

1 - WATER LINE FOR FRIDGE - ROUGH-IN ONLY

29.Jul21 Note:

3 - TOE TESTER - ADD TOE TESTER TO SHOWER

29.Jul21 Note:

PROMOTIONAL

1 - LESS CREDIT FROM PURCHASER EXTRA IN OFFER

POWDER ROOM

GUEST SUITE

MASTER ENSUITE

ENSUITE 2/3

ENSUITE 4/FLEX

03.Jun22 Note:

LESS CREDIT FROM PURCHASER EXTRA IN OFFER

STAIRS AND RAILINGS

1 - STAINED STAIRS – STANDARD STAIRCASE - PRICE IS PER SET

03.Jun22 Note:

EXTRAS AS PER OFFER

PURCHASER(S) ACKNOWLEDGES THAT THE PURCHASE PRICE IS INCLUSIVE OF ALL CREDITS AND PROMOTIONAL PACKAGES AVAILABLE AT TIME OF PURCHASE.

Worksheet Note:

Granite kitchen counter top, from Vendor?s standard samples

Worksheet Note:

(1) The Vendor agrees that notwithstanding any other term or provision in this Agreement included in the Purchase Price and in addition to those items detailed in Schedule GP to the Agreement of Purchase and Sale, the Purchaser is entitled to a credit of

Worksheet Note:

Purchase Price includes 3 enlarged basement windows, and the obligation to construct the house with the enlarged basement windows is subject to the Vendors approval, in its sole and unfettered discretion The Purchaser acknowledges and agrees that the loc

Worksheet Note:

Purchase Price includes a walk up from the basement to the rear of the dwelling unit, and the obligation to construct the house with the walk up is subject to the Vendor?s approval, in its sole and unfettered discretion. The Purchaser acknowledges and ag

Worksheet Note:

This Document is Extremely Time Sensitive - Printed 8 Jun 22 at 12:51

Purchasers: Natasha Reddy VENKATAPURAM & Srinivas Reddy

Property: 570

Telephone Res. / Bus: (416) 400-4914 /

Project: Russell Gardens Building Ltd.

Decor Advisor: Giulia Di Girolamo

Model and Elevation: Springfield Eleven (4 Bed with Guest Suite)

Lock Date: 3-Jun-22

3-Jun-22

Plan #: 62M-1266

Layout Changes: ☐ Yes ☒ No

Sketch Attached: ☒ Yes ☐ No

Exterior Colour Scheme:

1. Cabinetry

| | Style and Colour | Hardware |
|----------------------------|---------------------------------|----------|
| Kitchen / Breakfast | CONTINENTAL 350 PLATINUM SILVER | 468SA |
| Laundry Room | ELISSE | Standard |
| Powder Room | MONACO 820 MILK CHOCOLATE | 464SA |
| Master Ensuite Bathroom | DORAL WHITE W500 | 466SA |
| Ensuite Bath - Bedroom 2/3 | MONACO 350 PLATINUM SILVER | 466SA |
| Ensuite Bath - 4/ Flex | MONACO 350 PLATINUM SILVER | 466SA |
| Guest Ensuite | DORAL K44 TITAN | 464SA |
| | | |
| | | |

Appliances:

Built In Appliances ☐ Yes ☒ No

Slide In Stove ☐ Yes ☒ No

Dishwasher Cabinet

☐ Closed ☒ Open

41" Upper Cabinets ☒ Yes ☐ No

Please NOTE: Standard Cabinet Height is 30"

Stove Opening

STANDARD 30"

NOTE: If not specified, opening will be set to builder's standard opening of approximately 30" width

Fridge Opening

VENDOR STANDARD

NOTE: If not specified, opening will be set to builder's standard opening of approximately 37" width x 74" height

** Refer to Construction Summary

2. Counters

| | Counter | Edge |
|----------------------------|-------------------------------------|-----------|
| Kitchen / Breakfast | GRANITE-ROSA BETA | #360 EDGE |
| Laundry Room | | |
| Powder Room | LAMINATE-PORTICO MARBLE 7735-58 | |
| Master Ensuite Bathroom | LAMINATE-ELEMENTAL CONCRETE 8830-58 | |
| Ensuite Bath - Bedroom 2/3 | LAMINATE-PALOMA POLAR 6698-46 | |
| Ensuite Bath - 4/ Flex | LAMINATE-PALOMA POLAR 6698-46 | |
| Guest Ensuite | LAMINATE-PORTICO MARBLE 7735-58 | |
| | | |
| | | |

** Refer to Construction Summary

Purchasers:

Telephone Res. / Bus:

Decor Advisor:

Lock Date:

Natasha Reddy VENKATAPURAM & Srinivas Reddy
(416) 400-4914 /
Giulia Di Girolamo
3-Jun-22

Property: 570

Project: Russell Gardens Building Ltd.

Model and Elevation: Springfield Eleven (4 Bed with Guest Suite)

Plan #: 62M-1266

3. Ceramic Flooring

At a 45° Threshold-If App.

| | | | |
|----------------------------|---------------------------------|--------------------------|---------------------|
| Entrance Vestibule | TILE-BEACH IVORY 13X13 | <input type="checkbox"/> | #50 TITANIUM GROUT- |
| Main Hall | N/A | <input type="checkbox"/> | N/A |
| Kitchen / Breakfast | TILE-LITUM PEARL POLISHED 24X24 | <input type="checkbox"/> | #50 TITANIUM GROUT- |
| Laundry Room | TILE-BEACH IVORY 13X13 | <input type="checkbox"/> | #50 TITANIUM GROUT- |
| Powder Room | TILE-BEACH IVORY 13X13 | <input type="checkbox"/> | #50 TITANIUM GROUT- |
| Master Ensuite Bathroom | TILE-LIFE FOG 12X24 | <input type="checkbox"/> | #50 TITANIUM GROUT- |
| Ensuite Bath - Bedroom 2/3 | TILE-PLAYA BLACK 12X12 | <input type="checkbox"/> | #50 TITANIUM GROUT- |
| Ensuite Bath - 4/ Flex | TILE-PLAYA BLACK 12X12 | <input type="checkbox"/> | #50 TITANIUM GROUT- |
| Guest Ensuite | TILE-AXIS BIANCO (WHITE)12X24 | <input type="checkbox"/> | #50 TITANIUM GROUT- |
| Mud Room | TILE-BEACH IVORY 13X13 | <input type="checkbox"/> | #50 TITANIUM GROUT- |
| | | <input type="checkbox"/> | |

** Refer to Construction Summary -- #50 TITANIUM GROUT THROUGHOUT.

4. Ceramic Wall Tile

| Master Ensuite Bathroom | Selection | Describe |
|----------------------------|-----------------------------|----------|
| Tub Deck Wall | N/A | |
| Tub Deck | N/A | |
| Tub Deck Skirt | N/A | |
| Shower Stall | TILE- AFRICA LUCIDO 8X16 | |
| Bathtub Enclosure Walls | N/A | |
| Ensuite Bath - Bedroom 2/3 | TILE-LUC. CONCEPT NEVE 8X16 | |
| Ensuite Bath - 4/ Flex | TILE-LUC. CONCEPT NEVE 8X16 | |
| Guest Ensuite | TILE-LUC. CONCEPT NEVE 8X16 | |
| Mud Room | N/A | |
| | | |
| Kitchen Backsplash | | |

** Refer to Construction Summary -- #50 TITANIUM GROUT THROUGHOUT.

5. Plumbing Fixtures

All Bathrooms

White

N/A

N/A

Whirlpool

☐ Yes ☒ No

Dishwasher Rough-In

☒ Yes ☐ No

Waterline for Fridge

☒ Yes ☐ No

** Refer to Construction Summary

6. Trim Carpentry

| | |
|----------------------------|------------------------------------|
| Interior Doors | As Per Construction Specifications |
| Interior Trim | As Per Construction Specifications |
| Door Handles | As Per Construction Specifications |
| Exterior Front Door Handle | As Per Construction Specifications |

** Refer to Construction Summary

Purchasers:

Telephone Res. / Bus:

Decor Advisor:

Lock Date:

Natasha Reddy VENKATAPURAM & Srinivas Reddy

(416) 400-4914 /

Giulia Di Girolamo

3-Jun-22

Property: 570

Project: Russell Gardens Building Ltd.

Model and Elevation: Springfield Eleven (4 Bed with Guest Suite)

Plan #: 62M-1266

7. Other Flooring

| | |
|------------------------------|--|
| Main Hall | MIRAGE-ADMIRATION COLLECTION - 3 1/4" RIO RED OAK SEMI-GLOSS |
| Living Room | MIRAGE-ADMIRATION COLLECTION - 3 1/4" RIO RED OAK SEMI-GLOSS |
| Dining Room | MIRAGE-ADMIRATION COLLECTION - 3 1/4" RIO RED OAK SEMI-GLOSS |
| Family Room | MIRAGE-ADMIRATION COLLECTION - 3 1/4" RIO RED OAK SEMI-GLOSS |
| Den / Library / Study | N/A |
| Basement Landing(If Applies) | N/A |
| Lower Landing (If Applies) | N/A |
| Upper Landing | MIRAGE-ADMIRATION COLLECTION - 3 1/4" RIO RED OAK SEMI-GLOSS |
| Upper Hall | LAMINATE-LEXINGTON-BRUSSELS OAK-TL-LW1316 |
| Master Bedroom | LAMINATE-LEXINGTON-BRUSSELS OAK-TL-LW1316 |
| Bedroom #2 | LAMINATE-LEXINGTON-BRUSSELS OAK-TL-LW1316 |
| Bedroom #3 | LAMINATE-LEXINGTON-BRUSSELS OAK-TL-LW1316 |
| Bedroom #4 | LAMINATE-LEXINGTON-BRUSSELS OAK-TL-LW1316 |
| Bedroom #5 | N/A |
| FLEX SPACE | LAMINATE-LEXINGTON-BRUSSELS OAK-TL-LW1316 |
| GUEST SUITE | MIRAGE-ADMIRATION COLLECTION - 3 1/4" RIO RED OAK SEMI-GLOSS |

Underpad

Type

Area

N/A

N/A

** Refer to Construction Summary

8. Railings and Pickets

| | | | |
|------------------|------------------------------------|----------------------|-----|
| Railing Type | AS PER CONSTRUCTION SPECIFICATIONS | Complimenting Colour | RIO |
| Picket Type | AS PER CONSTRUCTION SPECIFICATIONS | Complimenting Colour | RIO |
| Stringer / Riser | AS PER CONSTRUCTION SPECIFICATIONS | Complimenting Colour | RIO |
| Treads | AS PER CONSTRUCTION SPECIFICATIONS | Complimenting Colour | RIO |

Red Oak Stairs

☒ Yes

☐ No

** Refer to Construction Summary

THE STAIN COLOURS OR FINISH AVAILABLE ON RISERS, TREADS, PICKETS AND RAILS (STAIRCASES), WILL NOT BE AN EXACT MATCH TO PREFINISHED HARDWOOD OR LAMINATE FLOORS.

9. Wall Paint Flat Finish

| | | | |
|------------------------------|--------------|----------------------------|--------------|
| Main & Upper Hall | 22 WARM GREY | Master Bedroom | 22 WARM GREY |
| Living Room | 22 WARM GREY | Bedroom #2 | 22 WARM GREY |
| Dining Room | 22 WARM GREY | Bedroom #3 | 22 WARM GREY |
| Kitchen / Breakfast | 22 WARM GREY | Bedroom #4 | 22 WARM GREY |
| Family Room | 22 WARM GREY | Bedroom #5 | N/A |
| Powder Room | 22 WARM GREY | Master Ensuite | 22 WARM GREY |
| Laundry Room | 22 WARM GREY | Ensuite Bath - Bedroom 2/3 | 22 WARM GREY |
| Den/Library | N/A | Ensuite Bath - 4/ Flex | 22 WARM GREY |
| Trim & Door Paint-Semi Gloss | BIRCH WHITE | Guest Suite / Guest Ens | 22 WARM GREY |
| | | Flex Space | 22 WARM GREY |
| | | | |

Smooth Ceilings First Floor

☐ Yes

☒ No

** Refer to Construction Summary

10. Plaster Mouldings and Medallions

| | | | | | |
|--------------------|-----|-----|-------------------|-----|-----|
| Entrance Vestibule | N/A | N/A | Kitchen/Breakfast | N/A | N/A |
| Main Hall | N/A | N/A | Den/Library | N/A | N/A |
| Living Room | N/A | N/A | Lower Landing | N/A | N/A |
| Dining Room | N/A | N/A | | N/A | N/A |
| Family Room | N/A | N/A | | | |

** Refer to Construction Summary

11. Fireplace

| | | | | | | | | | |
|----------------|-----------------------|-----------------------|----------------------------------|-----------------------|----------------------------------|-----------------------|-----------------------|-----------------------|----------------------------------|
| | Living Room | | | Family Room | | | Other Room - Specify | | |
| | Purchased | As Per Plan | N/A | Purchased | As Per Plan | N/A | Purchased | As Per Plan | N/A |
| | <input type="radio"/> | <input type="radio"/> | <input checked="" type="radio"/> | <input type="radio"/> | <input checked="" type="radio"/> | <input type="radio"/> | <input type="radio"/> | <input type="radio"/> | <input checked="" type="radio"/> |
| Fireplace Type | | | | FLAT ON WALL | | | | | |
| Mantle Type | | | | MANTLE M1-STANDARD | | | | | |
| Colour / Stain | | | | BIRCH WHITE | | | | | |
| Surround | | | | CREMA MARFIL | | | | | |
| Hearth | | | | N/A | | | | | |

** Refer to Construction Summary

12. Heating and Air Conditioning

| | | | |
|----------------------|----|-------------------------|-----|
| Air Conditioning | NO | Gas Provisions Stove | YES |
| Gas Provisions Dryer | NO | Gas Provisions Barbecue | YES |
| Comment | | | |

** Refer to Construction Summary

13. Electrical

| | | | | | |
|---------------------|---|---|---|---------------------------|-------------------------------------|
| Plugs and Switches | <input checked="" type="radio"/> White | DECOR | Above Kitchen Cabinet Light | <input type="radio"/> Yes | <input checked="" type="radio"/> No |
| Hood Fan | STANDARD WHITE TEMP. | | Below Kitchen Cabinet Light | <input type="radio"/> Yes | <input checked="" type="radio"/> No |
| Appliances | Built in Cooktop | Built in Oven | Gas Stove | Microwave | |
| | <input type="radio"/> Yes <input checked="" type="radio"/> No | <input type="radio"/> Yes <input checked="" type="radio"/> No | <input checked="" type="radio"/> Yes <input type="radio"/> No | <input type="radio"/> Yes | <input checked="" type="radio"/> No |
| Dishwasher Rough-in | Yes | | | | |

** Refer to Construction Summary

14. General Comments


** Refer to Construction Summary

Disclaimers and Notes

- 1) Colours of all materials are as close as possible to builder's selection, but not necessarily identical due to variances in manufacturing.

2) Any extras listed above are null and void unless accompanied by a separate invoice/amendment. Said invoice must be paid in full.

3) The Purchaser agrees that this colour selection is final and that no changes will be permitted, unless required by the Vendor.

4) The Purchaser acknowledges reading and accepting document which contains other miscellaneous disclaimers.
- Signature: 

Date: 03-Jun-2022

Signature: P. Noted

Date: June 3, 2022

LOT # 570
Springfield Eleven - Elev 3
4 Bdrm with Guest



ELEVATION 2 • 3,641 sq.ft.



ELEVATION 3 • 3,633 sq.ft.

grading variance. Actual usable floor space may vary from the
d. adjoining model types may vary due to siting. E. & O.E. May 2021

- * WALK-UP BASEMENT STAIR
- * 3 ENLARGED BASEMENT
- * 200 AMP / PLUG FOR ELECTRIC CAR CHARGER

LIV/DIN

- * 4 potlights
- * center standard light

FAMILY


- * 6 potlights
- * center standard light
- * Plug above fireplace
- * Plug centered on wall 5ft high

KITCHEN

- * 2 potlights
- * relocate and center standard light above island

* EXTERIOR POTLIGHTS

MASTER ENS.
* TOILET
* FRAMELESS GLASS DOOR

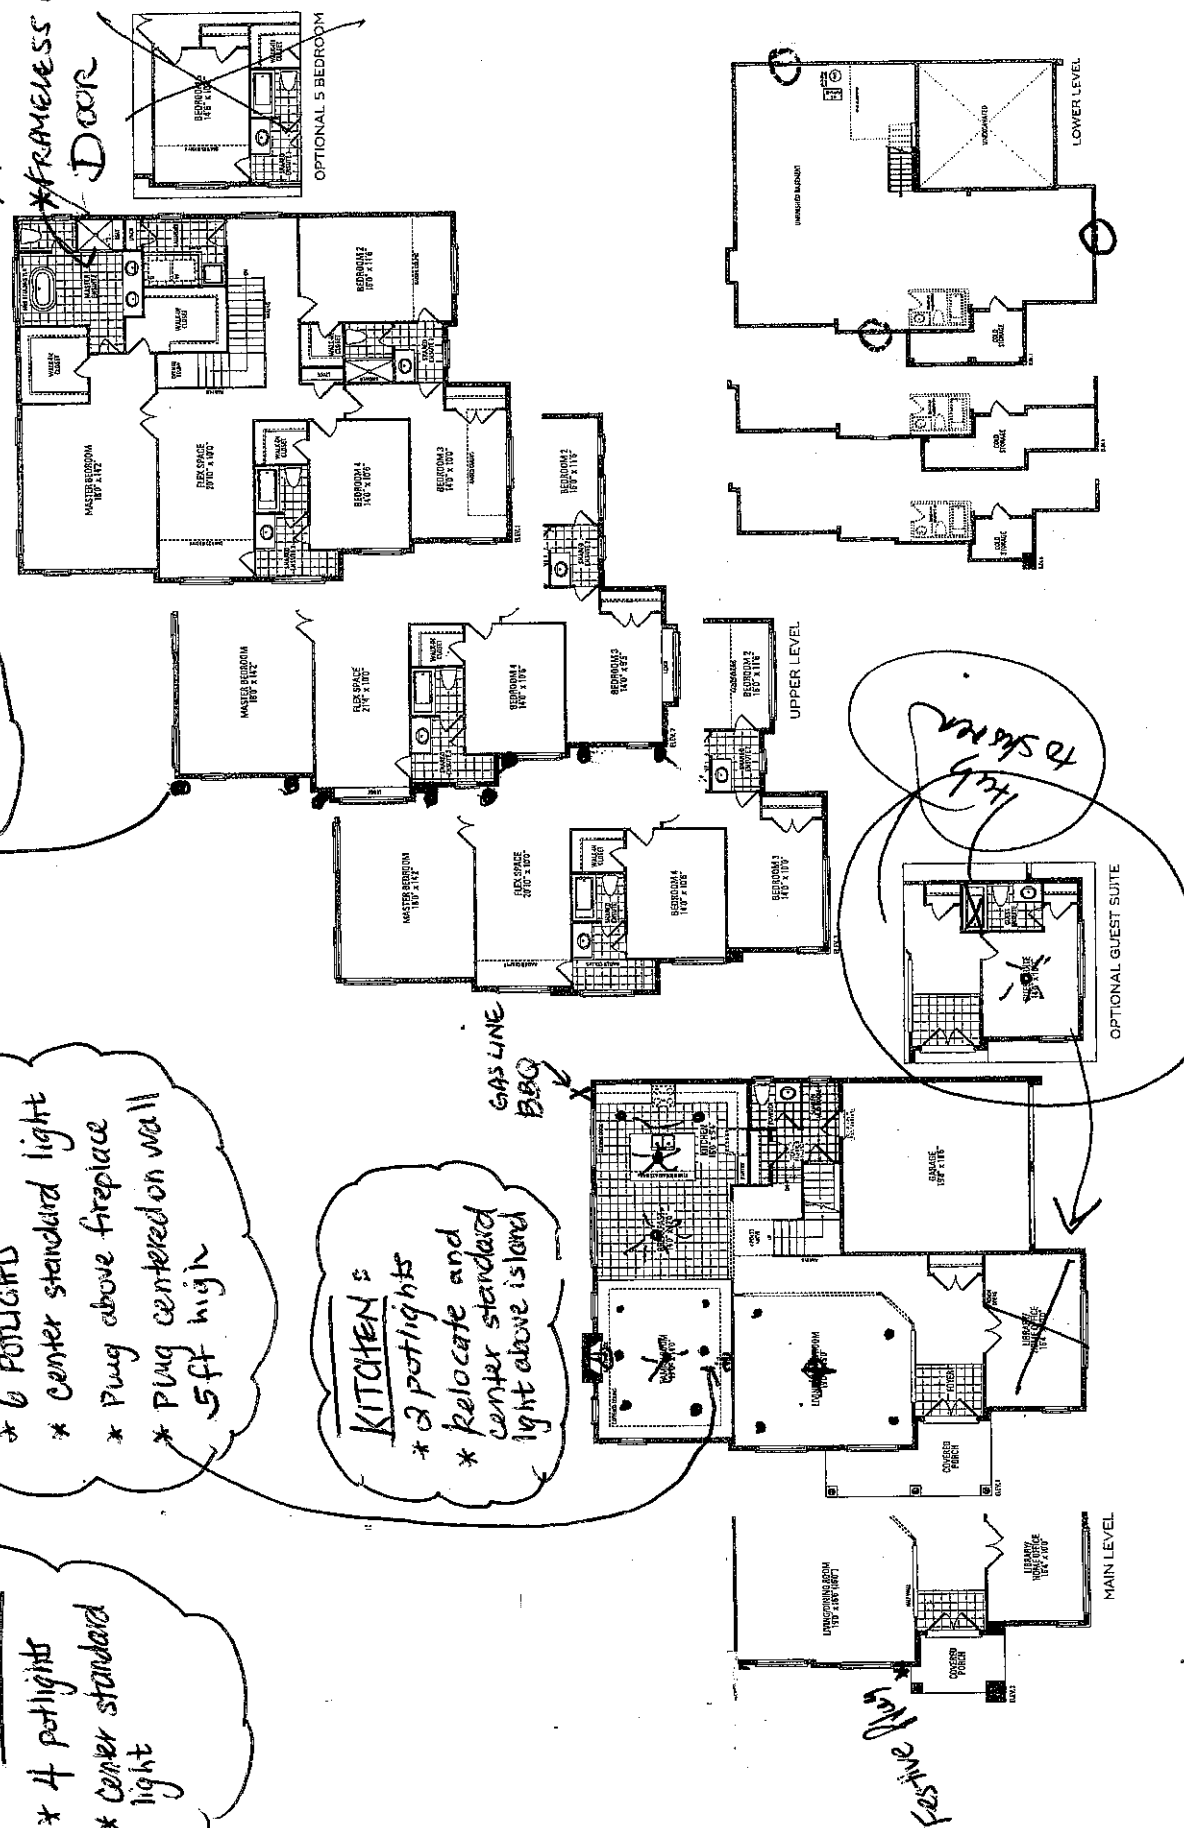

SPRINGFIELD ELEVEN ELEV. 1 • 3,621 sq.ft. | ELEV. 2 • 3,641 sq.ft. | ELEV. 3 • 3,633 sq.ft. | Include 16 sq.ft. of open area.


Orientation of home may be reversed and purchaser agrees to accept same. Steps and porches may vary due to grading variance. Actual usable floor space may vary from the
stand floor areas. All renderings are artist's concepts. Dimensions, specifications and architectural detailing subject to modifications. Redline and adjoining model types may vary due to siting. E. & O.E. May 2021

* RAISE VANITY TO 36" HIGH - POWDER

- ENSUITE
- ENSUITE 4 / FLEX
- ENSUITE 2 / 3
- GUEST SUITE

CT= 750 LAUNDRY

CT= 780 POWDER

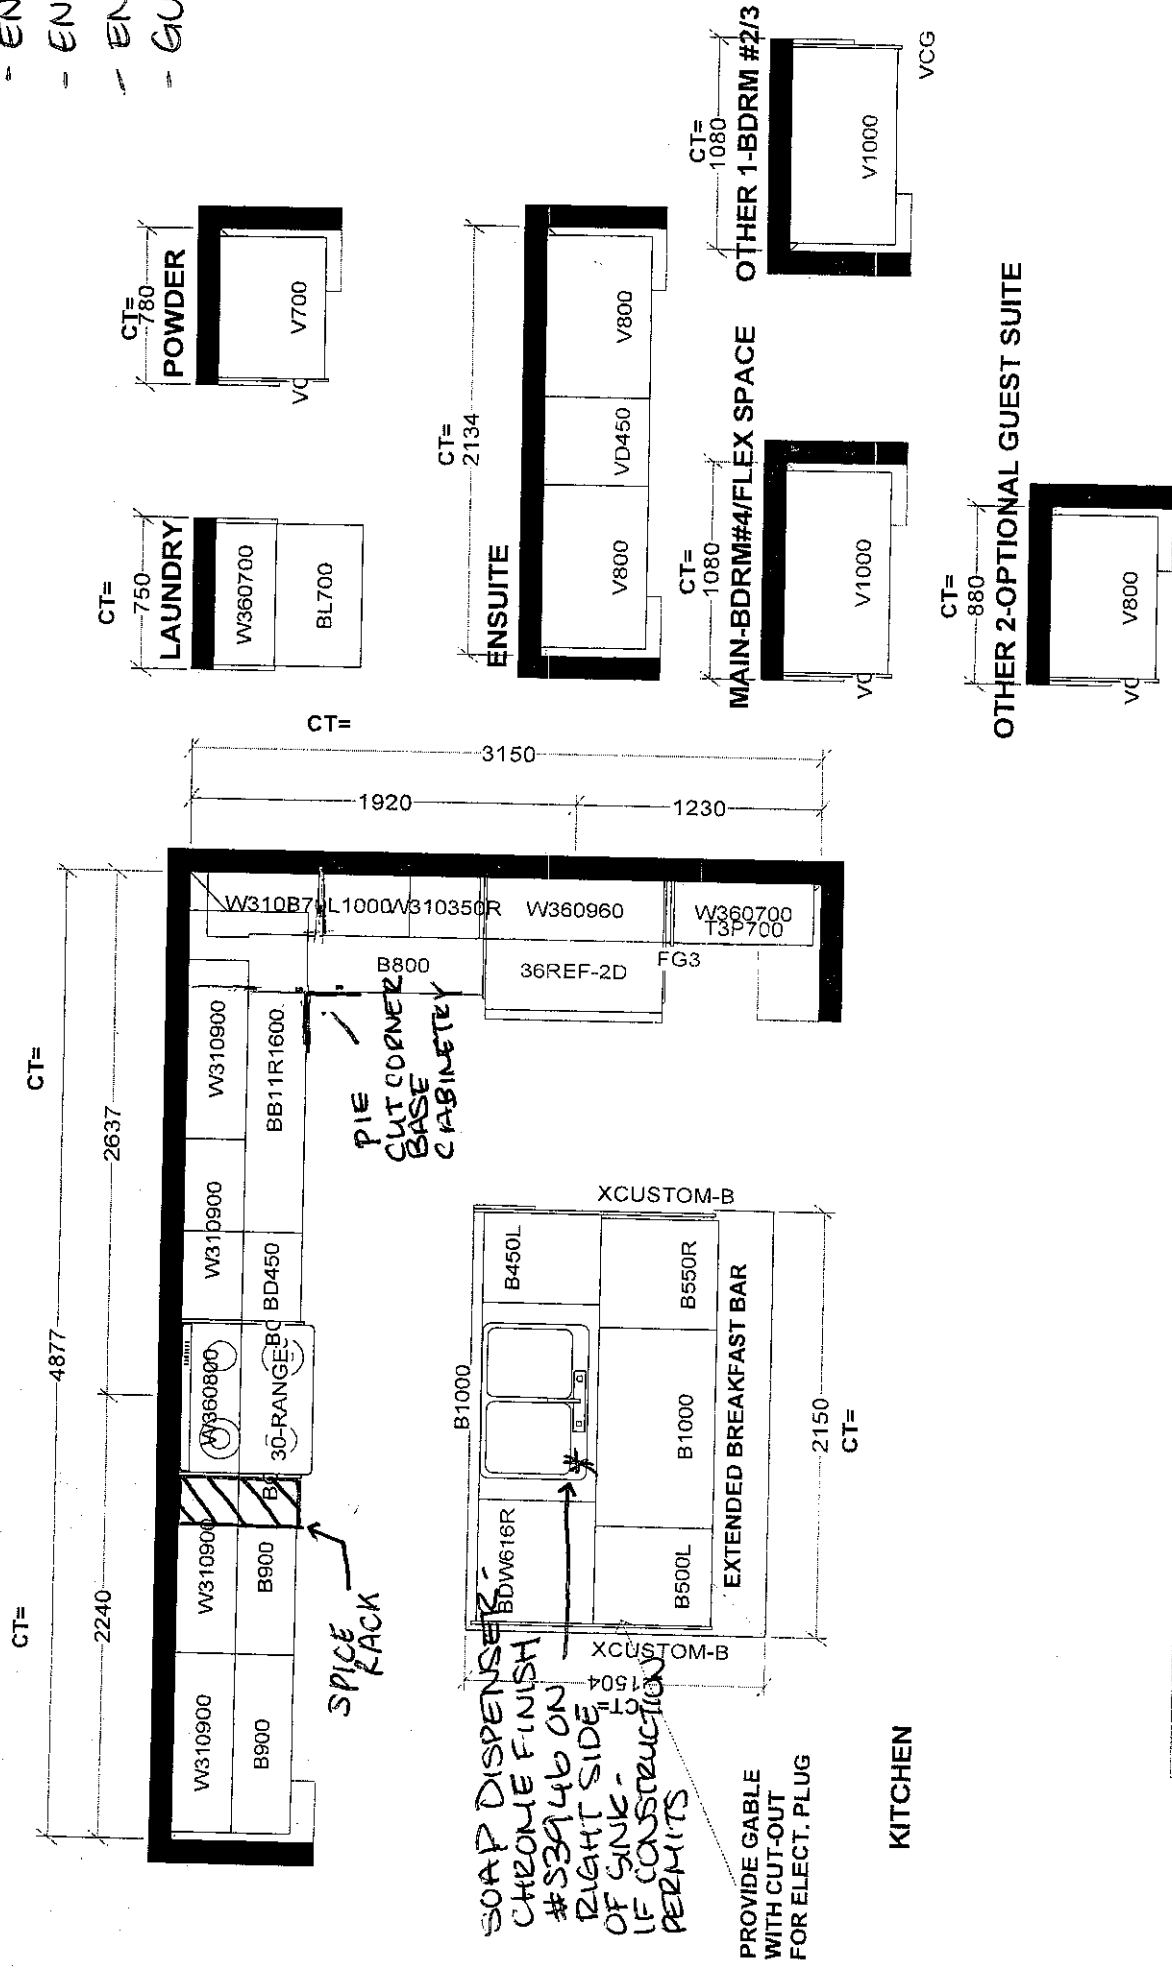

Selba Industries **J #**

W WIDTH _____ W HGT _____ W CNT _____

FLOOR HGT _____ DOOR HGT _____

ST CENT _____ 2X4 _____ VENT BOX COVER _____

This drawing is the intellectual property of SELBA INDUSTRIES INC. and is an original design which must not be released or copied unless applicable fee has been paid or job order placed.

JOB NUMBER:

BUILDER: GREENPARK

SITE: RUSSELL GARDENS PH.4

MODEL: SPRINGFIELD 11X EL 1 2 3

LOT #: 570

DESIGNER: LR

DATE: APR 28 21

OPT GRND FLR

K.G. Phase H