

CONSTRUCTION SUMMARY - PARTIAL ONLY

Mountainview Heights 3 (G) - Russell Gardens Building Ltd.

PURCHASERS: KULDIP SINGH TOOR and KIRANADEEP TOOR

TEL: RES.: 647-631-2009

LOT NUMBER	PHASE	HOUSE TYPE	REG. PLAN #		
322	3	Mountainash Seven Elev 3	62M-1266		

INV#	QTY	EXTRA / CHANGE	COMMENTS
------	-----	----------------	----------

CABINETRY

25,817 14Jul21	1 - CABINETRY - KITCHEN - UPGRADE 2 Note:
25,817 14Jul21	1 - CABINETRY - KITCHEN - LIGHT VALENCE Note:
25,817 14Jul21	1 - VANITY - POWDER ROOM - UPGRADE 2 Note:
25,817 14Jul21	1 - KITCHEN - DELETE CABINETS ABOVE STOVE - VENDOR WILL SUPPLY 6 INCH VENT AS PER CONSTRUCTION SPECIFICATIONS AND VENT MAY NOT BE IN THE APPROPRIATE LOCATION FOR INSTALLATION OF PURCHASER SUPPLIED VENT - PURCHASER TO SUPPLY OWN FAN AFTER CLOSING Note:TEMPORARY HOOD FAN MAY BE PROVIDED
25,817 14Jul21	1 - CABINETRY - KITCHEN - HARDWARE UPGRADE 2 Note:

CABINETRY ACCESSORIES

27,782 05Oct22	1 - *** DELETE*** - KITCHEN CABINETRY BASE - PIE CUT CORNER CABINET - BASE CABINETRY - UPGRADE 2 Note:DOES NOT FIT NEW Oct.17/22
25,817 14Jul21	1 - KITCHEN CABINETRY BASE - PULLOUT WIRE SPICE RACK - PRICE IS EACH Note:
25,817 14Jul21	1 - KITCHEN CABINETRY BASE - POT/PAN DRAWERS (CABINET) - UPGRADE 2 Note:
25,817 14Jul21	1 - KITCHEN CABINETRY UPPER - ANGLED CORNER CABINET - FITS TALL UPPER CABINETS - PER UNIT - UPGRADE 2 Note:
25,817 14Jul21	1 - KITCHEN CABINETRY UPPER - GLASS DOOR - GLK340 CORD GLASS - FINISHED INTERIOR - FITS TALL UPPER CABINETS ONLY - PRICE IS PER DOOR - UPGRADE 2 Note:
25,817 14Jul21	1 - KITCHEN CABINETRY BASE - COOKTOP CABINET WITH PANEL CUTOUT FOR BUILT IN OVEN BELOW - UPGRADE 2 Note: New oven specs. Oct.17/22
25,817 14Jul21	1 - KITCHEN CABINETRY BASE - BUILT-IN - MICROWAVE BASE CABINET WITH SINGLE POT DRAWER - 800MM WIDE - PRICE IS EACH - UPGRADE 2 Note:
25,817 14Jul21	1 - KITCHEN CABINETRY BASE - PULLOUT RECYCLE 2 BIN - PRICE IS EACH Note:
25,817 14Jul21	1 - KITCHEN CABINETRY UPPER - FULL DEPTH ABOVE FRIDGE - WITH GABLES - 600MM - PRICE IS EACH - UPGRADE 2 Note:
25,817 14Jul21	1 - PANTRY UNIT UPGRADE - TO GO FROM 300MM TO 600MM DEEP - PRICE IS PER FOOT - UPGRADE 2 Note:

CONSTRUCTION SUMMARY - PARTIAL ONLY
Mountainview Heights 3 (G) - Russell Gardens Building Ltd.

PURCHASERS: KULDIP SINGH TOOR and KIRANADEEP TOOR
TEL: RES.: 647-631-2009

LOT NUMBER	PHASE	HOUSE TYPE	REG. PLAN #		
322	3	Mountainash Seven Elev 3	62M-1266		


INV#	QTY	EXTRA / CHANGE	COMMENTS
------	-----	----------------	----------

CABINetry ACCESSORIES

25,817 14Jul21	1 - KITCHEN CABINetry BASE - PIE CUT CORNER CABINET - BASE CABINetry - UPGRADE 2 Note: Cancelled
-------------------	--

This Document is Extremely Time Sensitive - Printed 5 Oct 22 at 16:43

- up 2
- valence

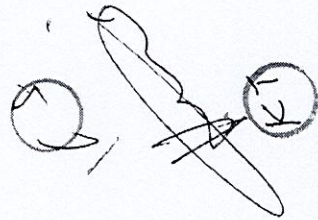

Built-In Electric Wall Oven

Installation manual

NV51*5512**



SAMSUNG


DocuSigned by:
kullip Toor
F0F34DE40E3F4C8...

322 Russell
Gardens 3

P.1 of 5


Standard cabinet dimensions

- 01 Dimensions provide minimum reveals, (except electrical supply location 'E')
- 02 Allow a minimum of 22" (559 mm) for clearance to adjacent corners, drawers, walls, etc. when door is open.

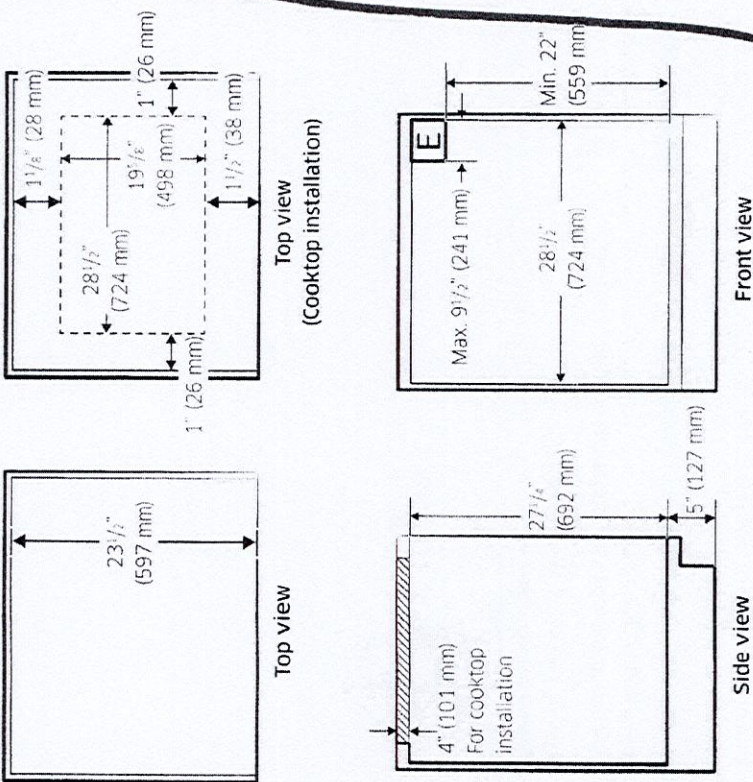

Flush cabinet dimensions

- 01 Dimensions provide minimum reveals, (except electrical supply location 'E')
- 02 Allow a minimum of 22" (559 mm) for clearance to adjacent corners, drawers, walls, etc. when door is open.
- 03 Flush installation requires recessed strips (not included) attached to the side of the cabinet opening for mounting the oven.

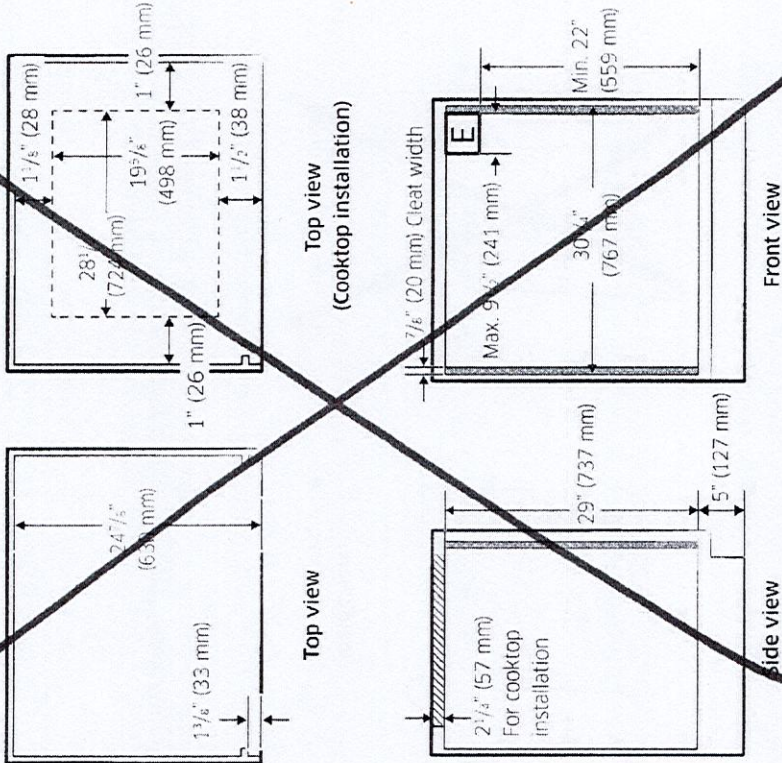

Preparation

DocuSigned by:
bulldip Toor
FOF34DE40E3F4C8

322 Russell
Gardens 3
P. 3 of 5

Installation instructions

- Flexible conduit from the oven should be connected directly to the junction box.
- Fuse both sides of the line.
- Do not cut the conduit. The length of conduit provided is for serviceability of the oven.
- A UL listed or CSA approved conduit connector must be provided.
- If the house has aluminum wiring, follow the procedure below:

1. Connect a section of solid copper wire to the ends of the flexible conduit leads.
2. Connect the aluminum wiring to the added section of copper wire using special connectors and/or tools designed and UL listed for joining copper to aluminum.

Follow the electrical connector manufacturer's recommended procedure. Aluminum/copper connection must conform with local codes and industry accepted wiring practices.

For power requirements for models NV51K6650D, NV51K6650S, NV51K7770D, NV51K7770S, NV51*5***D, and NV51*5***S, refer to the following table.

Model	240 VAC		208 VAC	
	KW		KW	
NV51K6650D	9.3		7.0	
NV51K6650S	4.9		3.7	
NV51K7770D	10.6		8.0	
NV51K7770S	6.2		4.7	
NV51*5***D	8.9		6.7	
NV51*5***S	4.9		3.7	

Prepare built-in oven

⚠ WARNING

Excessive Weight Hazard

Use two or more people to move and install an oven. Failure to do so can result in back or other injury.

1. Decide on the final location for the oven. Avoid drilling or cutting into house wiring during installation.
2. To avoid floor damage, set the oven on a cardboard prior to installation. Do not use handle or any portion of the front frame for lifting.
3. Remove the shipping materials and tape from the oven. Remember to keep the packing materials that may be needed for installation.
4. Remove the hardware package from inside of the bag containing literature.
5. Remove racks and other parts from inside the oven.
6. Move oven and cardboard close to the oven's final location.

Installation instructions

DocuSigned by:
Kuldeep Toor
F0F34DE40E3F4C8...

322 Russell
Gardens 3
P. 5 of 5