

CONSTRUCTION SUMMARY

Red Oaks - Roundel Homes Inc.

PURCHASER: Yanghao WANG

TEL: RES.: 416-897-3163

LOT / PHASE 110 / 1	REG. PLAN # 65M-4737	HOUSE TYPE Glenrowan 3 Elev 2		
------------------------	-------------------------	----------------------------------	--	--

CABINETRY ACCESSORIES

1 - KITCHEN CABINETRY BASE - COOKTOP CABINET WITH POT DRAWERS (2 DRAWERS) - STANDARD 16Nov22 Note:	
1 - KITCHEN CABINETRY - BUILT-IN MICROWAVE/OVEN COMBO - STANDARD NEXT TO FRIDGE 16Nov22 Note:	
1 - KITCHEN CABINETRY UPPER - FULL DEPTH ABOVE FRIDGE - WITH GABLES - 600MM - PRICE IS EACH - STANDARD 16Nov22 Note:	

CONSTRUCTION

1 - PROVISION FOR SHAMPOO NICHE APPROX. 14" WIDE X 20" HIGH AS PER SKETCH – IF CONSTRUCTION PERMITS MASTER ENSUITE 16Nov22 Note:	
1 - SMOOTH CEILINGS ON FIRST FLOOR ONLY - DET 16Nov22 Note:	

COUNTER TOP

1 - SHAMPOO NICHE 14" WIDE X 20" HIGH AS PER SKETCH – MARBLE, GRANITE OR QUARTZ – IF CONSTRUCTION PERMITS - REQUIRES PROVISION FROM CONSTRUCTION MASTER ENSUITE 16Nov22 Note: SUPPLY & INSTALL	
--	--

ELECTRICAL

1 - MASTER ENSUITE - PLUG - ELECTRICAL PLUG WITH GFI - NEXT TO TOILET 16Nov22 Note:	
1 - BUILT IN OVEN/MICRO AND COOKTOP PROVISION - PROVISION ONLY - ELECTRICAL ONLY 16Nov22 Note: NEXT TO FRIDGE	
1 - RELOCATE STANDARD KITCHEN LIGHT TO BE CENTERED OVER ISLAND 16Nov22 Note:	
1 - PLUG - ELECTRICAL PLUG - TO BE INSTALLED OVER FIREPLACE 16Nov22 Note:	

FIREPLACE AND ACCESSORIES

1 - GAS LINE ROUGH-IN FOR STOVE (INCLUDES ELECTRICAL OUTLET) - FIRST FLOOR 16Nov22 Note:	
---	--

HEATING AND AIR CONDITIONING

1 - HUMIDIFER 16Nov22 Note:	
--------------------------------	--

MIRRORS AND GLASS

CONSTRUCTION SUMMARY
Red Oaks - Roundel Homes Inc.

PURCHASER: Yanghao WANG TEL: RES.: 416-897-3163

LOT / PHASE 110 / 1	REG. PLAN # 65M-4737	HOUSE TYPE Glenrowan 3 Elev 2		
------------------------	-------------------------	----------------------------------	--	--

1 - ***INSERT --- FRAMELESS GLASS SHOWER DOOR FOR 5 FOOT PAN - INCLUDES CHROME KNOB & HINGES

MASTER ENSUITE
16Nov22 Note:

1 - ~~FRAMELESS GLASS SHOWER DOOR FOR 5 FOOT PAN - INCLUDES CHROME KNOB & HINGES~~

~~MASTER ENSUITE~~

16Nov22 Note:

1 - ~~FRAMELESS GLASS SHOWER DOOR FOR 5 FOOT PAN - INCLUDES CHROME KNOB & HINGES~~

16Nov22 Note: ~~MASTER ENSUITE~~

PLUMBING

1 - VOSS POSI-TEMP TUB/SHOWER FAUCET WITH 3 FUNCTION TRANSFER VALVE/TRIM AND SLIDE BAR WITH HAND SHOWER
- CHROME T2693EP / U361C1 / UT4611 / S3880EP / A721 / 62320

AT MASTER ENSUITE
16Nov22 Note:

1 - MASTER ENSUITE - TOE TESTER - ADD TOE TESTER TO SHOWER

16Nov22 Note:

1 - WATER LINE FOR FRIDGE - ROUGH-IN ONLY

16Nov22 Note:

PROMOTIONAL

1 - LESS CREDIT FROM PURCHASER EXTRA SHEET IN OFFER

16Nov22 Note:

This Document is Extremely Time Sensitive - Printed 21 Nov 22 at 11:39

MASTER ENSUITE: *Add plug next to toilet

* 14x20 Shampoo Niche

*Frameless Glass Door

*TOE TESTER

MASTER BEDROOM
17'0" x 16'0"


MASTER ENSUITE

FREE STANDING TUB


SHOWER

ELEV. 2' & 3' 2,932 sq.ft.
Includes 11 sq.ft. of open area.


LOT 110

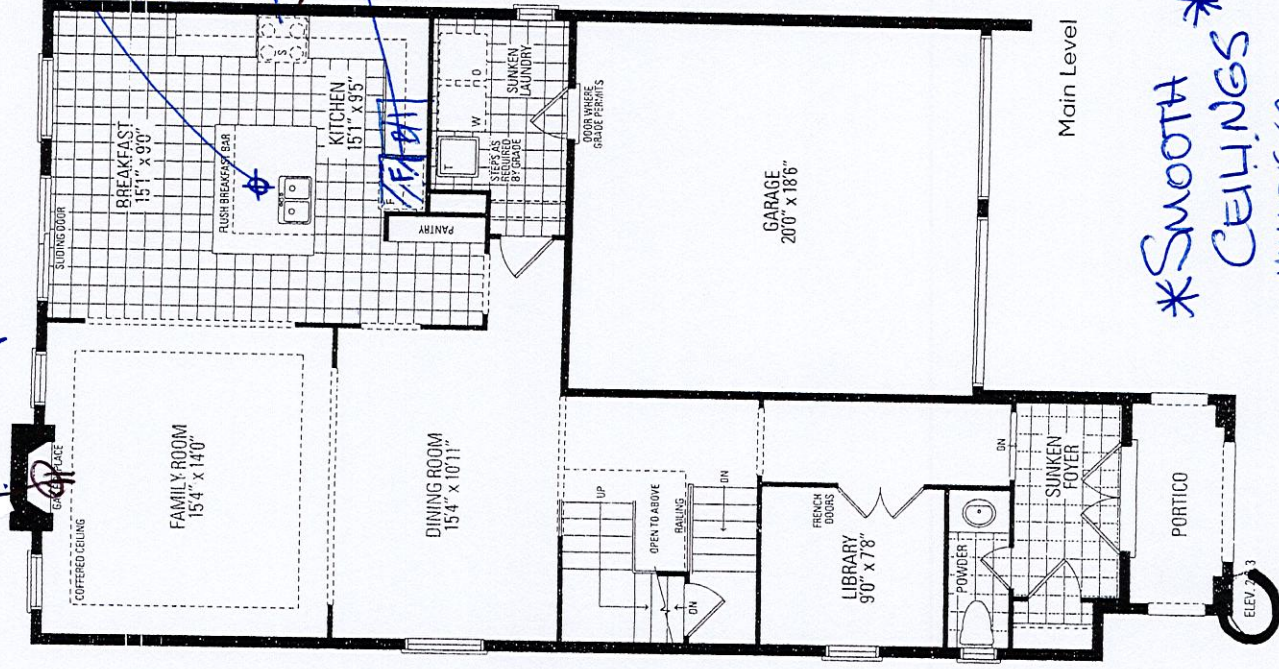

* SMOOTH *
* CEILING *
* HUNDRED *

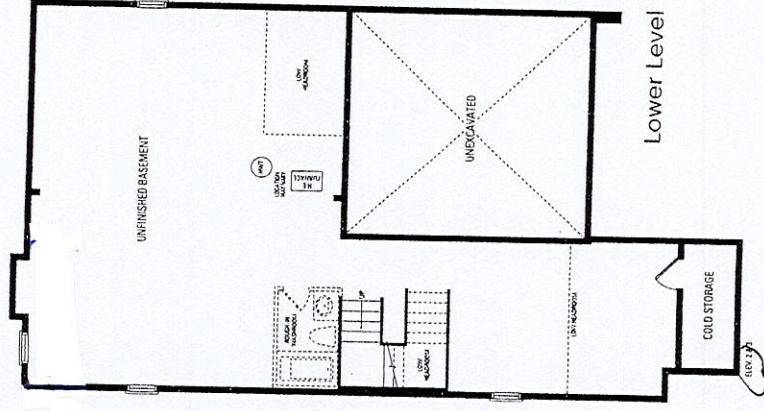


Lower Level

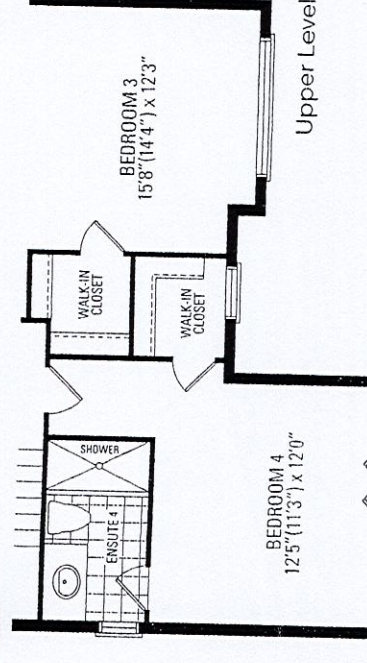


Upper Level

LOT
#110
Roundel.

Voss™

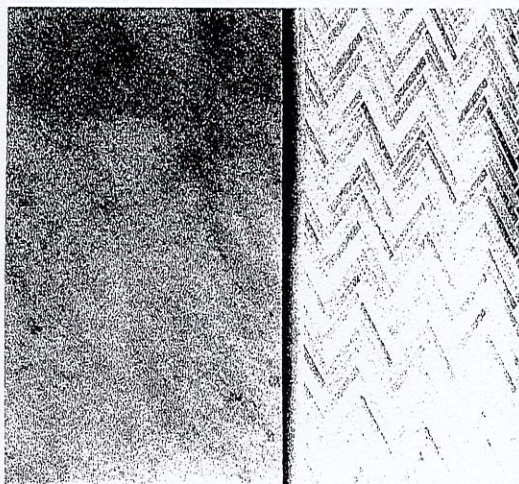

POSI-TEMP®

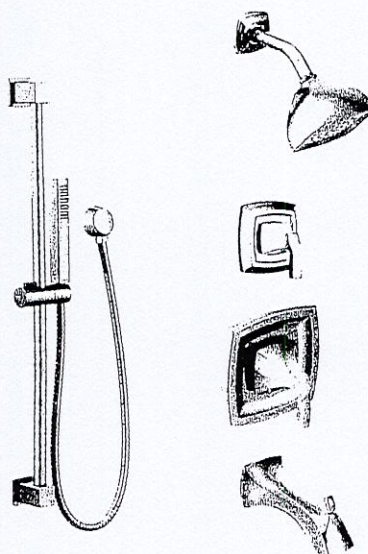

Posi-Temp® Tub/Shower Faucet with
3 Function Transfer Valve/Trim and
Slide Bar with Hand Shower*

T2693EP / U361CI / UT4611 /
S3880EP / A721 / 62320

Chrome Finish

@MASTER ENSUITE

W