

CONSTRUCTION SUMMARY

Red Oaks - Roundel Homes Inc.

PURCHASER: Linda Dan LIN

TEL: RES.: 647-992-5235

LOT / PHASE 168 / 1	REG. PLAN # 65M-4737	HOUSE TYPE Terracotta 3 (4 Bedroom) Elev 2		
------------------------	-------------------------	---	--	--

CONSTRUCTION

1 - SMOOTH CEILINGS ON FIRST FLOOR ONLY - DET 15Nov22 Note:	
--	--

ELECTRICAL

1 - FAN - BATHROOM EXHAUST FAN - ENERGY STAR 80 CFM - IN LIEU OF STANDARD FAN MASTER ENSUITE ONLY 15Nov22 Note:	
1 - ABOVE KITCHEN ISLAND - ADD LIGHT AND SWITCH - NO FIXTURE INCLUDED 15Nov22 Note:	
1 - ELECTRIC VEHICLE ROUGH-IN PROVISION ONLY FOR FUTURE ELECTRIC CAR (CONDUIT FROM BASEMENT INTO JUNCTION BOX IN GARAGE WITH PULL STRING, NO WIRE) 15Nov22 Note:	

FIREPLACE AND ACCESSORIES

1 - GAS LINE ROUGH-IN FOR STOVE (INCLUDES ELECTRICAL OUTLET) - FIRST FLOOR 15Nov22 Note:	
---	--

MIRRORS AND GLASS

1 - FRAMELESS GLASS SHOWER DOOR - INCLUDES CHROME KNOB & HINGES MASTER ENSUITE 15Nov22 Note:	
--	--

PLUMBING

2 - TOE TESTER - ADD TOE TESTER TO SHOWER MASTER ENSUITE AND BED 4 ENSUITE 15Nov22 Note:	
--	--


PROMOTIONAL

1 - LESS BALANCE OF CREDIT FROM PURCHASER EXTRA SHEET IN OFFER 15Nov22 Note:	
---	--

This Document is Extremely Time Sensitive - Printed 15 Nov 22 at 11:40

*SEE PURCHASER
ALTERATION PER
SALES P.E.

Includes 10 sq.ft. of open area.

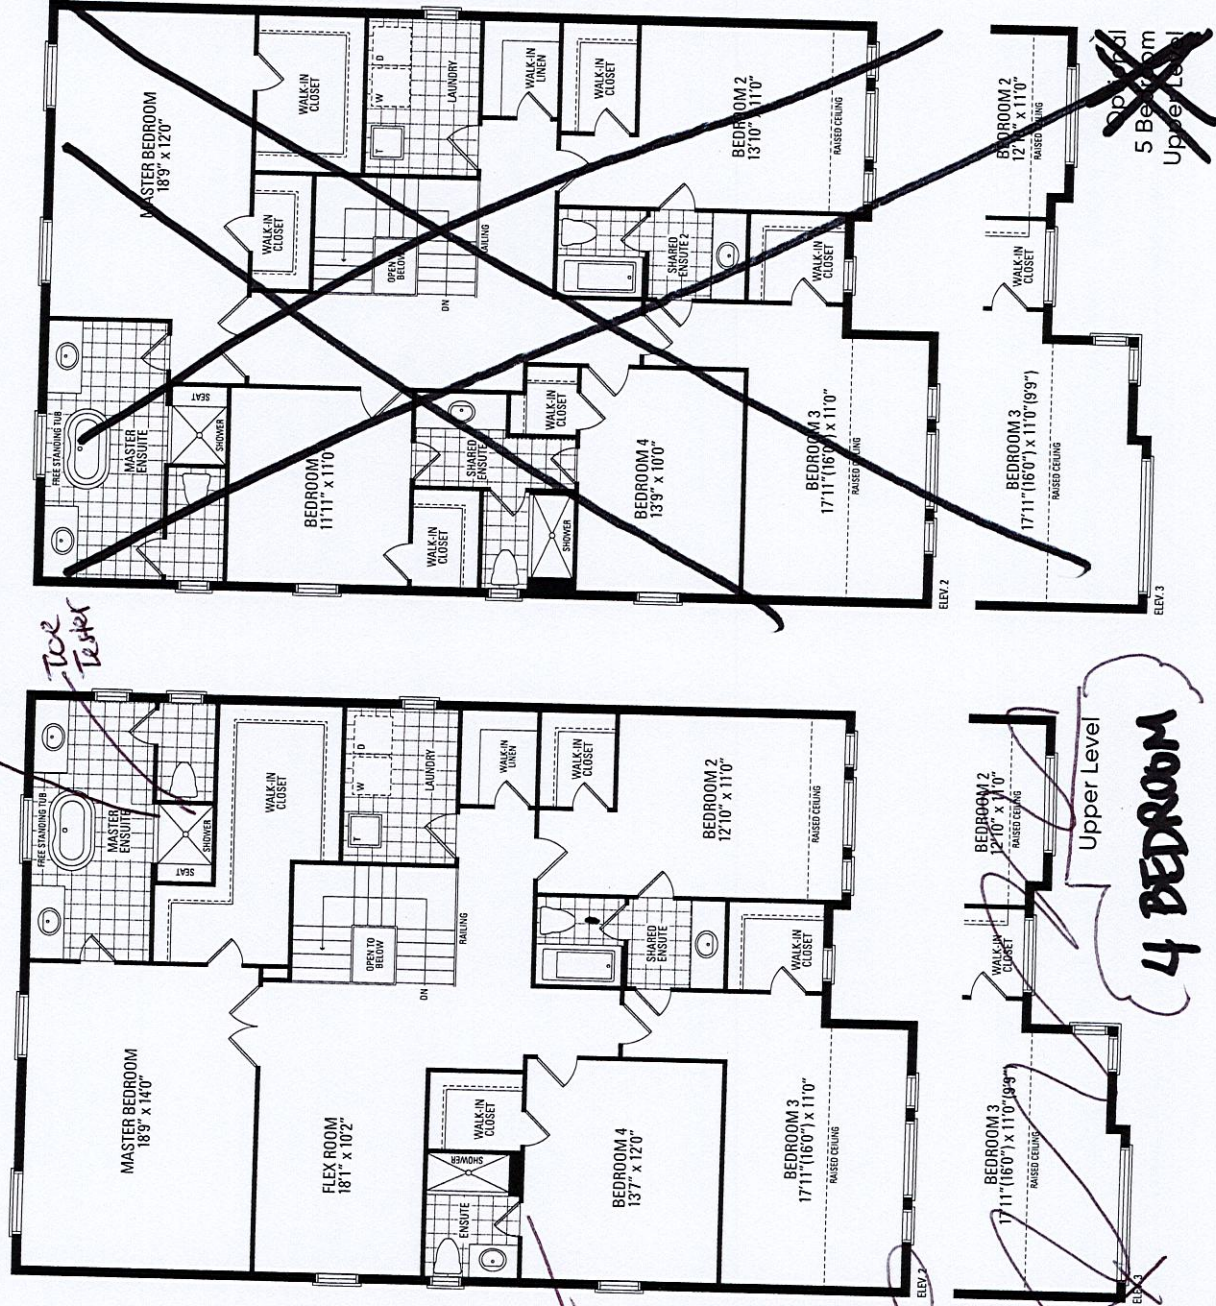

Main Level

4 BEDROOM