

SITE NAME: ROUNDEL HOMES INC

BUILDER: GREENPARK HOMES

TYPE: PINETREE 1

GFA: 2366

DATE: May-21

LO# 90731

WINTER NATURAL AIR CHANGE RATE 0.361

SUMMER NATURAL AIR CHANGE RATE 0.113

HEAT LOSS AT °F. 78

HEAT GAIN AT °F. 13

CSA-F280-12

SB-12 PACKAGE A1

ROOM USE	EXP. WALL	CLG. HT.	MBR	ENS	WIC	BED-2	BED-3	BED-4	BATH	ENS-2
			14	22	30	11	36	14	6	20
			9	9	9	9	9	9	9	9
FACTORS	LOSS	GAIN	LOSS	GAIN	LOSS	GAIN	LOSS	GAIN	LOSS	GAIN
GRS.WALL AREA	126		198		270		324		126	
GLAZING	LOSS	GAIN	LOSS	GAIN	LOSS	GAIN	LOSS	GAIN	LOSS	GAIN
NORTH	21.8	16.0	0	0	0	0	0	0	0	0
EAST	21.8	41.6	0	0	0	0	0	0	0	0
SOUTH	21.8	24.9	0	0	7	152	174	0	0	0
WEST	21.8	41.6	22	479	914	14	305	582	0	0
SKYLT.	38.1	101.5	0	0	0	0	0	0	0	0
DOORS	25.8	4.3	0	0	0	0	0	0	0	0
NET EXPOSED WALL	4.6	0.8	104	475	78	177	809	133	270	1233
NET EXPOSED BSMT WALL ABOVE GR	3.7	0.6	0	0	0	0	0	0	0	0
EXPOSED CLG	1.3	0.6	336	441	197	120	158	71	144	189
NO ATTIC EXPOSED CLG	2.8	1.3	0	0	0	0	0	0	16	45
EXPOSED FLOOR	2.6	0.4	0	0	0	0	0	0	140	366
BASEMENT/CRAWL HEAT LOSS			0		0		0		0	
SLAB ON GRADE HEAT LOSS			0		0		0		0	
SUBTOTAL HT LOSS			1396		1424		1423		1072	
SUB TOTAL HT GAIN				1190		960		288		1329
LEVEL FACTOR / MULTIPLIER	0.20	0.30			0.20	0.30		0.20	0.30	
AIR CHANGE HEAT LOSS			413		422		421		442	
AIR CHANGE HEAT GAIN				86		69		21		96
DUCT LOSS			0		0		0		193	
DUCT GAIN				0		0		0		215
HEAT GAIN PEOPLE	240		2	480		0	0	0	1	240
HEAT GAIN APPLIANCES/LIGHTS				486		0	0	0		486
TOTAL HT LOSS BTU/H			1809		1845		1844		2125	
TOTAL HT GAIN x 1.3 BTU/H			2914		1337		401		3076	

Initials:

PXV

HVAC REVIEWED

Building Division

City of Richmond Hill

ROOM USE			FAM				KIT		DIN		LAUN		W/R		FOY		WIC-G						WOD		BAS		
EXP. WALL			32				38		26		27		5		22		11						43		160		
CLG. HT.			11				11		11		13		12		12		12						9		9		
GRS.WALL AREA	FACTORS		352				418		286		351		60		264		132						387		1089		
GLAZING	LOSS	GAIN	LOSS		GAIN		LOSS		GAIN		LOSS		GAIN		LOSS		GAIN						LOSS		GAIN		
NORTH	21.8	16.0	0	0	0		0	0	0	0	0	0	0	0	0	0	0	0	0	0	0	0	0	0	0	0	
EAST	21.8	41.6	0	0	0		0	0	0	0	0	0	0	0	0	9	196	374	14	305	582	0	0	0	0	0	
SOUTH	21.8	24.9	0	0	0		0	0	0	32	697	797	0	0	0	9	196	224	0	0	0	0	0	0	0	0	
WEST	21.8	41.6	46	1002	1911		34	741	1413	0	0	0	0	0	0	0	0	0	0	0	0	0	0	0	0	0	
SKYLT.	38.1	101.5	0	0	0		0	0	0	0	0	0	0	0	0	0	0	0	0	0	0	0	0	0	0	0	
DOORS	25.8	4.3	0	0	0		24	620	102	0	0	0	20	517	85	0	0	0	46	1189	196	0	0	0	0	0	
NET EXPOSED WALL	4.6	0.8	306	1398	230		360	1645	271	254	1160	191	331	1512	249	51	233	38	209	955	157	118	539	89	0	0	
NET EXPOSED BSMT WALL ABOVE GR	3.7	0.6	0	0	0		0	0	0	0	0	0	0	0	0	0	0	0	0	0	0	0	0	0	0	0	
EXPOSED CLG	1.3	0.6	0	0	0		0	0	0	0	0	0	0	0	0	0	0	0	0	0	0	0	0	0	0	0	
NO ATTIC EXPOSED CLG	2.8	1.3	0	0	0		38	107	48	0	0	0	0	0	0	0	0	0	0	0	0	0	0	0	0	0	
EXPOSED FLOOR	2.6	0.4	0	0	0		0	0	0	0	0	0	0	0	0	0	0	0	0	0	0	0	0	0	0	0	
BASEMENT/CRAWL HEAT LOSS					0				0			0			0			0			0					0	
SLAB ON GRADE HEAT LOSS					0				0			0			0			0			0					5420	
SUBTOTAL HT LOSS					2400				3113			1857			2029			429			2340			844			1276
SUB TOTAL HT GAIN					2141				1833			988			334			262			727			670			893
LEVEL FACTOR / MULTIPLIER			0.30	0.38			0.30	0.38		0.30	0.38		0.30	0.38		0.30	0.38		0.30	0.38			0.30	0.38		0.50	1.03
AIR CHANGE HEAT LOSS					924				1198			715			781			165			900			325			8346
AIR CHANGE HEAT GAIN					154				132			71			24			19			52			48			87
DUCT LOSS					0				0			0			0			0			0			0			0
DUCT GAIN					0				0			0			0			0			0			0			0
HEAT GAIN PEOPLE	240		0		0		0		0	0	0	0	0	0	0	0	0	0	0	0	0	0	0	0	0	0	0
HEAT GAIN APPLIANCES/LIGHTS					486				486			486			486			0			0			0			486
TOTAL HT LOSS BTU/H					3324				4310			2572			2810			594			3240			1169			1276
TOTAL HT GAIN x 1.3 BTU/H					3617				3187			2009			1098			366			1013			934			1161

TOTAL HEAT GAIN BTU/H: 30194

TONS: 2.52

LOSS DUE TO VENTILATION LOAD BTU/H: 1670

STRUCTURAL HEAT LOSS: 49761

TOTAL COMBINED HEAT LOSS BTU/H: 51431

I REVIEW AND TAKE RESPONSIBILITY FOR THE DESIGN WORK AND AM QUALIFIED IN THE APPROPRIATE CATEGORY AS AN "OTHER DESIGNER" UNDER DIVISION C, 3.2.5 OF THE BUILDING CODE.

Michael O'Rourke

INDIVIDUAL BCIN: 19669

MICHAEL O'ROURKE

21.73 btu/ft2

Per: joshua.nabua

RECEIVED

9/12/22

9/12/22

9/12/22

SITE NAME: ROUNDEL HOMES INC
BUILDER: GREENPARK HOMES

TYPE: PINETREE 1

DATE: May-21

GFA: 2366

LO# 90731

HEATING CFM 928
TOTAL HEAT LOSS 49,761
AIR FLOW RATE CFM 18.65

COOLING CFM 928
TOTAL HEAT GAIN 29,919
AIR FLOW RATE CFM 31.02

furnace pressure 0.6
furnace filter 0.05
a/c coil pressure 0.2
available pressure for s/a & r/a 0.35

#GOODMAN
GMEC960603BNA 60

AFUE = 96 %
INPUT (BTU/H) = 60,000
OUTPUT (BTU/H) = 57,600

RUN COUNT	4th	3rd	2nd	1st	Bas
S/A	0	0	11	9	4
R/A	0	0	4	2	1

plenum pressure s/a 0.18
max s/a dif press. loss 0.01
min adjusted pressure s/a 0.17

r/a pressure 0.17
r/a grille press. Loss 0.02
adjusted pressure r/a 0.15

FAN SPEED LOW
MEDLOW
MEDIUM 928
MEDIUM HIGH 1017
HIGH 1131

DESIGN CFM = 928
CFM @ .6" E.S.P.

All S/A diffusers 4"x10" unless noted otherwise on layout.
All S/A runs 5"Ø unless noted otherwise on layout.

RUN #	1	2	3	4	5	6	7	8	9	10	11	12	13	14	15	16	17	18	19	20	21	22	23	24
ROOM NAME	MBR	ENS	WIC	BED-2	BED-3	BED-4	BATH	BED-2	BED-3	MBR	ENS-2	FAM	FAM	KIT	KIT	DIN	LAUN	W/R	FOY	WIC-G	BAS	BAS	BAS	BAS
RM LOSS MBH.	0.90	1.85	1.84	1.06	1.92	1.39	0.60	1.06	1.92	0.90	1.86	1.66	1.66	2.16	2.16	2.57	2.81	0.59	3.24	1.17	4.11	4.11	4.11	4.11
CFM PER RUN HEAT	17	34	34	20	36	26	11	20	36	17	35	31	31	40	40	48	52	11	60	22	77	77	77	77
RM GAIN MBH.	1.46	1.34	0.40	1.54	2.32	1.75	0.35	1.54	2.32	1.46	0.90	1.81	1.81	1.59	1.59	2.01	1.10	0.37	1.01	0.93	0.58	0.58	0.58	0.58
CFM PER RUN COOLING	45	41	12	48	72	54	11	48	72	45	28	56	56	49	49	62	34	11	31	29	18	18	18	18
ADJUSTED PRESSURE	0.17	0.17	0.17	0.17	0.17	0.17	0.17	0.17	0.17	0.17	0.17	0.17	0.17	0.17	0.17	0.17	0.17	0.17	0.17	0.17	0.17	0.17	0.17	0.17
ACTUAL DUCT LGH.	39	47	41	53	65	33	45	58	69	37	63	39	26	27	15	44	14	51	45	55	19	35	33	52
EQUIVALENT LENGTH	120	130	130	130	195	205	180	150	180	160	150	120	100	100	180	100	140	150	100	110	130	120	150	120
TOTAL EFFECTIVE LENGTH	159	177	171	183	260	238	225	208	249	197	213	159	126	127	195	144	154	201	145	165	149	155	183	172
ADJUSTED PRESSURE	0.11	0.1	0.1	0.09	0.07	0.07	0.08	0.08	0.07	0.09	0.08	0.11	0.14	0.14	0.09	0.12	0.11	0.09	0.12	0.1	0.12	0.11	0.09	0.1
ROUND DUCT SIZE	4	4	4	5	6	6	4	5	6	4	4	5	5	4	5	5	4	4	5	4	5	5	5	5
HEATING VELOCITY (ft/min)	195	390	390	147	184	133	126	147	184	195	402	228	228	459	294	352	597	126	441	252	565	565	565	565
COOLING VELOCITY (ft/min)	516	470	138	352	367	275	126	352	367	516	321	411	411	562	360	455	390	126	228	333	132	132	132	132
OUTLET GRILL SIZE	3X10	3X10	3X10	3X10	4X10	4X10	3X10	3X10	4X10	3X10	3X10	3X10	3X10	3X10	3X10	3X10	3X10	3X10	3X10	3X10	3X10	3X10	3X10	3X10
TRUNK	D	C	D	B	A	B	B	B	A	D	B	C	C	D	D	B	D	A	A	A	D	C	B	A

RUN #
ROOM NAME
RM LOSS MBH.
CFM PER RUN HEAT
RM GAIN MBH.
CFM PER RUN COOLING
ADJUSTED PRESSURE
ACTUAL DUCT LGH.
EQUIVALENT LENGTH
TOTAL EFFECTIVE LENGTH
ADJUSTED PRESSURE
ROUND DUCT SIZE
HEATING VELOCITY (ft/min)
COOLING VELOCITY (ft/min)
OUTLET GRILL SIZE
TRUNK

Richmond Hill City of Richmond Hill
Building Division
HVAC REVIEWED
Initials: PXV

SUPPLY AIR TRUNK SIZE

	TRUNK CFM	STATIC PRESS.	ROUND DUCT	RECT DUCT		VELOCITY (ft/min)		TRUNK CFM	STATIC PRESS.	ROUND DUCT	RECT DUCT		VELOCITY (ft/min)
TRUNK A	242	0.07	8.5	8	x	8	545	TRUNK G	0	0.00	0	0	8
TRUNK B	479	0.07	11	14	x	8	616	TRUNK H	0	0.00	0	0	8
TRUNK C	173	0.10	6.9	8	x	8	389	TRUNK I	0	0.00	0	0	8
TRUNK D	929	0.07	14.1	24	x	8	697	TRUNK J	0	0.00	0	0	8
TRUNK E	0	0.00	0	0	x	8	0	TRUNK K	0	0.00	0	0	8
TRUNK F	0	0.00	0	0	x	8	0	TRUNK L	0	0.00	0	0	8

RETURN AIR TRUNK SIZE

	TRUNK CFM	STATIC PRESS.	ROUND DUCT	RECT DUCT		VELOCITY (ft/min)
TRUNK O	0	0.05	0	0	x	8
TRUNK P	0	0.05	0	0	x	8
TRUNK Q	0	0.05	0	0	x	8
TRUNK R	0	0.05	0	0	x	8
TRUNK S	0	0.05	0	0	x	8
TRUNK T	0	0.05	0	0	x	8
TRUNK U	0	0.05	0	0	x	8
TRUNK V	0	0.05	0	0	x	8
TRUNK W	0	0.05	0	0	x	8
TRUNK X	928	0.05	15.3	28	x	8
TRUNK Y	620	0.05	13.2	20	x	8
TRUNK Z	150	0.05	7.8	8	x	8
DROP	928	0.05	15.3	24	x	10

RETURN AIR #	1	2	3	4	5	6	7	8	9	10	11	12	13	14	15	16	17	18	19	20	21	22	23	24
AIR VOLUME	175	75	75	75	240	155	0	0	0	0	0	0	0	0	0	0	0	0	0	0	0	0	0	0
PLENUM PRESSURE	0.15	0.15	0.15	0.15	0.15	0.15	0.15	0.15	0.15	0.15	0.15	0.15	0.15	0.15	0.15	0.15	0.15	0.15	0.15	0.15	0.15	0.15	0.15	0.15
ACTUAL DUCT LGH.	35	67	61	60	36	36	1	1	1	1	1	1	1	1	1	1	1	1	1	1	1	1	1	1
EQUIVALENT LENGTH	175	205	230	225	225	225	0	0	0	0	0	0	0	0	0	0	0	0	0	0	0	0	0	0
TOTAL EFFECTIVE LENGTH	210	272	291	285	261	261	1	1	1	1	1	1	1	1	1	1	1	1	1	1	1	1	1	1
ADJUSTED PRESSURE	0.07	0.05	0.05	0.05	0.06	0.06	14.80	14.80	14.80	14.80	14.80	14.80	14.80	14.80	14.80	14.80	14.80	14.80	14.80	14.80	14.80	14.80	14.80	14.80
ROUND DUCT SIZE	7.5	6	6	6	8.8	7.5	0	0	0	0	0	0	0	0	0	0	0	0	0	0	0	0	0	0
INLET GRILL SIZE	8	8	8	8	8	8	0	0	0	0	0	0	0	0	0	0	0	0	0	0	0	0	0	0
INLET GRILL SIZE	X	X	X	X	X	X	X	X	X	X	X	X	X	X	X	X	X	X	X	X	X	X	X	X
INLET GRILL SIZE	14	14	14	14	30	14	0	0	0	0	0	0	0	0	0	0	0	0	0	0	0	0	0	0

TYPE: PINETREE 1
SITE NAME: ROUNDEL HOMES INC

LO # 90731

RESIDENTIAL MECHANICAL VENTILATION DESIGN SUMMARY

COMBUSTION APPLIANCES		9.32.3.1(1)
a) <input checked="" type="checkbox"/>	Direct vent (sealed combustion) only	
b) <input type="checkbox"/>	Positive venting induced draft (except fireplaces)	
c) <input type="checkbox"/>	Natural draft, B-vent or induced draft gas fireplace	
d) <input type="checkbox"/>	Solid Fuel (including fireplaces)	
e) <input type="checkbox"/>	No Combustion Appliances	

HEATING SYSTEM	
<input checked="" type="checkbox"/>	Forced Air
<input type="checkbox"/>	Non Forced Air
<input type="checkbox"/>	Electric Space Heat

HOUSE TYPE		9.32.1(2)
<input checked="" type="checkbox"/>	I Type a) or b) appliance only, no solid fuel	
<input type="checkbox"/>	II Type I except with solid fuel (including fireplaces)	
<input type="checkbox"/>	III Any Type c) appliance	
<input type="checkbox"/>	IV Type I, or II with electric space heat	
<input type="checkbox"/>	Other: Type I, II or IV no forced air	

SYSTEM DESIGN OPTIONS		O.N.H.W.P.
<input type="checkbox"/>	1 Exhaust only/Forced Air System	
<input type="checkbox"/>	2 HRV with Ducting/Forced Air System	
<input checked="" type="checkbox"/>	3 HRV Simplified/connected to forced air system	
<input type="checkbox"/>	4 HRV with Ducting/non forced air system	
<input type="checkbox"/>	Part 6 Design	

TOTAL VENTILATION CAPACITY		9.32.3.2(1)
Basement + Master Bedroom	2 @ 21.4 cfm	42.8 cfm
Other Bedrooms	3 @ 14.8 cfm	44.4 cfm
Kitchen & Bathrooms	5 @ 10.6 cfm	53.0 cfm
Other Rooms	4 @ 10.6 cfm	42.4 cfm
Table 9.32.3.A.	TOTAL	169.6 cfm

PRINCIPAL VENTILATION CAPACITY REQUIRED		9.32.3.4.(1)
1 Bedroom	31.8	cfm
2 Bedroom	47.7	cfm
3 Bedroom	63.6	cfm
4 Bedroom	79.5	cfm
5 Bedroom	95.4	cfm
TOTAL	79.5	cfm

SUPPLEMENTAL VENTILATION CAPACITY		9.32.3.5.
Total Ventilation Capacity	169.6	cfm
Less Principal Ventil. Capacity	79.5	cfm
Required Supplemental Capacity	90.1	cfm

PRINCIPAL EXHAUST FAN CAPACITY	
Model: VANE V150H	Location: BSMT
79.5 cfm	<input checked="" type="checkbox"/> HVI Approved

PRINCIPAL EXHAUST HEAT LOSS CALCULATION			
CFM	ΔT °F	FACTOR	% LOSS
79.5 CFM	78 F	1.08	0.25

SUPPLEMENTAL FANS		BY INSTALLING CONTRACTOR	
Location	Model	cfm	HVI
ENS	BY INSTALLING CONTRACTOR	50	<input checked="" type="checkbox"/>
BATH	BY INSTALLING CONTRACTOR	50	<input checked="" type="checkbox"/>
ENS-2	BY INSTALLING CONTRACTOR	50	<input checked="" type="checkbox"/>
W/R	BY INSTALLING CONTRACTOR	50	<input checked="" type="checkbox"/>


HEAT RECOVERY VENTILATOR		9.32.3.11.
Model: VANE V150H		
150 cfm high	35 cfm low	
75 % Sensible Efficiency	<input checked="" type="checkbox"/> HVI Approved	
@ 32 deg F (0 deg C)		

LOCATION OF INSTALLATION	
Lot:	Concession
Township	Plan:
Address	
Roll #	Building Permit #

BUILDER: GREENPARK HOMES	
Name:	
Address:	
City:	
Telephone #:	Fax #:

INSTALLING CONTRACTOR	
Name:	
Address:	
City:	
Telephone #:	Fax #:

DESIGNER CERTIFICATION	
I hereby certify that this ventilation system has been designed in accordance with the Ontario Building Code.	
Name:	HVAC Designs Ltd.
Signature:	<i>Michael O'Rourke</i>
HRAI #	001820
Date:	May-21

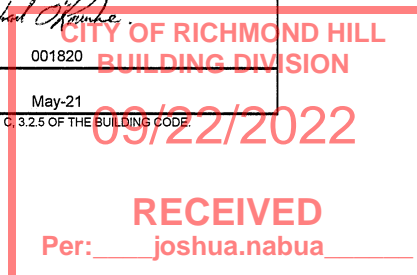I REVIEW AND TAKE RESPONSIBILITY FOR THE DESIGN WORK AND AM QUALIFIED IN THE APPROPRIATE CATEGORY AS AN "OTHER DESIGNER" UNDER DIVISION C.3.2.5 OF THE BUILDING CODE.
INDIVIDUAL BCIN: 19669 MICHAEL O'ROURKE


CSA F280-12 Residential Heat Loss and Heat Gain Calculations
Formula Sheet (For Air Leakage / Ventilation Calculation)

LO#: 90731

Model: PINETREE 1

Builder: GREENPARK HOMES

Date: 5/11/2021

Volume Calculation
House Volume

Level	Floor Area (ft²)	Floor Height (ft)	Volume (ft³)
Bsmt	1081	9	9729
First	1081	11	11891
Second	1285	9	11565
Third	0	9	0
Fourth	0	9	0
Total:			33,185.0 ft³
Total:			939.7 m³

Air Change & Delta T Data

WINTER NATURAL AIR CHANGE RATE	0.361
SUMMER NATURAL AIR CHANGE RATE	0.113

Design Temperature Difference

	Tin °C	Tout °C	ΔT °C	ΔT °F
Winter DTDh	22	-21	43	78
Summer DTDc	24	31	7	13

5.2.3.1 Heat Loss due to Air Leakage

$$HL_{airb} = LR_{airh} \times \frac{V_b}{3.6} \times DTD_h \times 1.2$$

0.361 x 261.03 x 43 °C x 1.2 = 4892 W
= 16691 Btu/h

6.2.6 Sensible Gain due to Air Leakage

$$HG_{salb} = LR_{airc} \times \frac{V_b}{3.6} \times DTD_c \times 1.2$$

= 0.113 x 261.03 x 7 °C x 1.2 = 251 W
= 857 Btu/h

5.2.3.2 Heat Loss due to Mechanical Ventilation

$$HL_{vairb} = PVC \times DTD_h \times 1.08 \times (1 - E)$$

80 CFM x 78 °F x 1.08 x 0.25 = 1670 Btu/h

6.2.7 Sensible heat Gain due to Ventilation

$$HL_{vairb} = PVC \times DTD_h \times 1.08 \times (1 - E)$$

80 CFM x 13 °F x 1.08 x 0.25 = 275 Btu/h

5.2.3.3 Calculation of Air Change Heat Loss for Each Room (Floor Multiplier Section)

$$HL_{airr} = \text{Level Factor} \times HL_{airbv} \times \{(HL_{agcr} + HL_{bgcr}) \div (HL_{agclevel} + HL_{bgclevel})\}$$

Level	Level Factor (LF)	HLairve Air Leakage + Ventilation Heat Loss (Btu/h)	Level Conductive Heat Loss: (HL _{clevel})	Air Leakage Heat Loss Multiplier (LF x HLairbv / HLlevel)
1	0.5	16,691	8,076	1.033
2	0.3		13,012	0.385
3	0.2		11,269	0.296
4	0		0	0.000
5	0		0	0.000

*HLairbv = Air leakage heat loss + ventilation heat loss

*For a balanced or supply only ventilation system HLairve = 0

 City of Richmond Hill
Building Division

HVAC REVIEWED

Initials: **PXV**

HEAT LOSS AND GAIN SUMMARY SHEET

MODEL: PINETREE 1

SFQT: 2366

LO# 90731

BUILDER: GREENPARK HOMES

SITE: ROUNDEL HOMES INC

DESIGN ASSUMPTIONS

HEATING	°F	COOLING	°F
OUTDOOR DESIGN TEMP.	-6	OUTDOOR DESIGN TEMP.	88
INDOOR DESIGN TEMP.	72	INDOOR DESIGN TEMP. (MAX 75°F)	75

BUILDING DATA

ATTACHMENT:	DETACHED	# OF STORIES (+BASEMENT):	3
FRONT FACES:	EAST	ASSUMED (Y/N):	Y
AIR CHANGES PER HOUR:	3.57	ASSUMED (Y/N):	Y
AIR TIGHTNESS CATEGORY:	AVERAGE	ASSUMED (Y/N):	Y
WIND EXPOSURE:	SHELTERED	ASSUMED (Y/N):	Y
HOUSE VOLUME (ft³):	33185.0	ASSUMED (Y/N):	Y
INTERNAL SHADING:	BLINDS/CURTAINS	ASSUMED OCCUPANTS:	5
INTERIOR LIGHTING LOAD (Btu/h/ft²):	1.27	DC BRUSHLESS MOTOR (Y/N):	Y
FOUNDATION CONFIGURATION	BCIN_1	DEPTH BELOW GRADE:	6.0 ft
LENGTH: 47.0 ft	WIDTH: 33.0 ft	EXPOSED PERIMETER:	160.0 ft

2012 OBC - COMPLIANCE PACKAGE

Component

Compliance Package A1

Nominal Min. Eff.

Ceiling with Attic Space Minimum RSI (R)-Value	60	59.22
Ceiling Without Attic Space Minimum RSI (R)-Value	31	27.65
Exposed Floor Minimum RSI (R)-Value	31	29.80
Walls Above Grade Minimum RSI (R)-Value	22	17.03
Basement Walls Minimum RSI (R)-Value	20 ci	21.12
Below Grade Slab Entire surface > 600 mm below grade Minimum RSI (R)-Value	-	-
Edge of Below Grade Slab ≤ 600 mm Below Grade Minimum RSI (R)-Value	10	10
Heated Slab or Slab ≤ 600 mm below grade Minimum RSI (R)-Value	10	11.13
Windows and Sliding Glass Doors Maximum U-Value	0.28	-
Skylights Maximum U-Value	0.49	-
Space Heating Equipment Minimum AFUE	96%	-
HRV Minimum Efficiency	75%	-
Domestic Hot Water Heater Minimum EF	0.8	-

INDIVIDUAL BCIN: 19669

MICHAEL O'ROURKE



CITY OF RICHMOND HILL
BUILDING DIVISION


09/22/2022

RECEIVED

Per: joshua.nabua

Residential Foundation Thermal Load Calculator

Supplemental tool for CAN/CSA-F280

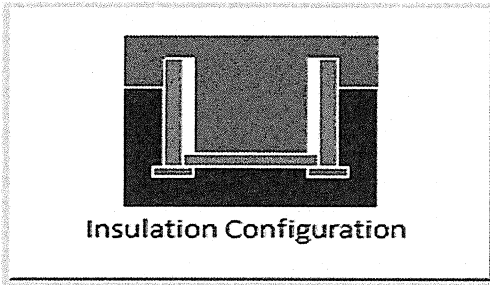Weather Station Description		
Province:	Ontario	
Region:	Richmond Hill	
Site Description		
Soil Conductivity:	Normal conductivity: dry sand, loam, clay	
Water Table:	Normal (7-10 m, 23-33 ft)	
Foundation Dimensions		
Floor Length (m):	14.3	 Insulation Configuration
Floor Width (m):	10.1	
Exposed Perimeter (m):	0.0	
Wall Height (m):	2.7	
Depth Below Grade (m):	1.83	
Window Area (m ²):	2.0	
Door Area (m ²):	0.0	
Radiant Slab		
Heated Fraction of the Slab:	0	
Fluid Temperature (°C):	33	
Design Months		
Heating Month	1	
Foundation Loads		
Heating Load (Watts):		1588

TYPE: PINETREE 1
LO# 90731CITY OF RICHMOND HILL
BUILDING DIVISION

09/22/2022

RECEIVED

Per: joshua.nabua

Air Infiltration Residential Load Calculator

Supplemental tool for CAN/CSA-F280


Weather Station Description				
Province:	Ontario			
Region:	Richmond Hill			
Weather Station Location:	Open flat terrain, grass			
Anemometer height (m):	10			
Local Shielding				
Building Site:	Suburban, forest			
Walls:	Heavy			
Flue:	Heavy			
Highest Ceiling Height (m):	7.92			
Building Configuration				
Type:	Detached			
Number of Stories:	Two			
Foundation:	Full			
House Volume (m ³):	939.7			
Air Leakage/Ventilation				
Air Tightness Type:	Present (1961-) (3.57 ACH)			
Custom BDT Data:	ELA @ 10 Pa.	1252.6 cm ²		
	3.57	ACH @ 50 Pa		
Mechanical Ventilation (L/s):	Total Supply	Total Exhaust		
	37.5	37.5		
Flue Size				
Flue #:	#1	#2	#3	#4
Diameter (mm):	0	0	0	0
Natural Infiltration Rates				
Heating Air Leakage Rate (ACH/H):	0.361			
Cooling Air Leakage Rate (ACH/H):	0.113			

TYPE: PINETREE 1
LO# 90731CITY OF RICHMOND HILL
BUILDING DIVISION

09/22/2022

RECEIVED

Per: joshua.nabua

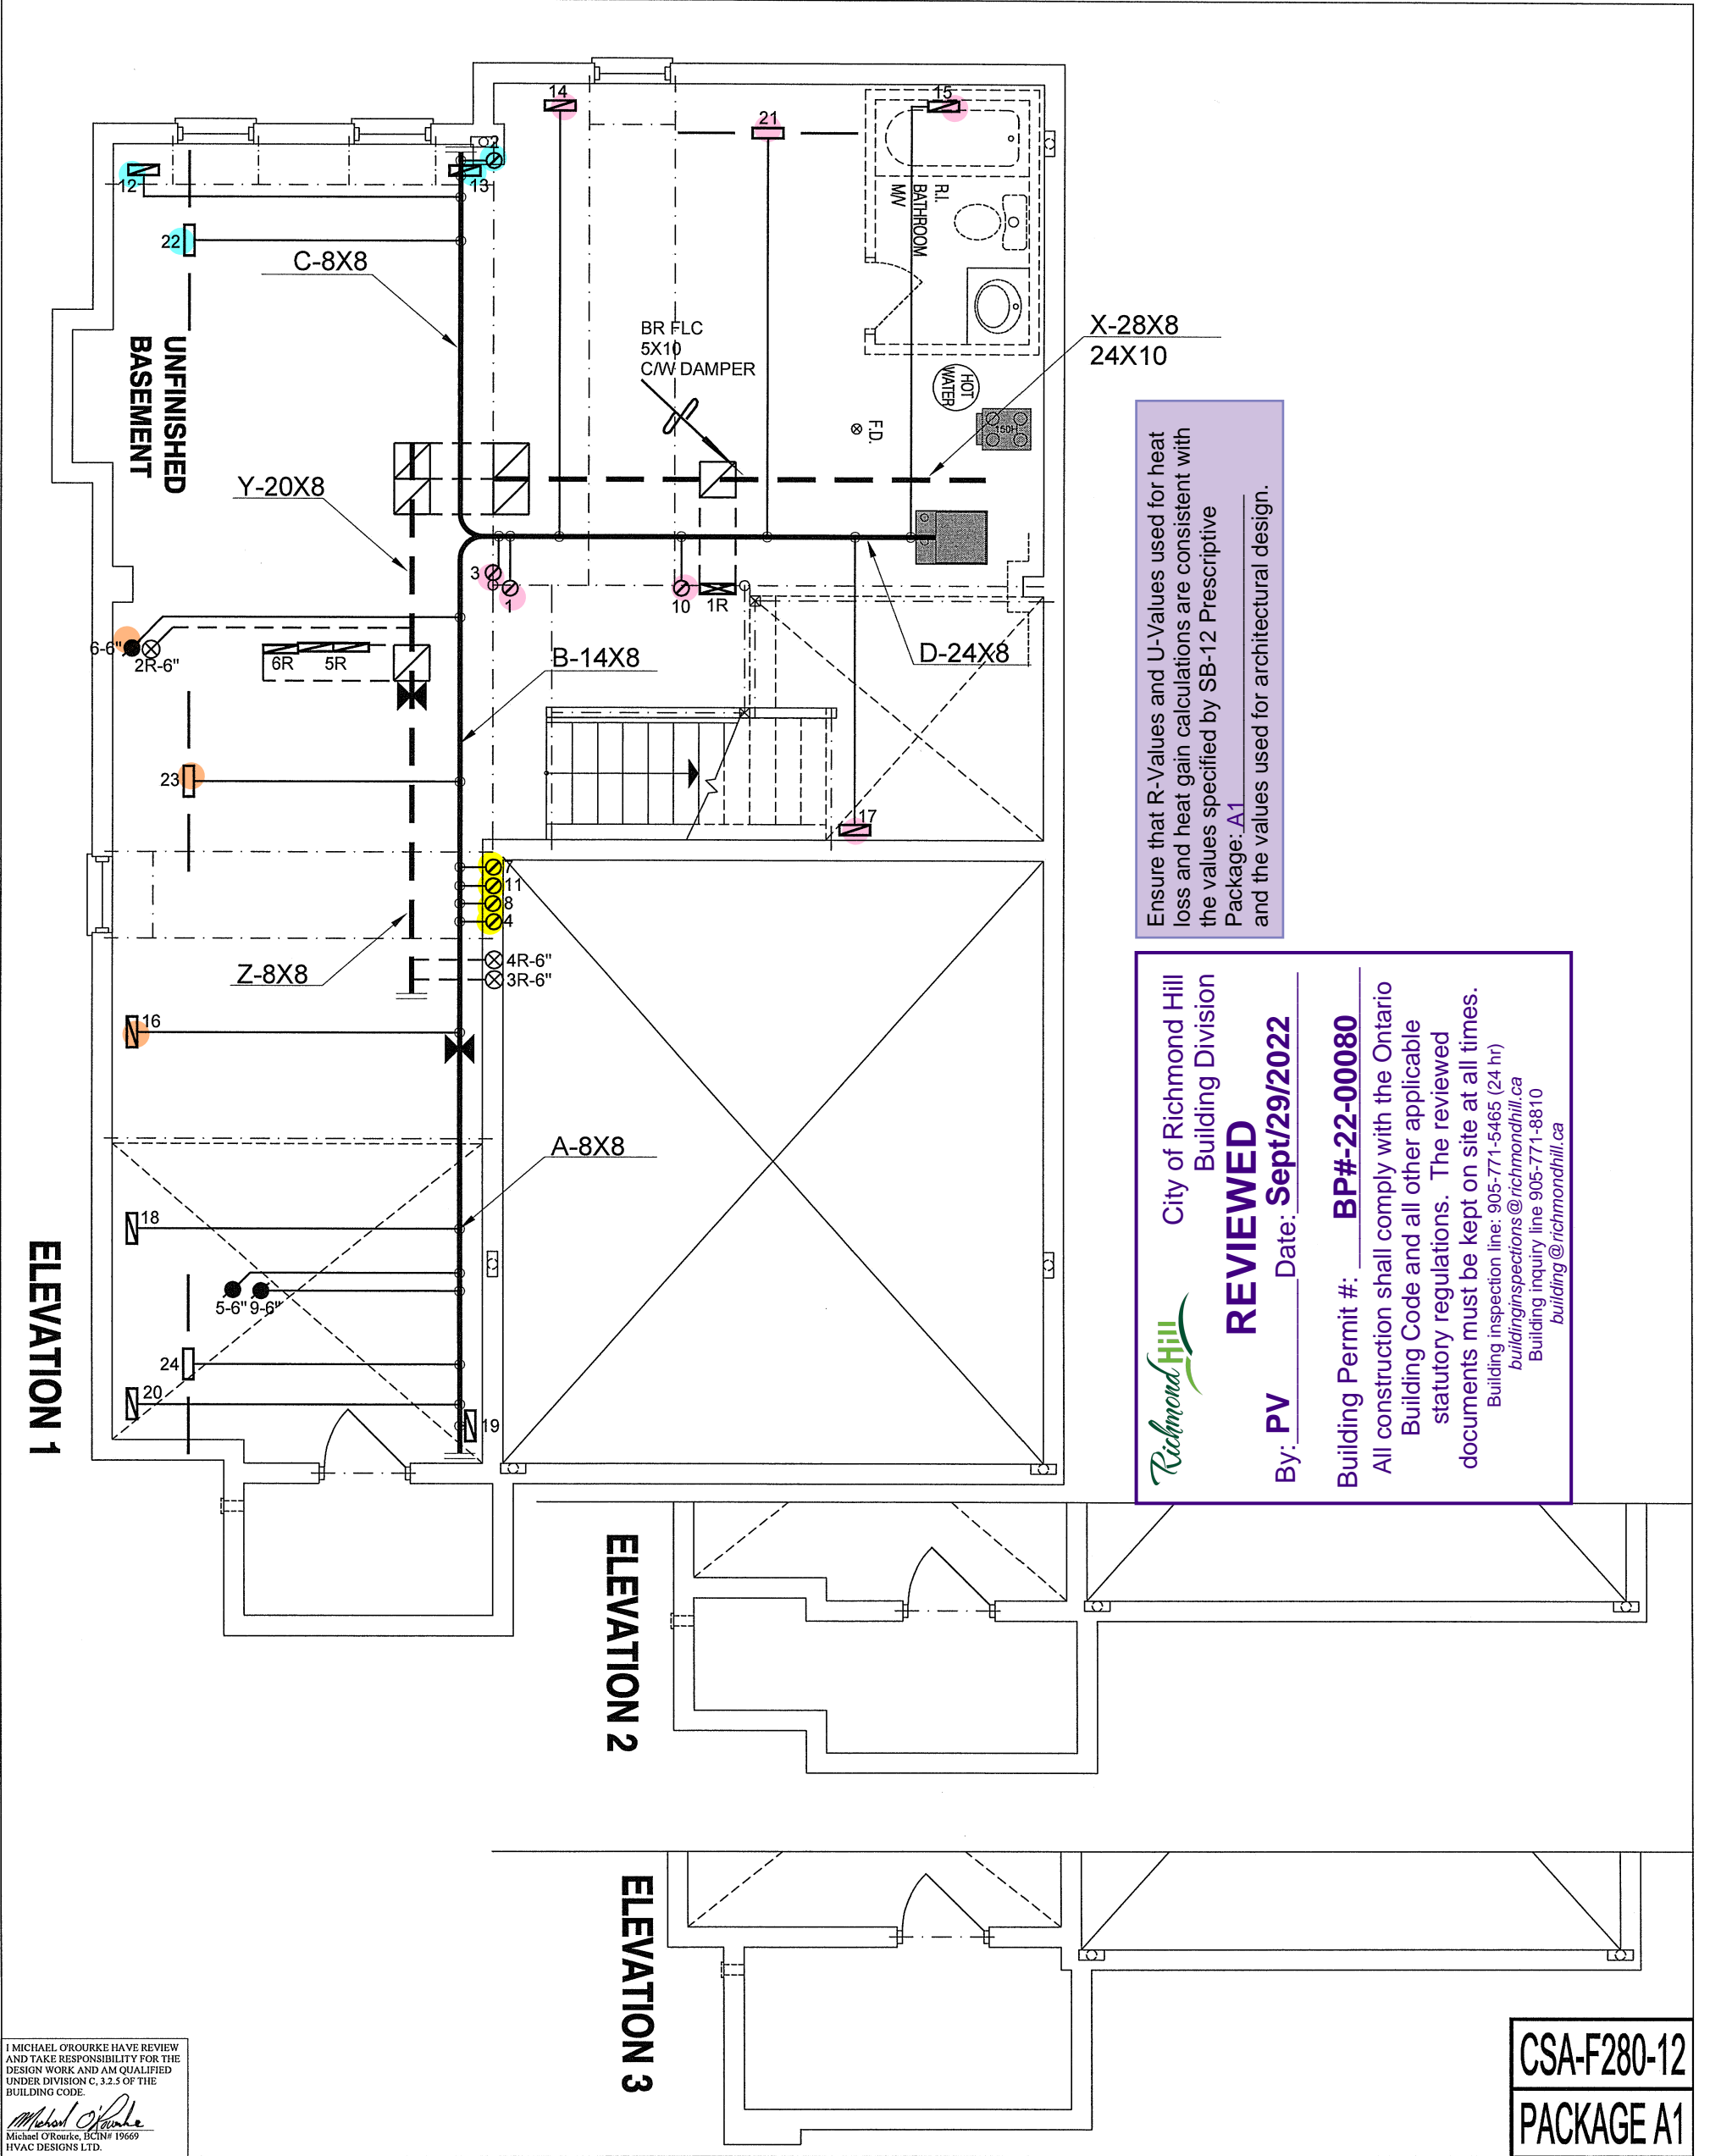


I MICHAEL O'ROURKE HAVE REVIEWED AND TAKE RESPONSIBILITY FOR THE DESIGN WORK AND AM QUALIFIED UNDER DIVISION C, 3.2.5 OF THE BUILDING CODE.

Michael O'Rourke
Michael O'Rourke, BCIN# 19669
HVAC DESIGNS LTD.

HVAC LEGEND							3.		
SYMBOL	DESCRIPTION	SYMBOL	DESCRIPTION	SYMBOL	DESCRIPTION	SYMBOL	DESCRIPTION	2.	
	SUPPLY AIR GRILLE		6" SUPPLY AIR BOOT ABOVE		14"x8" RETURN AIR GRILLE		RETURN AIR STACK ABOVE	1.	
	SUPPLY AIR GRILLE 6" BOOT		SUPPLY AIR STACK FROM 2nd FLOOR		30"x8" RETURN AIR GRILLE		RETURN AIR STACK 2nd FLOOR	No.	Description
	SUPPLY AIR BOOT ABOVE		6" SUPPLY AIR STACK 2nd FLOOR		FRA- FLOOR RETURN AIR GRILLE		REDUCER	REVISIONS	

ALL DRAWINGS, CALCULATIONS AND SPECIFICATIONS ARE THE PROPERTY OF HVAC DESIGNS LTD.© AND MAY NOT BE REPRODUCED, MODIFIED OR ALTERED WITHOUT EXPRESSED WRITTEN CONSENT. THE DRAWINGS ARE DATED AND USE OF THESE DRAWINGS AFTER ONE YEAR FROM THE DATED NOTED IS NOT AUTHORIZED. CONTRACTOR SHALL CHECK ALL CONDITIONS BEFORE PROCEEDING WITH WORK. LATEST MUNICIPAL APPROVED DRAWINGS ONLY TO BE USED DURING INSTALLATION OF HEATING SYSTEM. HVAC DESIGNS LTD. IS NOT LIABLE FOR ANY CLAIMS ARISING FROM UNAUTHORIZED USE OF THE DRAWINGS OR FROM ANY CHANGES TO ACCEPTED STANDARDS AND/OR THE ONTARIO BUILDING CODE.

Client	<div><div>375 Finley Ave. Suite 202 - Ajax, Ontario L1S 2E2 Tel. 905.619.2300 - 905.420.5300 Fax 905.619.2375 Email: info@hvacdesigns.ca Web: www.hvacdesigns.ca Specializing in Residential Mechanical Design Services</div></div>	HEAT LOSS 51431 BTU/H	# OF RUNS S/A R/A FANS			Sheet Title	
GREENPARK HOMES		UNIT DATA	3RD FLOOR			BASEMENT HEATING LAYOUT CITY OF RICHMOND HILL BUILDING DIVISION Date MAY/2021 Scale 3/16" = 1'-0" BCIN# 19669 LO# 90731 RECEIVED	
Project Name		MAKE GOODMAN	2ND FLOOR	11	4		3
ROUNDEL HOMES INC RICHMOND HILL, ONTARIO		MODEL GMEC960603BNA	1ST FLOOR	9	2		3
		INPUT 60 MBTU/H	BASEMENT	4	1	0	
		OUTPUT 57.6 MBTU/H	ALL S/A DIFFUSERS 4 "x10" UNLESS NOTED OTHERWISE ON LAYOUT. ALL S/A RUNS 5"Ø UNLESS NOTED OTHERWISE ON LAYOUT. UNDERCUT DOORS 1" min. FOR R/A				
		COOLING 2.5 TONS					
		FAN SPEED 928 cfm @ 0.6" w.c.					
PINETREE 1 2366 sqft	Installation to comply with the latest Ontario Building Code. All supply branch outlets shall be equipped with a manual balancing damper. Ductwork which passes through the garage or unheated spaces shall be adequately insulated and be gas-proofed.						

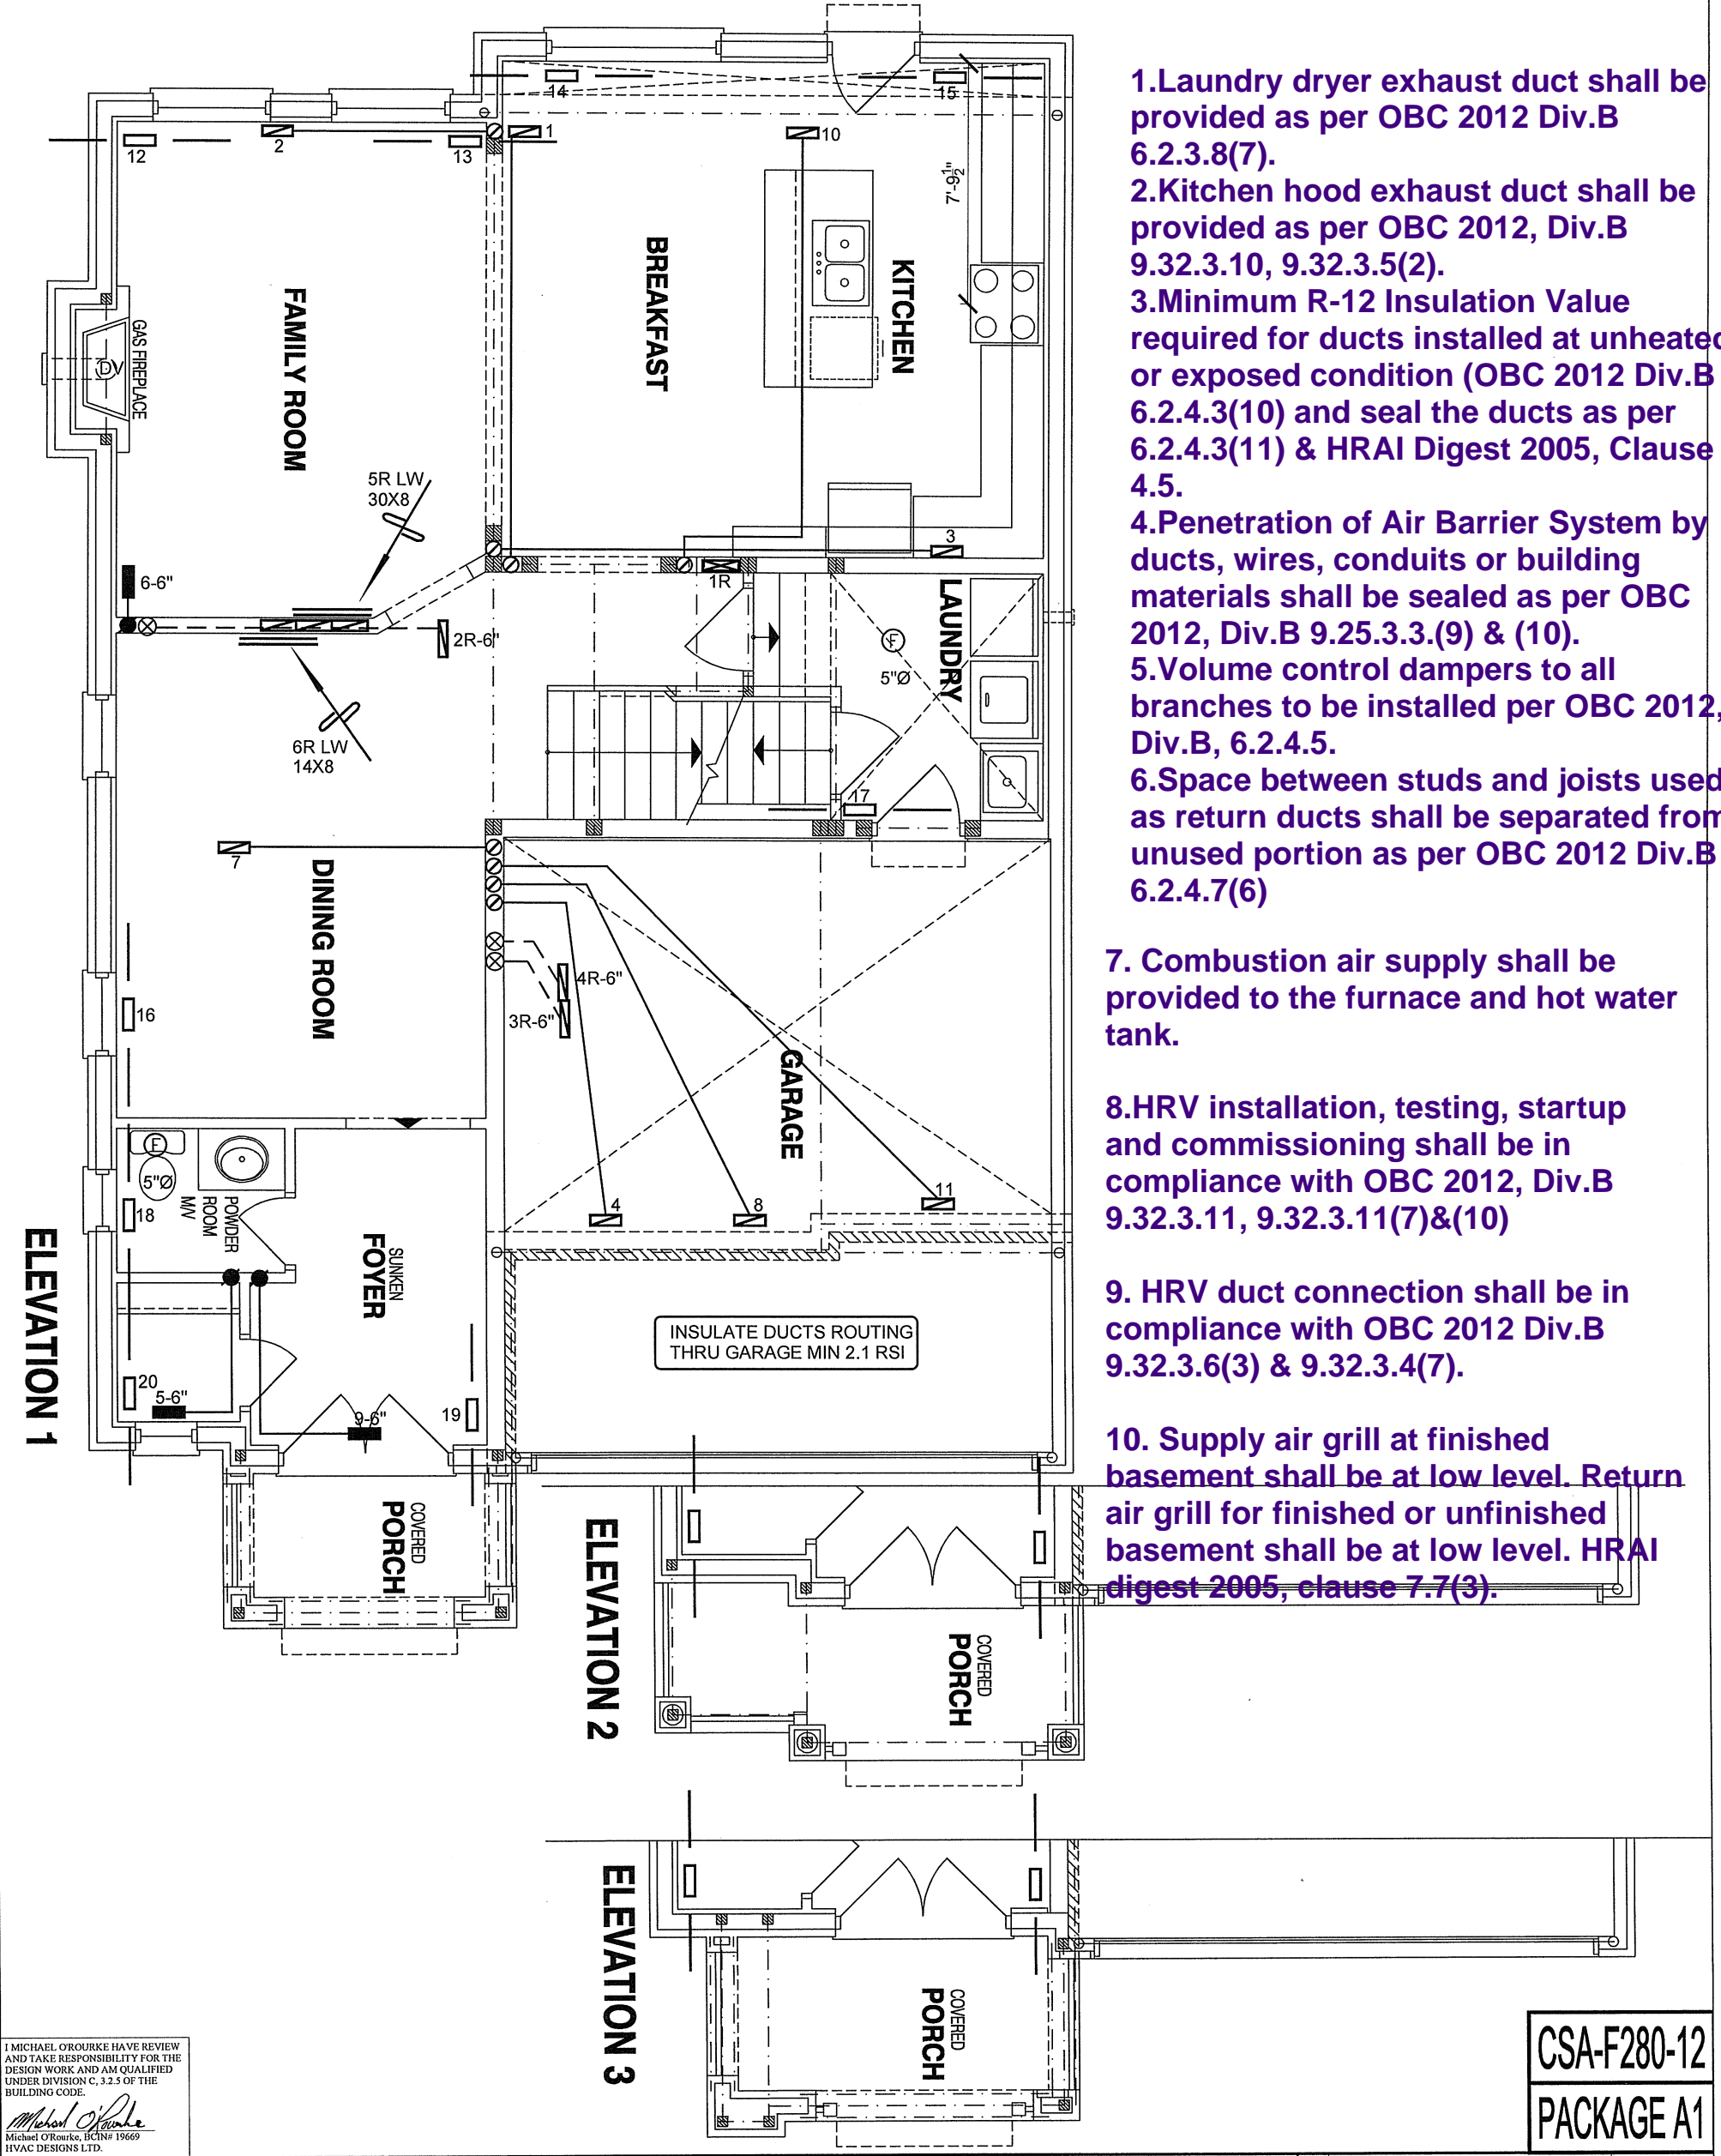

- 1.Laundry dryer exhaust duct shall be provided as per OBC 2012 Div.B 6.2.3.8(7).
- 2.Kitchen hood exhaust duct shall be provided as per OBC 2012, Div.B 9.32.3.10, 9.32.3.5(2).
- 3.Minimum R-12 Insulation Value required for ducts installed at unheated or exposed condition (OBC 2012 Div.B 6.2.4.3(10) and seal the ducts as per 6.2.4.3(11) & HRAI Digest 2005, Clause 4.5.
- 4.Penetration of Air Barrier System by ducts, wires, conduits or building materials shall be sealed as per OBC 2012, Div.B 9.25.3.3.(9) & (10).
- 5.Volume control dampers to all branches to be installed per OBC 2012, Div.B, 6.2.4.5.
- 6.Space between studs and joists used as return ducts shall be separated from unused portion as per OBC 2012 Div.B 6.2.4.7(6)
7. Combustion air supply shall be provided to the furnace and hot water tank.
- 8.HRV installation, testing, startup and commissioning shall be in compliance with OBC 2012, Div.B 9.32.3.11, 9.32.3.11(7)&(10)
9. HRV duct connection shall be in compliance with OBC 2012 Div.B 9.32.3.6(3) & 9.32.3.4(7).
10. Supply air grill at finished basement shall be at low level. Return air grill for finished or unfinished basement shall be at low level. HRAI digest 2005, clause 7.7(3).

I MICHAEL O'ROURKE HAVE REVIEW AND TAKE RESPONSIBILITY FOR THE DESIGN WORK AND AM QUALIFIED UNDER DIVISION C, 3.2.5 OF THE BUILDING CODE.

Michael O'Rourke
Michael O'Rourke, BCIN# 19669
HVAC DESIGNS LTD.

CSA-F280-12
PACKAGE A1

HVAC LEGEND							3.		
SYMBOL	DESCRIPTION	SYMBOL	DESCRIPTION	SYMBOL	DESCRIPTION	SYMBOL	DESCRIPTION	2.	
	SUPPLY AIR GRILLE		6" SUPPLY AIR BOOT ABOVE		14"x8" RETURN AIR GRILLE		RETURN AIR STACK ABOVE	1.	
	SUPPLY AIR GRILLE 6" BOOT		SUPPLY AIR STACK FROM 2nd FLOOR		30"x8" RETURN AIR GRILLE		RETURN AIR STACK 2nd FLOOR	No.	Description Date
	SUPPLY AIR BOOT ABOVE		6" SUPPLY AIR STACK 2nd FLOOR		FRA- FLOOR RETURN AIR GRILLE		REDUCER	REVISIONS	

ALL DRAWINGS, CALCULATIONS AND SPECIFICATIONS ARE THE PROPERTY OF HVAC DESIGNS LTD.© AND MAY NOT BE REPRODUCED, MODIFIED OR ALTERED WITHOUT EXPRESSED WRITTEN CONSENT. THE DRAWINGS ARE DATED AND USE OF THESE DRAWINGS AFTER ONE YEAR FROM THE DATED NOTED IS NOT AUTHORIZED. CONTRACTOR SHALL CHECK ALL CONDITIONS BEFORE PROCEEDING WITH WORK. LATEST MUNICIPAL APPROVED DRAWINGS ONLY TO BE USED DURING INSTALLATION OF HEATING SYSTEM. HVAC DESIGNS LTD. IS NOT LIABLE FOR ANY CLAIMS ARISING FROM UNAUTHORIZED USE OF THE DRAWINGS OR FROM ANY CHANGES TO ACCEPTED STANDARDS AND/OR THE ONTARIO BUILDING CODE.

Client

GREENPARK HOMES

Project Name

ROUNDEL HOMES INC
RICHMOND HILL, ONTARIO

PINETREE 1

2366 sqft

HVACDESIGNS LTD.

375 Finley Ave. Suite 202 - Ajax, Ontario
L1S 2E2 Tel. 905.619.2300 - 905.420.5300 Fax 905.619.2375
Email: info@hvacdsgns.ca
Web: www.hvacdsgns.ca
Specializing in Residential Mechanical Design Services

Installation to comply with the latest Ontario Building Code. All supply branch outlets shall be equipped with a manual balancing damper. Ductwork which passes through the garage or unheated spaces shall be adequately insulated and be gas-proofed.

Sheet Title

FIRST FLOOR
HEATING
LAYOUT

CITY OF RICHMOND HILL
BUILDING DIVISION

Date

MAY/2021

Scale


3/16" = 1'-0"

BCIN# 19669



LO#

90731

Per: joshua.nabua

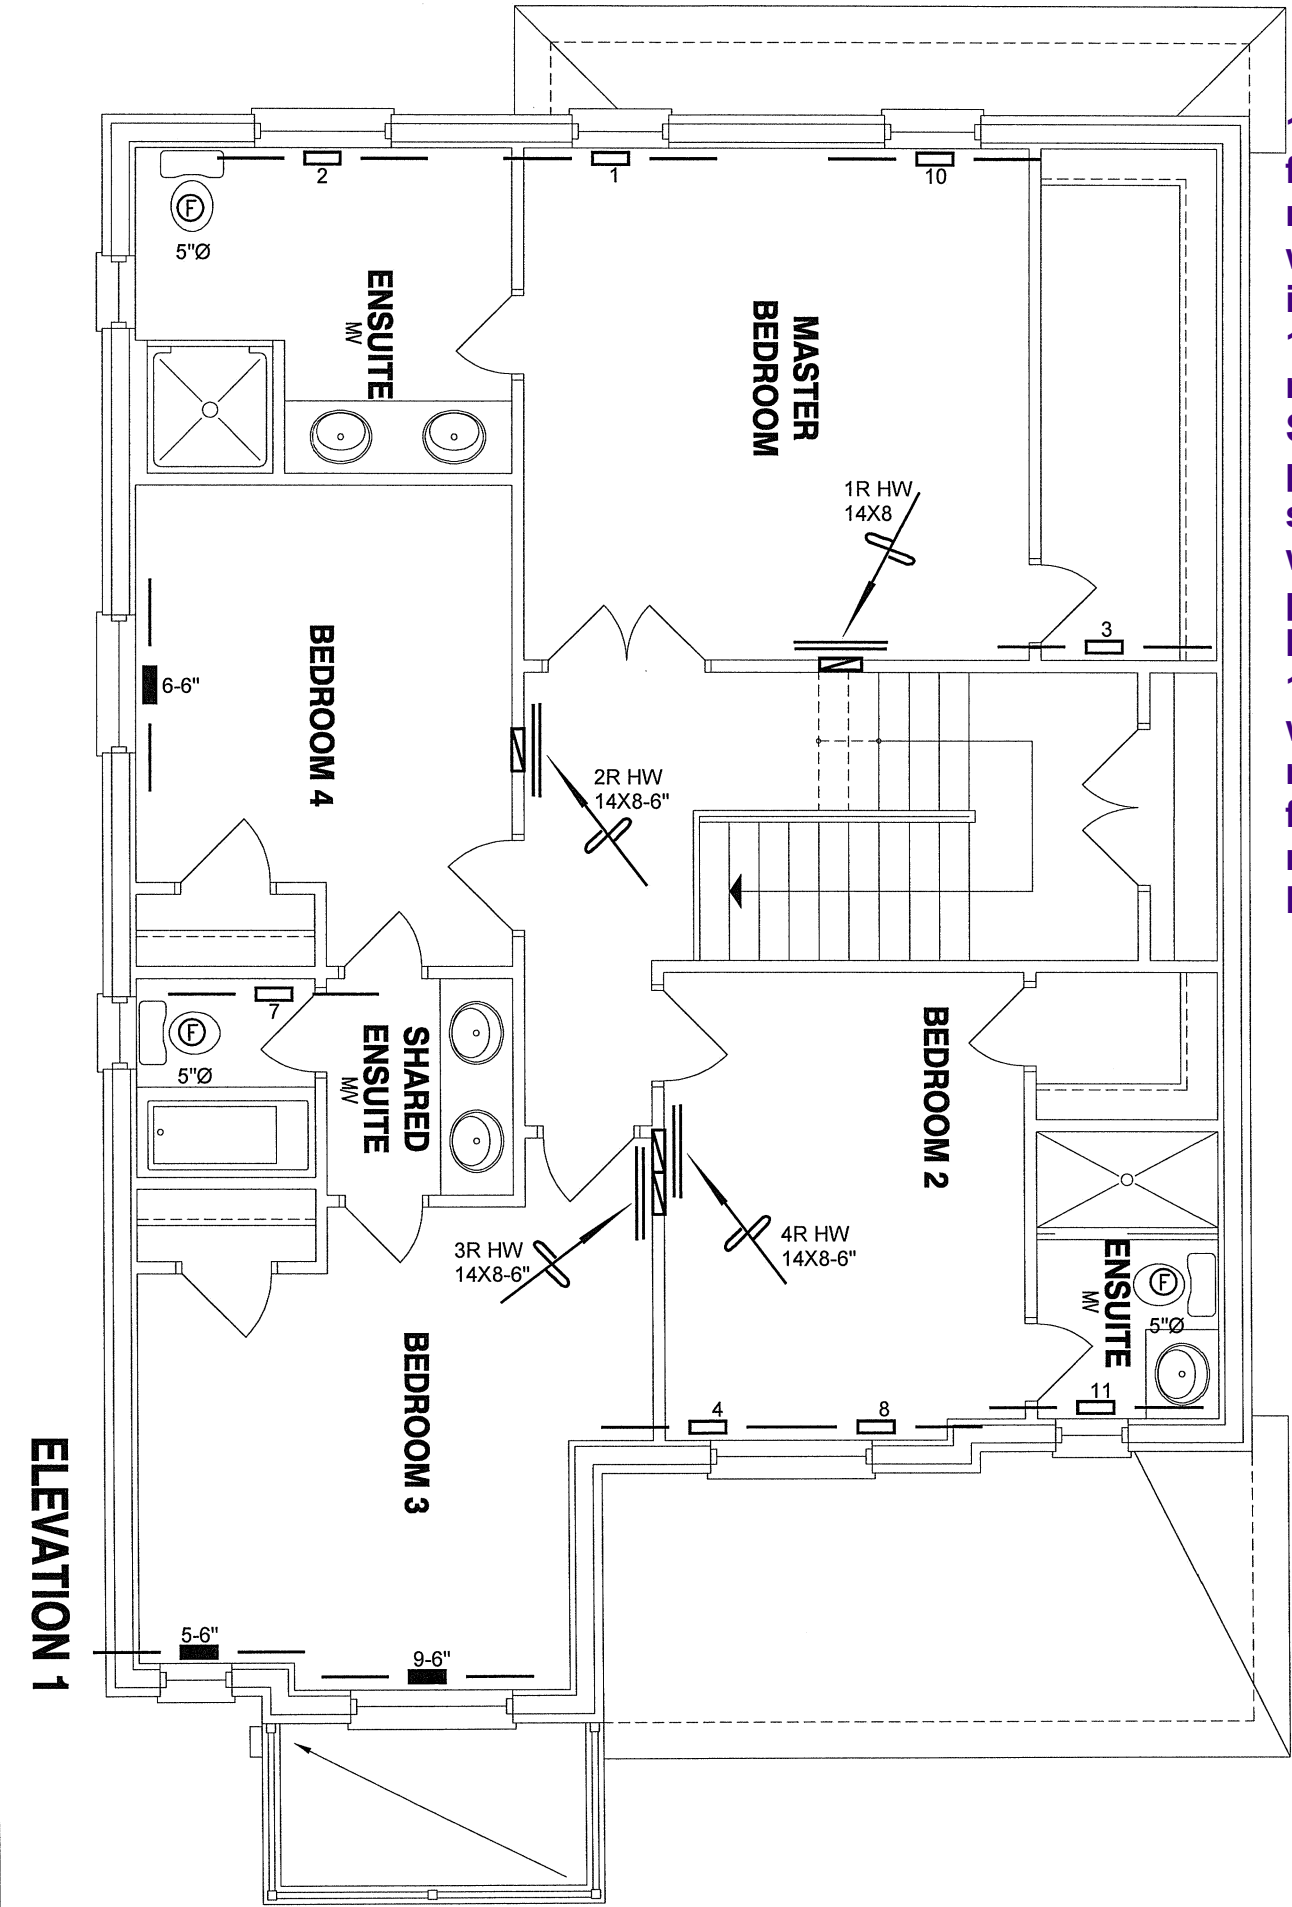

- 13.Exterior insulation effective R-Value for wall, roof or exposed floor shall be maintained at the respective location where duct or sanitary pipes are routed inside exterior envelope.
14. Return air intake shall be provided as recommended in HRAI Digest 2005 Section 4.7 Return air inlet should be positioned so that short circuiting of supply air is avoided. A high and low wall return air combination shall be provided when a combined cooling & heating system is installed.
15. For simplified HRV/ERV installation, with stale air and fresh air connected to return air plenum, stale air intake and fresh air supply shall be separated minimum 3' or as recommended by HRV/ERV Manufacturer.

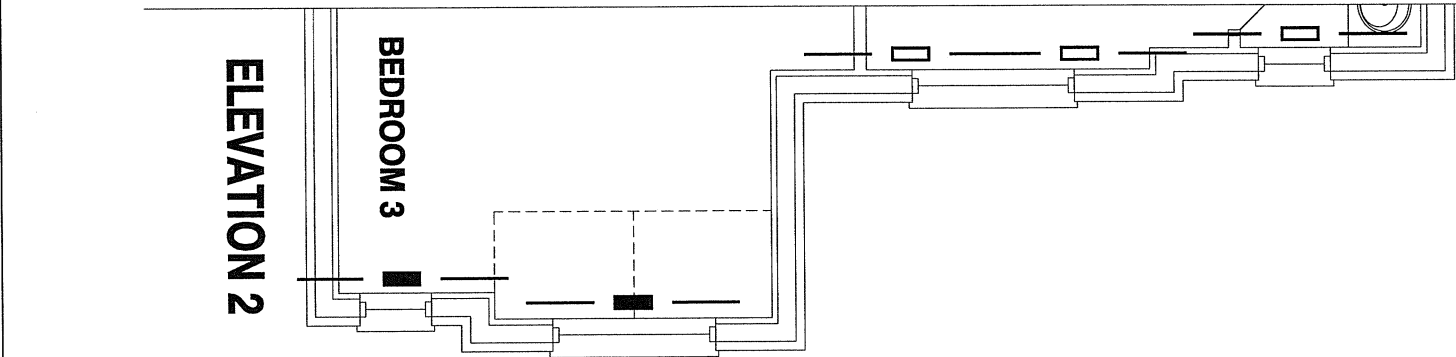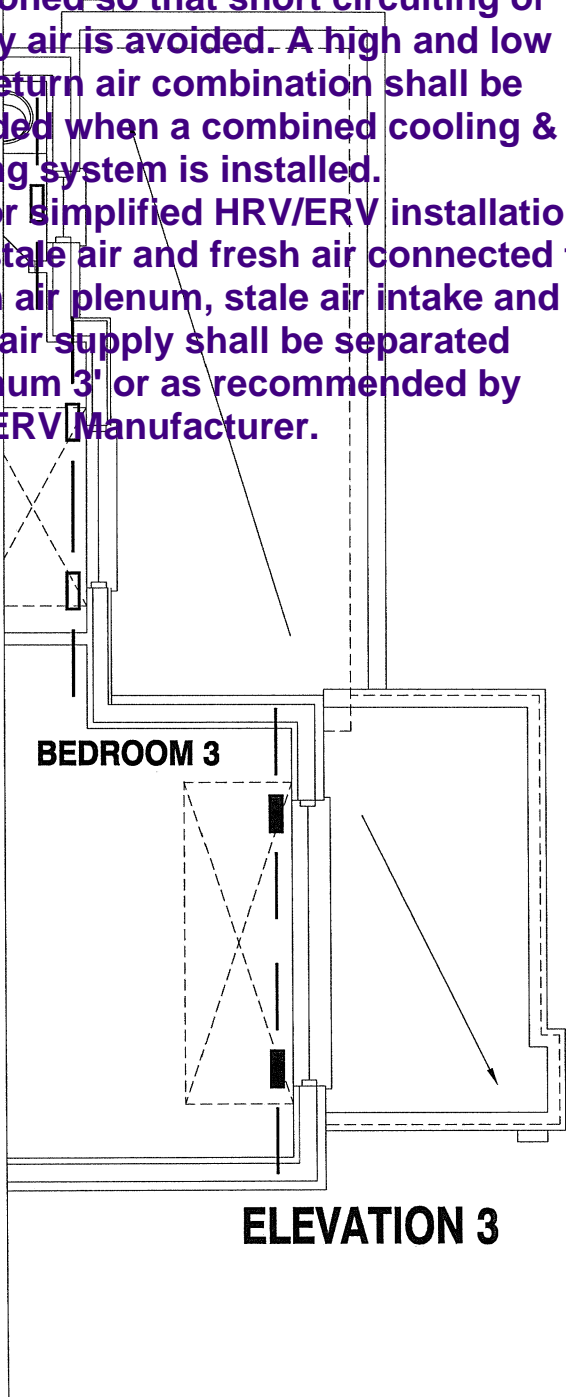

Richmond Hill City of Richmond Hill Building Division

HVAC REVIEWED

Initials: PXV

I MICHAEL O'ROURKE HAVE REVIEW AND TAKE RESPONSIBILITY FOR THE DESIGN WORK AND AM QUALIFIED UNDER DIVISION C, 3.2.5 OF THE BUILDING CODE.

Michael O'Rourke
Michael O'Rourke, BCIN# 19669
HVAC DESIGNS LTD.

CSA-F280-12
PACKAGE A1

HVAC LEGEND								3.		
SYMBOL	DESCRIPTION	SYMBOL	DESCRIPTION	SYMBOL	DESCRIPTION	SYMBOL	DESCRIPTION	2.		
	SUPPLY AIR GRILLE		6" SUPPLY AIR BOOT ABOVE		14"x8" RETURN AIR GRILLE		RETURN AIR STACK ABOVE	1.		
	SUPPLY AIR GRILLE 6" BOOT		SUPPLY AIR STACK FROM 2nd FLOOR		30"x8" RETURN AIR GRILLE		RETURN AIR STACK 2nd FLOOR	No.	Description	Date
	SUPPLY AIR BOOT ABOVE		6" SUPPLY AIR STACK 2nd FLOOR		FRA- FLOOR RETURN AIR GRILLE		REDUCER	REVISIONS		

ALL DRAWINGS, CALCULATIONS AND SPECIFICATIONS ARE THE PROPERTY OF HVAC DESIGNS LTD.© AND MAY NOT BE REPRODUCED, MODIFIED OR ALTERED WITHOUT EXPRESSED WRITTEN CONSENT. THE DRAWINGS ARE DATED AND USE OF THESE DRAWINGS AFTER ONE YEAR FROM THE DATED NOTED IS NOT AUTHORIZED. CONTRACTOR SHALL CHECK ALL CONDITIONS BEFORE PROCEEDING WITH WORK. LATEST MUNICIPAL APPROVED DRAWINGS ONLY TO BE USED DURING INSTALLATION OF HEATING SYSTEM. HVAC DESIGNS LTD. IS NOT LIABLE FOR ANY CLAIMS ARISING FROM UNAUTHORIZED USE OF THE DRAWINGS OR FROM ANY CHANGES TO ACCEPTED STANDARDS AND/OR THE ONTARIO BUILDING CODE.

Client

GREENPARK HOMES

Project Name

ROUNDEL HOMES INC
RICHMOND HILL, ONTARIO

PINETREE 1

2366 sqft

HVACDESIGNS LTD.

375 Finley Ave. Suite 202 - Ajax, Ontario
L1S 2E2 Tel. 905.619.2300 - 905.420.5300 Fax 905.619.2375
Email: info@hvacdsgns.ca
Web: www.hvacdesigns.ca
Specializing in Residential Mechanical Design Services

Installation to comply with the latest Ontario Building Code. All supply branch outlets shall be equipped with a manual balancing damper. Ductwork which passes through the garage or unheated spaces shall be adequately insulated and be gas-proofed.

Sheet Title

SECOND FLOOR
HEATING
LAYOUT

CITY OF RICHMOND HILL
BUILDING DIVISION

Date
MAY/2021

Scale
3/16" = 1'-0"
BCIN# 19669

LO# 90731

Per: joshua.nabua