

CONSTRUCTION SUMMARY

Red Oaks - Roundel Homes Inc.

PURCHASER: Zhao LIN

TEL: RES.: 647-620-6266

LOT / PHASE 108 / 1	REG. PLAN # 65M-4737	HOUSE TYPE Terracotta 1 (4 Bedroom) Elev 3		
------------------------	-------------------------	---	--	--

CABINETRY ACCESSORIES

1 - KITCHEN BASE CABINETRY – BAR FRIDGE PROVISION *** DOES NOT INCLUDE ELECTRICA PLUG - PURCHASER WILL SUPPLY ELECTRICAL AFTER CLOSING*** 06Dec22 Note:	
1 - KITCHEN CABINETRY UPPER - FULL DEPTH ABOVE FRIDGE - WITH GABLES - 600MM - STANDARD LEVEL CABINETRY 06Dec22 Note: PURCHASER HAS DECLINED OPTION TO PURCHASE THE UPGRADED 600MM FULL DEPTH PANTRY. PANTRY TO REMAIN AT VENDORS STANDARD 300MM DEPTH.	
1 - KITCHEN CABINETRY - BUILT-IN MICROWAVE/OVEN COMBO - STANDARD LEVEL CABINETRY *NEXT TO FRIDGE 06Dec22 Note:	

ELECTRICAL

1 - PLUG - ELECTRICAL PLUG WITH GFI AND SWITCH - FOR FESTIVE LIGHTING 06Dec22 Note:	
1 - PLUG - ELECTRICAL PLUG - TO BE INSTALLED OVER FIREPLACE 06Dec22 Note:	
1 - RELOCATE STANDARD KITCHEN LIGHT TO BE CENTERED OVER ISLAND 06Dec22 Note:	
1 - BUILT IN OVEN /MICRO PROVISION - PROVISION ONLY - ELECTRICAL ONLY NEXT TO FRIDGE 06Dec22 Note:	

FIREPLACE AND ACCESSORIES

1 - GAS LINE ROUGH-IN FOR STOVE (INCLUDES ELECTRICAL OUTLET) - FIRST FLOOR 06Dec22 Note:	
---	--

HEATING AND AIR CONDITIONING

1 - HUMIDIFER 06Dec22 Note:	
--------------------------------	--

MIRRORS AND GLASS

1 - SHOWER DOOR HANDLE - CHROME D-RING/TOWEL BAR COMBO MASTER ENSUITE 06Dec22 Note:	
1 - FRAMELESS GLASS SHOWER DOOR - INCLUDES CHROME HINGES MASTER ENSUITE 06Dec22 Note:	

PLUMBING

1 - WATER LINE FOR FRIDGE - ROUGH-IN ONLY 06Dec22 Note:	
--	--

PROMOTIONAL



CONSTRUCTION SUMMARY

Red Oaks - Roundel Homes Inc.

PURCHASER: Zhao LIN

TEL: RES.: 647-620-6266



LOT / PHASE 108 / 1	REG. PLAN # 65M-4737	HOUSE TYPE Terracotta 1 (4 Bedroom) Elev 3		
------------------------	-------------------------	---	--	--

1 - LESS CREDIT FROM PURCHASER EXTRA SHEET IN OFFER

06Dec22 Note:

This Document is Extremely Time Sensitive - Printed 8 Dec 22 at 9:54

ELEV. 2 • 3,281 sq.ft. | ELEV. 3 • 3,277 sq.ft.

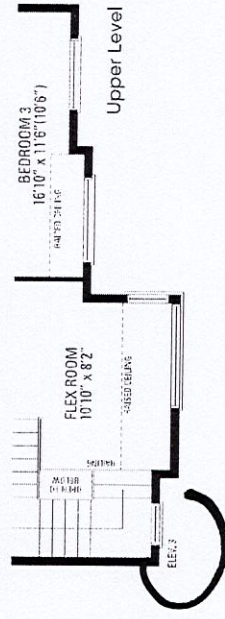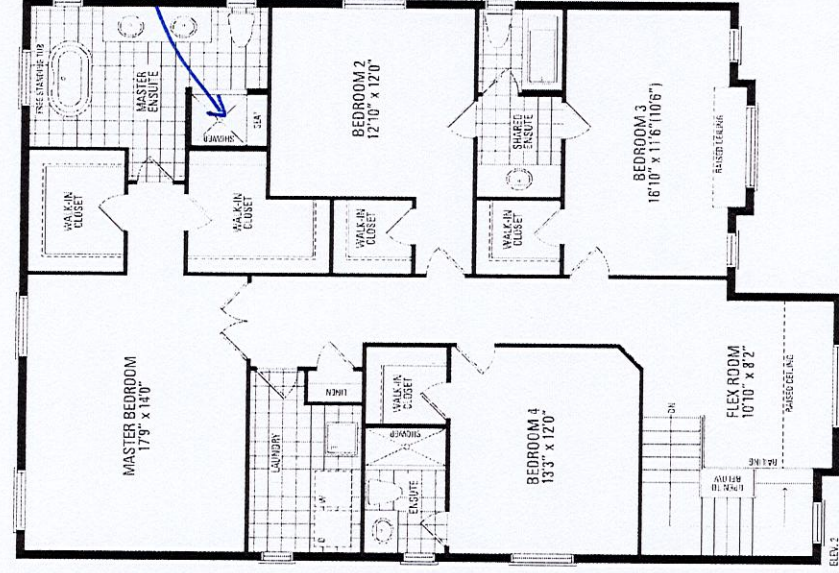

* HUMIDIFIER