

CONSTRUCTION SUMMARY

Hazel Glenn - Barlassina Construction Inc.

PURCHASERS: Sunil MADHOTRA and Sandeep MADHOTRA TEL: RES.: 647-287-8025

LOT / PHASE 66 / 1	REG. PLAN #	HOUSE TYPE Garden 3 Elev 1		
-----------------------	-------------	-------------------------------	--	--

CONSTRUCTION

3 - ENLARGE BASEMENT WINDOWS (MAY REQUIRE WINDOW WELLS) - WINDOW IS 30 INCHES X 24 INCHES 01Dec22 Note:	
1 - FIRST FLOOR INCREASE CEILING HEIGHT FROM 9 FEET TO 10 FEET 01Dec22 Note:	

PROMOTIONAL


1 - LESS BALANCE OF CREDIT FROM PURCHASER EXTRA SHEET IN OFFER 01Dec22 Note:	
---	--

This Document is Extremely Time Sensitive - Printed 12 Dec 22 at 8:56

Lot 66 BARLASSINA


Garden 3

ELEVATION 1 & 2 - 2,400 sq.ft. • ELEVATION 3 - 2,415 SQ.FT.

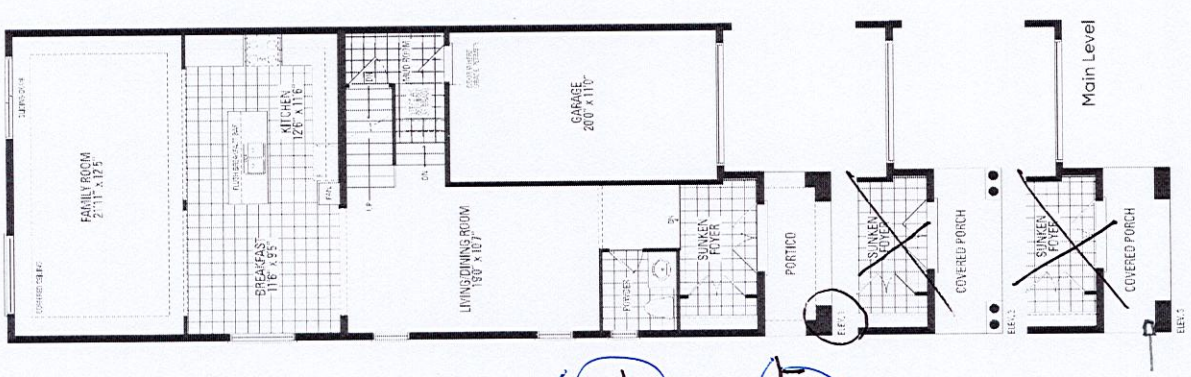


*10FT MAIN FLOOR
CEILING HEIGHT

*ENLARGE BASEMENT
WINDOWS (3)

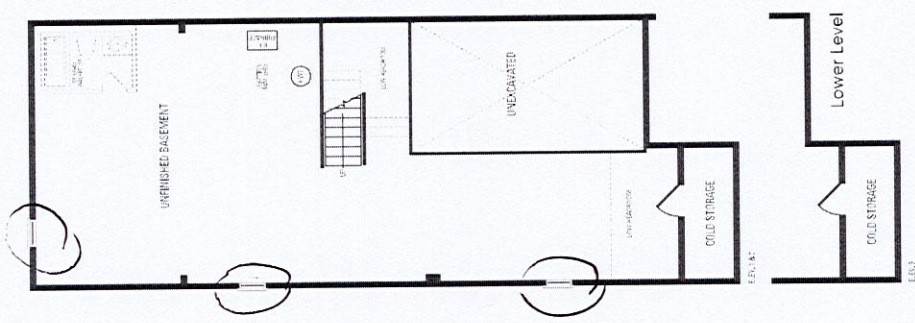

LOT 66

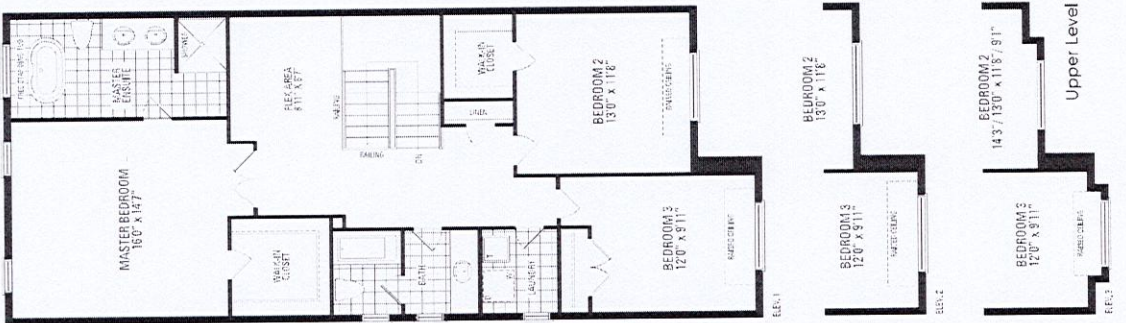

Orientation of home may be reversed and purchaser agrees to accept the same. Steps and porches may vary at any exterior entrance ways due to grading variance. Actual usable floor space may vary from the stated floor areas. All renderings are artist's concept. Dimensions, specifications and architectural detailing subject to modifications. Roofline and adjoining model types may vary due to siting. E. & O.E. October 2022

HAZEL
GLENN

ALLEN