

CONSTRUCTION SUMMARY Hazel Glenn - Barlassina Construction Inc.	
PURCHASER: Shilpa RAJESHEKARA	TEL: RES.: 647-864-5879

LOT / PHASE 112 / 1	REG. PLAN #	HOUSE TYPE Garden 4 Elev 1		
------------------------	-------------	-------------------------------	--	--

CONSTRUCTION

3 - ENLARGE BASEMENT WINDOWS (MAY REQUIRE WINDOW WELLS) - WINDOW IS 30 INCHES X 24 INCHES 01Dec22 Note:	
1 - FIRST FLOOR INCREASE CEILING HEIGHT FROM 9 FEET TO 10 FEET 01Dec22 Note:	

PROMOTIONAL

1 - LESS CREDIT FROM PURCHASER EXTRA SHEET IN OFFER 01Dec22 Note:	
--	--

This Document is Extremely Time Sensitive - Printed 12 Dec 22 at 9:02

GLENN
HAZEL

THE


The floor plan illustrates three variations of a house layout, labeled 'Main Level' on the right. The plan includes the following rooms and dimensions:

- Variation 1 (Left):**
 - FAMILY ROOM: 167' x 112'
 - DEN: 100' x 82'
 - LIVING/DINING ROOM: 159' x 117'
 - KITCHEN: 114' x 112'
 - BREAKFAST: 103' x 95'
 - GARAGE: 207' x 100'
- Variation 2 (Middle):**
 - SUNKEN FOYER
 - COVERED PORCH
 - SUNKEN FOYER
 - PORCH
- Variation 3 (Right):**
 - SUNKEN FOYER
 - PORCH

A red circle highlights a specific area in the Sunken Foyer of the middle variation.

*3 Enlarged Basement windows

- * Increase ceiling height to 10' - First Floor Only

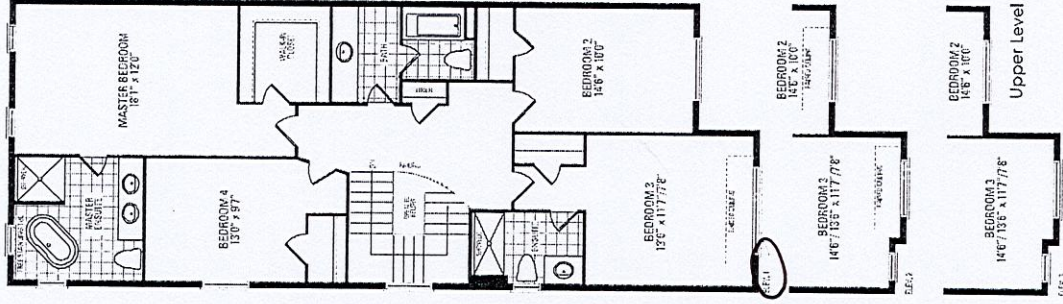

Orientation of home may be reversed and purchaser agrees to accept the same. Steps and porches may vary at any exterior entrance ways due to grading variance. Actual usable floor space may vary from the stated floor areas. All renderings are artist's concept. Dimensions, specifications and architectural detailing subject to modifications. Roofline and adjoining model types may vary due to siting. E. & O.E. October 2022