

CONSTRUCTION SUMMARY

Hazel Glenn - Barlassina Construction Inc.

PURCHASERS: Randeep Singh BHAMRA and Amulpreet Kaur BHAMRA TEL: RES.: 416-275-0081 BUS.: 437-980-9690

LOT / PHASE 115 / 1	REG. PLAN #	HOUSE TYPE Garden 4 Elev 1		
------------------------	-------------	-------------------------------	--	--

CONSTRUCTION

3 - ENLARGE BASEMENT WINDOWS (MAY REQUIRE WINDOW WELLS) - WINDOW IS 30 INCHES X 24 INCHES 30Nov22 Note:	
--	--

PROMOTIONAL

1 - LESS CREDIT FROM PURCHASER EXTRA SHEET IN OFFER 30Nov22 Note: PROMO BALANCE REMAINING - \$ 8,050.00	
--	--

This Document is Extremely Time Sensitive - Printed 12 Dec 22 at 9:03




LOT #115

GLENN
HAZEL

ALBA

Garden 4

ELEVATION 1 - 2,610 sq.ft. • ELEVATION 2 & 3 - 2,629 sq.ft.
Includes 14 sq.ft. of open area

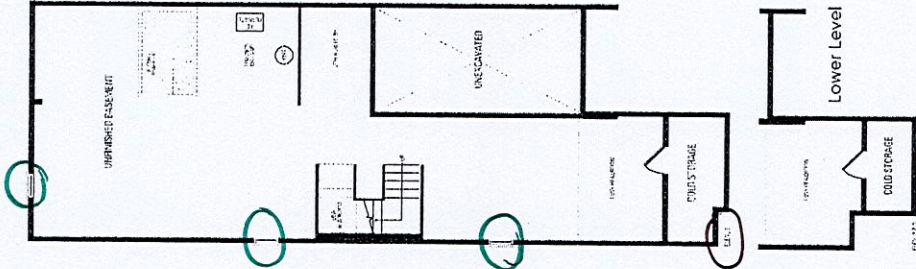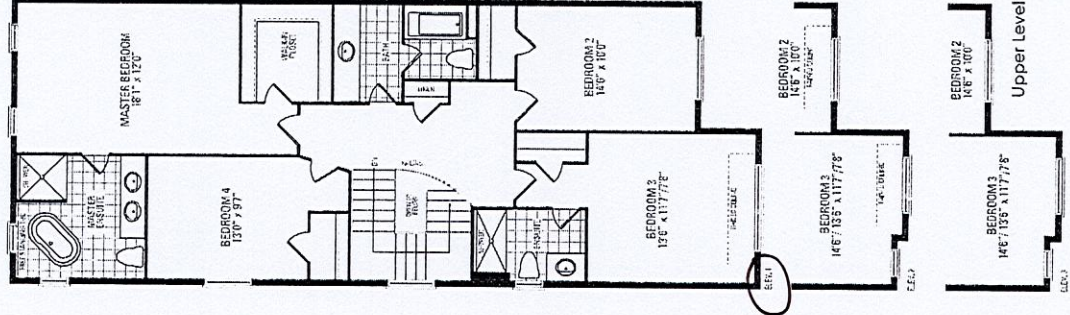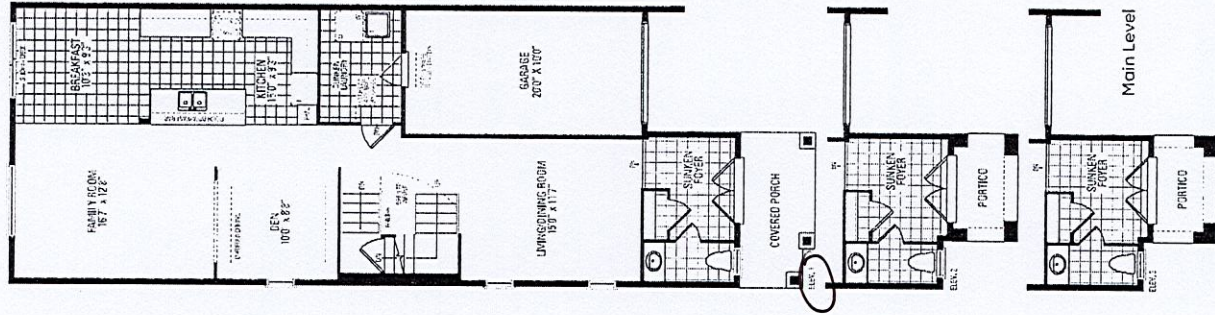

~~3~~ Enlarged Basement Windows

Orientation of home may be reversed and purchaser agrees to accept the same. Steps and porches may vary at any exterior entrance ways due to grading variance. Actual usable floor space may vary from the stated floor areas. All renderings are artist's concept. Dimensions, specifications and architectural detailing subject to modifications. Roofline and adjoining model types may vary due to siting. E. & O.E. October 2022