

CONSTRUCTION SUMMARY

Red Oaks - Roundel Homes Inc.

PURCHASERS: Shui Yan ZHENG and Yuan ZHENG

TEL: RES.: 647-287-8451

LOT / PHASE 113 / 1	REG. PLAN # 65M-4737	HOUSE TYPE Pinetree 2 Elev 3		
------------------------	-------------------------	---------------------------------	--	--

CONSTRUCTION

1 - SMOOTH CEILINGS ON FIRST FLOOR ONLY - DET 09Dec22 Note:	
--	--

ELECTRICAL

1 - PLUG - ELECTRICAL PLUG - TO BE INSTALLED OVER FIREPLACE 09Dec22 Note: FAMILY ROOM	
1 - ELECTRIC VEHICLE ROUGH-IN PROVISION ONLY FOR FUTURE ELECTRIC CAR (CONDUIT FROM BASEMENT INTO JUNCTION BOX IN GARAGE WITH PULL STRING, NO WIRE) 09Dec22 Note: **SEE SKETCH FOR REQUESTED LOCATION -IF CONSTRUCTION PERMITS	

HEATING AND AIR CONDITIONING

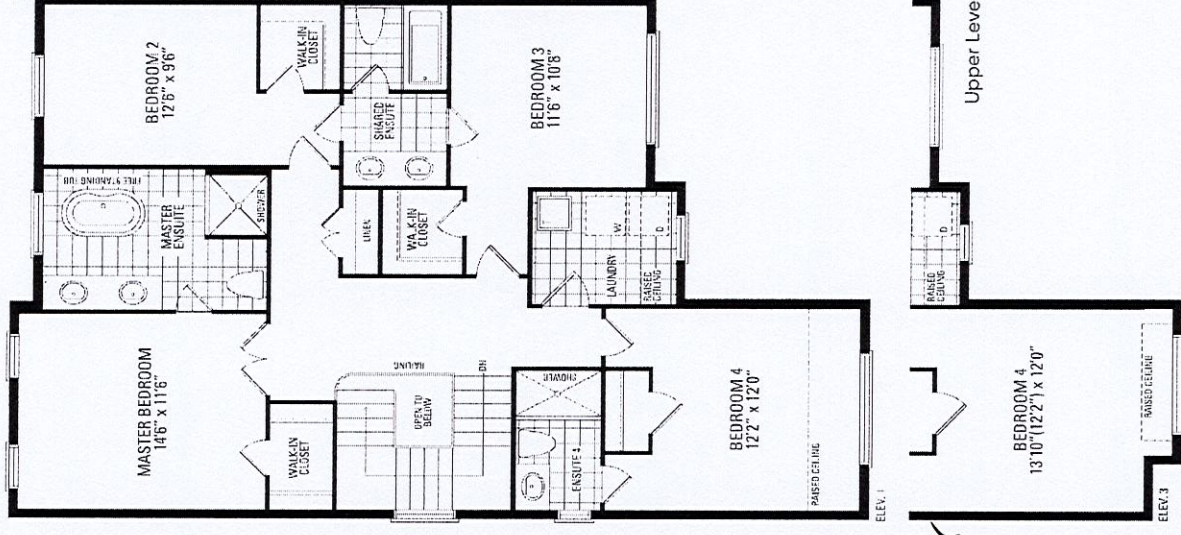
1 - HUMIDIFER 09Dec22 Note:	
--------------------------------	--

PROMOTIONAL

1 - LESS CREDIT FROM PURCHASER EXTRA SHEET IN OFFER 09Dec22 Note: PROMO BALANCE REMAINING \$1,855.00	
---	--

This Document is Extremely Time Sensitive - Printed 9 Dec 22 at 10:50

Pinetree 2

[illegible]

*Smooth Ceilings-First Floor

*Humidifer

Orientation of home may be reversed and purchaser agrees to accept the same. Steps and porches may vary at any exterior entrance ways due to grading variance. Actual usable floor space may vary from the stated floor areas. All renderings are artist's concept. Dimensions, specifications and architectural detailing subject to modifications. Roofline and adjoining model types may vary due to siting. E. & O. E. June 2022