

CONSTRUCTION SUMMARY

Hazel Glenn - Barlassina Construction Inc.

PURCHASERS: Fayyaz AHMAD and Tahira BANO

TEL: RES.: 416-887-8410

LOT / PHASE 72 / 1	REG. PLAN #	HOUSE TYPE Garden 3 Elev 3 (3 Bedroom)		
-----------------------	-------------	---	--	--

CONSTRUCTION

3 - ENLARGE BASEMENT WINDOWS (MAY REQUIRE WINDOW WELLS) - WINDOW IS 30 INCHES X 24 INCHES 09Dec22 Note:	
--	--

PROMOTIONAL

1 - LESS CREDIT FROM PURCHASER EXTRA SHEET IN OFFER 09Dec22 Note: PROMO BALANCE REMAINING - \$8,050.00	
---	--

This Document is Extremely Time Sensitive - Printed 12 Dec 22 at 9:05




LOT #72

HAZEL
GLENN

ALMA

Garden 3

ELEVATION 1 & 2 - 2,400 sq.ft. • ELEVATION 3 - 2,415 SQ.FT.

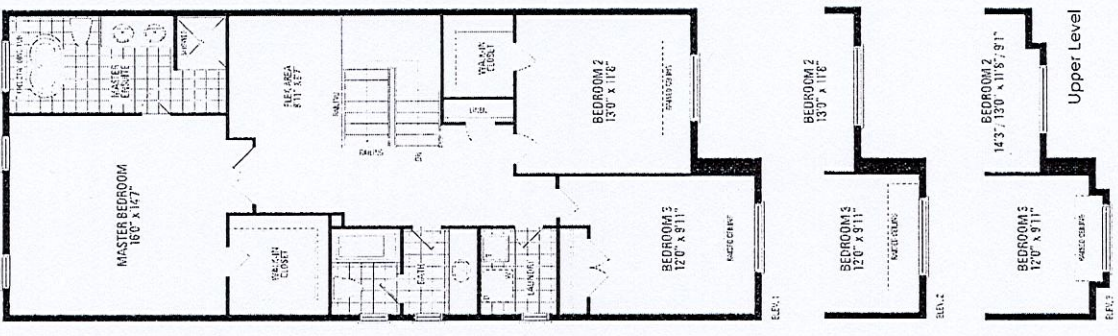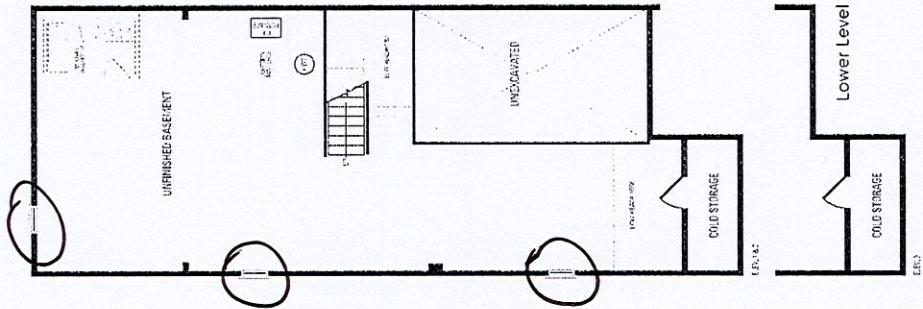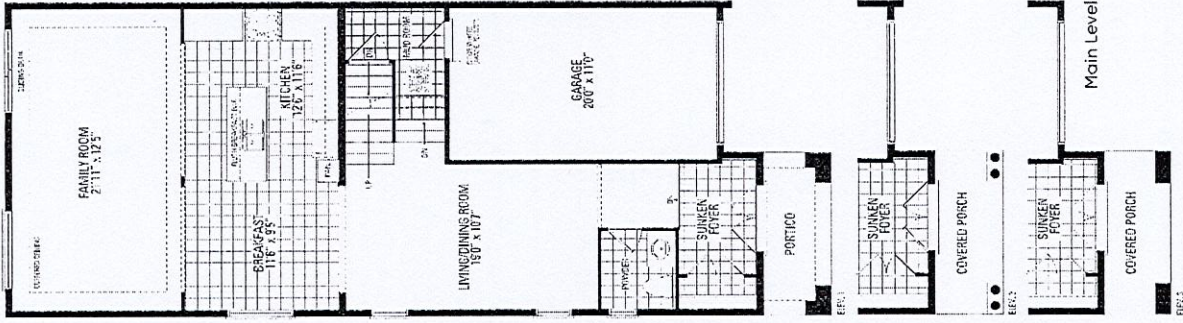

*Enlarge Basement Windows

Orientation of home may be reversed and purchaser agrees to accept the same. Steps and porches may vary at any exterior entrance ways due to grading variance. Actual usable floor space may vary from the stated floor areas. All renderings are artist's concept. Dimensions, specifications and architectural detailing subject to modifications. Roofline and adjoining model types may vary due to siting. E. & O.E. October 2022