

CONSTRUCTION SUMMARY

Red Oaks - Roundel Homes Inc.

PURCHASERS: Christopher Vincent IABONI and Samantha Ashley CAMARDO

RECEIVED

JAN - 6 2023

TEL:

LOT / PHASE	REG. PLAN #	HOUSE TYPE	
88 / 1	65M-4737	Pinetree 3 Elev 1	

CONSTRUCTION

I - MASTER ENSUITE- FRAMELESS GLASS SHOWER ENCLOSURE 04Jan23 Note:	
I - REPLACE BRICK WITH STONE BASE ON FRONT ELEVATION- SEE SKETCH 21Dec22 Note:	

MIRRORS AND GLASS

I - MASTER ENSUITE – FRAMELESS GLASS SHOWER ENCLOSURE – INCLUDES CHROME D-RING HANDLE AND CHROME HINGES 04Jan23 Note:	
---	--

PROMOTIONAL

I - PARTIAL REDEMPTION OF PROMOTIONAL PACKAGE \$5,085 BALANCE FORWARD \$14,915 TO BE USED AT A LATER DATE. ORIGINAL PROMOTIONAL PACKAGE OF \$20,000 AS PER SCHEDULE PE 04Jan23 Note:	
--	--

EXTRAS AS PER OFFER

The Vendor agrees that notwithstanding any other term or provision in this Agreement included in the Purchase Price and in addition to those items detailed in Schedule GP to the Agreement of Purchase and Sale, the Purchaser is entitled to a credit of Two Worksheets Note:	
--	--

This Document is Extremely Time Sensitive - Printed 4 Jan 23 at 11:48


PURCHASER ALTERATION FORM

LOT 88
 RONDEL
 RED OAKS ON BAYVIEW

PINETREE 3
ELEVATION 1

REVISIONS:

- REPLACE BRICK WITH STONE BASE ON FRONT ELEVATION.

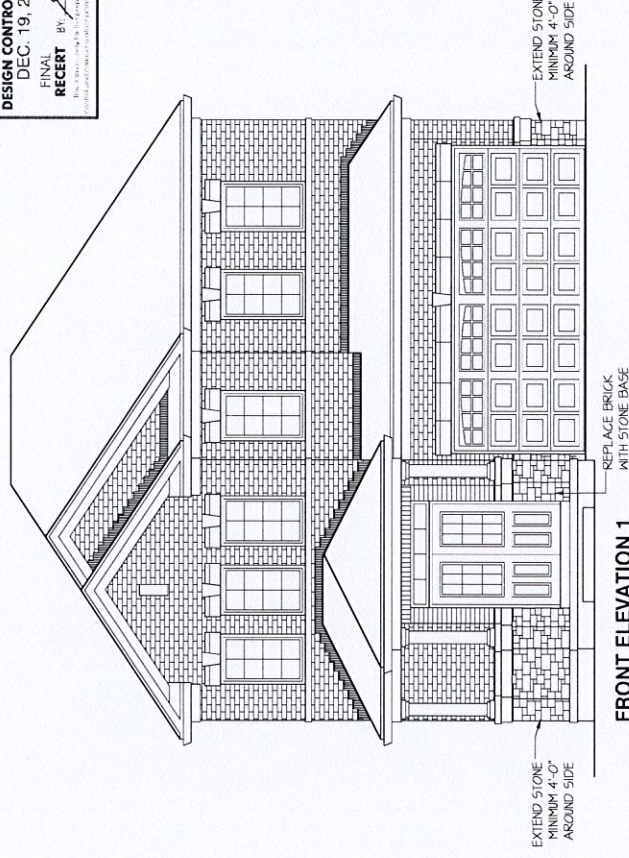

FRONT ELEVATION 1

NOTE: ACTUAL GRADING WILL VARY
WITH LOT CONDITIONS

W Architect Inc.
DESIGN CONTROL REVIEW
DEC. 19, 2022
FINAL
RECEIVED BY: *ALL*

DISCLAIMERS: SKETCH NOT TO SCALE. DIMENSIONS, SPECIFICATIONS AND ARCHITECTURAL DETAILS SUBJECT TO MODIFICATION BY THE VENDOR. SKETCH IS ONLY FOR THE PURPOSE OF ILLUSTRATING REVISIONS REQUESTED BY THE PURCHASER AND ALL REVISIONS ARE SUBJECT TO VENDOR'S FINAL APPROVAL. ONLY REVISIONS ACCEPTED IN WRITING BY THE PURCHASER AND VENDOR ON A PURCHASER'S EXTRA SHEET WILL BE INCORPORATED INTO THE PLANS FILED WITH THE MUNICIPALITY. E. & O.E.

REGION DESIGN INC.

SCALE

BY MB

PAGE No. 1 OF 1

N.T.S.

Greenpark.

Pinetree 3

ELEV. 1 • 2,682 sq.ft. | ELEV. 2 • 2,673 sq.ft. | ELEV. 3 • 2,686 sq.ft.

Includes 38 sq.ft. of open area.

LOT 88

