

RECEIVED  
FEB - 2 2023

Selba:  
Revised Kitchen  
Layout.  
See Attached

CONSTRUCTION SUMMARY - PARTIAL ONLY  
Mountainview Heights 3 (G) - Russell Gardens Building Ltd.

PURCHASERS: Inderpal Singh BASSI and Swati BASSI  
TEL: RES.: 647-641-2000 BUS.: 905-488-0448

LOT NUMBER	PHASE	HOUSE TYPE	REG. PLAN #		
487	4	Springfield One (4 Bedroom) Elev 3	62M-1266		
INV#	QTY	EXTRA / CHANGE		COMMENTS	

Offer	Note:
-------	-------

CABINETRY

27,048 28Apr22	1 - CABINETRY - KITCHEN - HARDWARE UPGRADE 1- INCLUDING MINISTACKED UPPERS Note:
26,874 01Apr22	1 - CABINETRY PROVISION - PROVISION FOR PLUG ON ISLAND (PLUG EXTRA ORDERED SEPARATELY) Note:
26,874 01Apr22	1 - KITCHEN - UPGRADE 1 UPPER CABINETRY WITH UPGRADE 2 BASE CABINETRY & TALL UNITS Note:
26,874 01Apr22	1 - KITCHEN - LIGHT VALANCE Note:
26,874 01Apr22	1 - KITCHEN - CM 11 CROWN MOULDING Note:

This Document is Extremely Time Sensitive - Printed 2 Feb 23 at 15:18



CONSTRUCTION SUMMARY - PARTIAL ONLY

Mountainview Heights 3 (G) - Russell Gardens Building Ltd.

PURCHASERS: Inderpal Singh BASSI and Swati BASSI TEL: RES.: 647-641-2000 BUS.: 905-488-0448

LOT NUMBER	PHASE	HOUSE TYPE	REG. PLAN #		
487	4	Springfield One (4 Bedroom) Elev 3	62M-1266		
INV#	QTY	EXTRA / CHANGE			CABINETS

CABINERY ACCESSORIES

27,165 09May22	3 - KITCHEN CABINERY UPPER - GLASS DOOR - CLEAR GLASS - FINISHED INTERIOR - FITS TALL UPPER CABINETS ONLY - UPGRADE 1 NotePURCHASER ACKNOWLEDGES AND ACCEPTS THAT GLASS BY STOVE IS CORD AND IS DIFFERENT FROM GLASS IN SERVERY
27,165 09May22	3 - KITCHEN CABINERY UPPER – CLEAR GLASS DOOR FOR MINI UPPER – GROUP 1 GLASS – UPGRADE 1 CABINERY NotePURCHASER ACKNOWLEDGES AND ACCEPTS THAT GLASS BY STOVE IS CORD AND IS DIFFERENT FROM GLASS IN SERVERY
26,874 01Apr22	1 - KITCHEN CABINERY – MINI STACKED UPPER CABINETS – UPGRADE 1 CABINERY - IF CONSTRUCTION PERMITS NotePURCHASER DECLINES CROWN MOULDING
26,874 01Apr22	1 - KITCHEN CABINERY UPPER – GLASS DOOR FOR MINI UPPER – GROUP 1 GLASS – UPGRADE 1 CABINERY - BACK WALL OF KITCHEN RUN ONLY - DOES NOT INCLUDE ABOVE FRIDGE OR SERVERY Note:
26,874 01Apr22	4 - KITCHEN CABINERY UPPER - GLASS DOOR - GLK340 CORD GLASS - FINISHED INTERIOR - FITS TALL UPPER CABINETS ONLY - UPGRADE 1 Note:
26,874 01Apr22	1 - KITCHEN CABINERY - BUILT-IN DOUBLE OVEN - UPGRADE 2 Note:
26,874 01Apr22	1 - KITCHEN CABINERY - BUILT-IN MICROWAVE/COFFEE MAKER COMBO - UPGRADE 2 Note:
26,874 01Apr22	1 - KITCHEN CABINERY BASE - COOKTOP CABINET WITH POT DRAWERS (2 DRAWERS) - UPGRADE 2 Note:
26,874 01Apr22	1 - KITCHEN CABINERY BASE - POT/PAN DRAWERS (CABINET) SECOND SET BELOW COOKTOP - UPGRADE 2 Note:
26,874 01Apr22	1 - KITCHEN CABINERY BASE - TOP DRAWER DOUBLE - UPGRADE 2 Note:
26,874 01Apr22	2 - KITCHEN CABINERY BASE - PULLOUT WIRE SPICE RACK - PRICE IS EACH Note:
26,874 01Apr22	1 - KITCHEN CABINERY ACCESSORY - LEMANS CORNER MECHANISM - 450MM MIN CABINET - PRICE IS EACH Note:
26,874 01Apr22	1 - KITCHEN CABINERY BASE - PULLOUT RECYCLE 4 BIN - PRICE IS EACH Note:
26,874 01Apr22	1 - KITCHEN - RELOCATE STANDARD BANK OF DRAWERS TO ISLAND Note:
26,874 01Apr22	1 - KITCHEN CABINERY BASE - BANK OF DRAWERS - UPGRADE 2 Note:
26,874 01Apr22	1 - KITCHEN - CREATE OPENING FOR WINE FRIDGE Note:



CONSTRUCTION SUMMARY - PARTIAL ONLY

Mountainview Heights 3 (G) - Russell Gardens Building Ltd.

PURCHASERS: Inderpal Singh BASSI and Swati BASSI

TEL: RES.: 647-641-2000 BUS.: 905-488-0448

LOT NUMBER	PHASE	HOUSE TYPE	REG. PLAN #		
487	4	Springfield One (4 Bedroom) Elev 3	62M-1266		

INV#	QTY	EXTRA / CHANGE	REMARKS
------	-----	----------------	---------

CABINETRY ACCESSORIES

26,874 01Apr22	1 - KITCHEN CABINETRY BASE - POT/PAN DRAWERS (CABINET) - UPGRADE 2 Note:
26,874 01Apr22	8 - KITCHEN CABINETRY ACCESSORY - PULLOUT SHELVES - PANTRIES ONLY Note:
26,874 01Apr22	1 - KITCHEN CABINETRY UPPER - FULL DEPTH ABOVE FRIDGE - WITH GABLES - 600MM - PRICE IS EACH - UPGRADE 2 Note:
26,874 01Apr22	1 - KITCHEN CABINETRY - BUILT-IN FRIDGE CABINET - PRICE IS EACH Note:
26,874 01Apr22	1 - KITCHEN HOOD CABINETS - CONTEMPORARY WOOD HOOD – UPGRADE 1 Note:
26,874 01Apr22	1 - KITCHEN - SOFT CLOSING CABINETRY Note:
26,874 01Apr22	1 - KITCHEN - BLU MOTION DRAWERS Note:
26,874 01Apr22	1 - CABINETRY FEE FOR FLUSH CUTOUT ON WALL OVEN/MICROWAVE COMBO CABINET ONLY Note:
26,874 01Apr22	1 - CABINETRY FEE FOR FLUSH CUTOUT ON WALL SINGLE MICROWAVE CABINET Note:
26,874 01Apr22	1 - KITCHEN - RELOCATE FRIDGE - SEE SKETCH Note:
26,874 01Apr22	1 - KITCHEN CABINETRY BASE - BASE AND STANDARD COUNTER - FILL IN PREVIOUS FRIDGE LOCATION - UPGRADE 2 Note:
26,874 01Apr22	1 - KITCHEN CABINETRY UPPER - UPPER CABINETS - FITS TALL UPPER CABINETS - FILL IN PREVIOUS FRIDGE LOCATION - UPGRADE 2 Note:
26,874 01Apr22	1 - KITCHEN - REDUCE LENGTH OF ISLAND BY APPROX 2' Note:
26,874 01Apr22	1 - VANITY CABINETRY - RAISE VANITY TO 36" HIGH VANITY IN LIEU OF STANDARD HEIGHT - POWDER ROOM Note:
26,874 01Apr22	1 - VANITY CABINETRY - RAISE VANITY TO 36" HIGH VANITY IN LIEU OF STANDARD HEIGHT - MASTER ENSUITE BATHROOM Note:
26,874 01Apr22	1 - VANITY CABINETRY - RAISE VANITY TO 36" HIGH VANITY IN LIEU OF STANDARD HEIGHT - ENSUITE 2 BATHROOM Note:



CONSTRUCTION SUMMARY - PARTIAL ONLY

Mountainview Heights 3 (G) - Russell Gardens Building Ltd.

PURCHASERS: Inderpal Singh BASSI and Swati BASSI TEL: RES.: 647-641-2000 BUS.: 905-488-0448

LOT NUMBER	PHASE	HOUSE TYPE	REG. PLAN #		
487	4	Springfield One (4 Bedroom) Elev 3	62M-1266		
INV#	QTY	EXTRA / CHANGE			

CABINETRY ACCESSORIES

26,874 01Apr22	1 - VANITY CABINETRY - RAISE VANITY TO 36" HIGH VANITY IN LIEU OF STANDARD HEIGHT - ENSUITE 3/4 BATHROOM Note:
-------------------	---

This Document is Extremely Time Sensitive - Printed 2 Feb 23 at 15:18




GLC  
340  
CORD GLASS

can 11 GLC 340 CORD GLASS.

GLC 340 CORD GLASS.

GLC  
340  
CORD  
GLASS

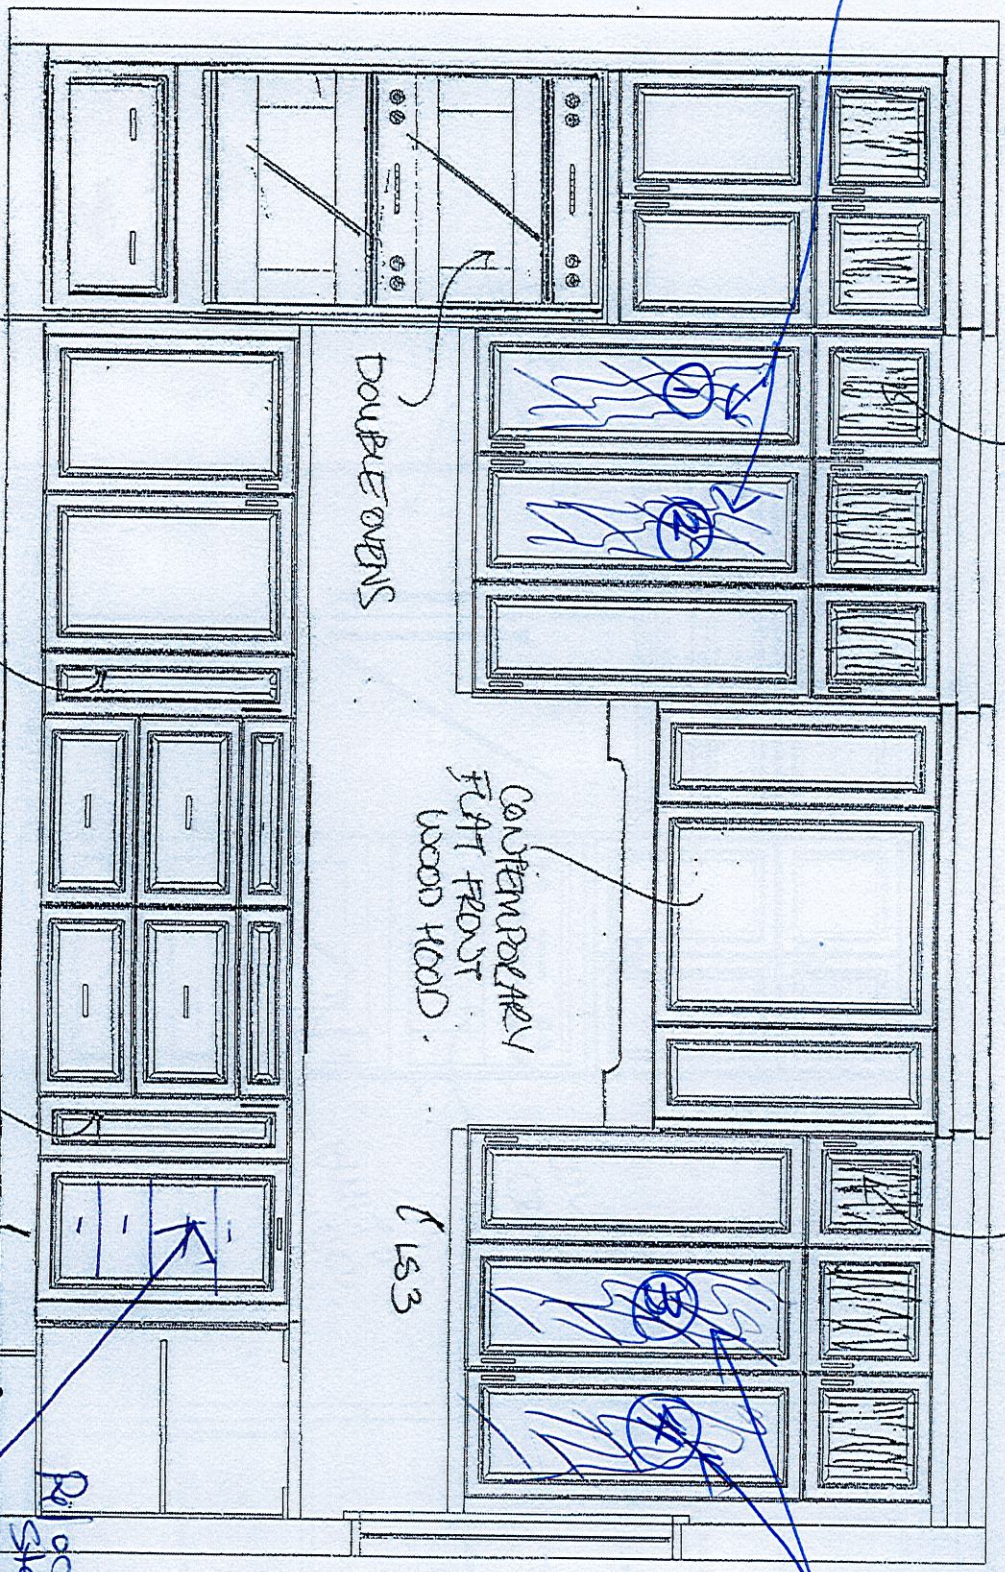

SPICE  
PO

SPICE  
PO

Relocate standard  
2 BIN PO  
REPLACE  
Banks  
Drawers

This drawing is the intellectual property of  
SELBA INDUSTRIES INC. and is an  
artistic  
interpretation of the general  
appearance of the design. It is  
not meant to be an exact rendition.



Designed: 4/27/2022  
Printed: 5/4/2022




STAGE WITH

RUSSEL GARDENS LOT 487

LAYOUT

Drawing #: 1



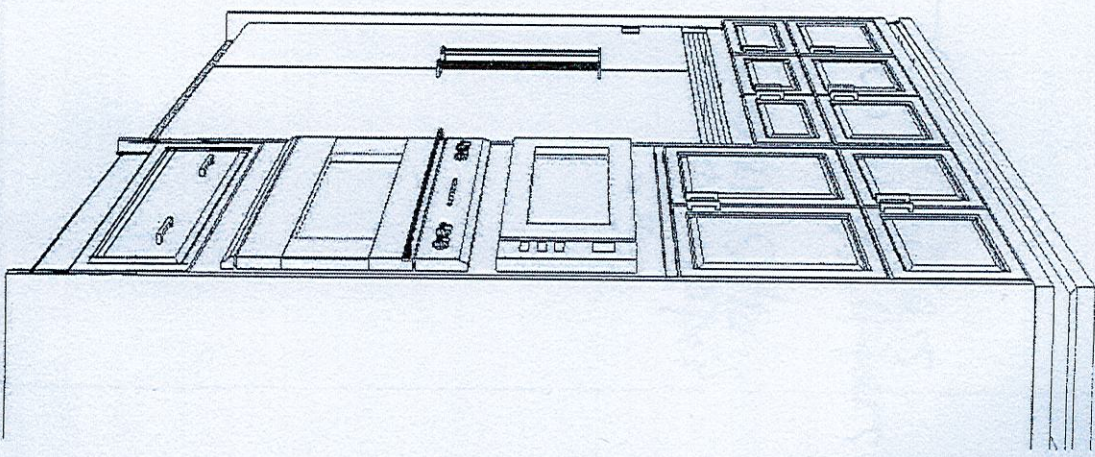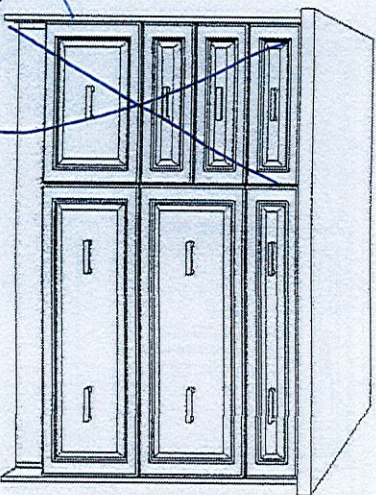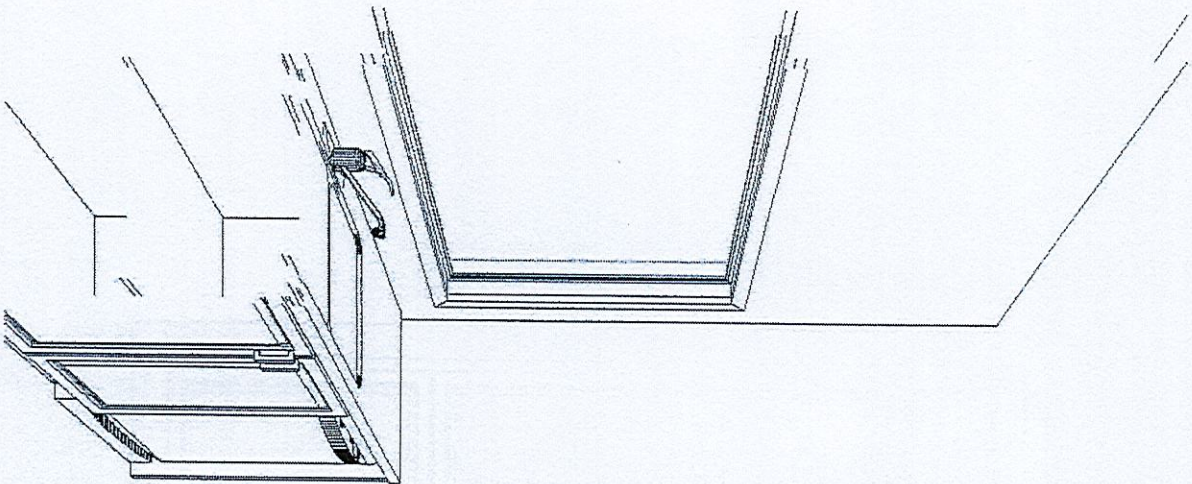

*Back to Back*  
*at add 4 Bin*  
*recycling unit*

This drawing is the intellectual property of  
SELBA INDUSTRIES INC. and is an  
artistic  
interpretation of the general  
appearance of the design. It is  
not meant to be an exact rendition.

2020  
TECHNOLOGIES

Designed: 5/6/2022  
Printed: 5/6/2022

INSIDE ISLAND  
VIEW

RUSSEL GARDENS 487

LAYOUT

Drawing #: 1

