

CONSTRUCTION SUMMARY - PARTIAL ONLY					
Mountainview Heights 3 (G) - Russell Gardens Building Ltd.					
PURCHASERS: Inderpreet Singh BAWEJA and Monika CHOPRA				TEL: RES.: 647-968-2514	

LOT NUMBER	PHASE	HOUSE TYPE	REG. PLAN #		
362	4	Springfield Three (4 Bed with Guest Suite) Elev 1	62M-1266		

INV#	QTY	EXTRA / CHANGE
------	-----	----------------

CABINETRY

26,485 25Jan22	1 - VANITY - POWDER ROOM - UPGRADE 5 Note:
26,485 25Jan22	1 - VANITY - ENSUITE - UPGRADE 5 Note:
26,485 25Jan22	1 - CABINETRY - KITCHEN - HARDWARE UPGRADE 2 Note:
26,485 25Jan22	1 - VANITY - ENSUITE - HARDWARE UPGRADE 2 Note:
26,485 25Jan22	1 - VANITY - MAIN BATHROOM - HARDWARE UPGRADE 2 Note:
26,485 25Jan22	1 - VANITY - OTHER - HARDWARE UPGRADE 2 Note:
26,485 25Jan22	1 - VANITY - POWDER ROOM - HARDWARE UPGRADE 2 Note:
26,485 25Jan22	1 - CABINETRY - KITCHEN - UPGRADE 5 Note:
26,485 25Jan22	1 - KITCHEN ADD MISSION MINI STACKED UPPERS Note:
26,485 25Jan22	1 - ADD WATERFALL GLASS TO 2 DOORS NEXT TO EACH SIDE OF CANOPYAND MINI STACKED UPPERS Note:
26,485 25Jan22	1 - KITCHEN CABINETRY - DIFFERENT COLOUR ISLAND - FLAT FEE Note:
26,485 25Jan22	1 - KITCHEN ADD CROWN MOULDING WITH HEADER TO CEILING Note:
26,485 25Jan22	1 - KITCHEN ADD LIGHT VALANCE- Note:

CABINETRY ACCESSORIES

28,194 03Feb23	1 - ADD PROFILE TOE KICK TO BACK AND SIDE OF ISLAND Note:	★
28,194 03Feb23	1 - WOOD HOOD AND POT AND PANS UNDER COOKTOP TOBE IN MISSION 701 PEWTER AS PE SKETCH ATTACHED- Note:	★

CONSTRUCTION SUMMARY - PARTIAL ONLY					
Mountainview Heights 3 (G) - Russell Gardens Building Ltd.					
PURCHASERS: Inderpreet Singh BAWEJA and Monika CHOPRA				TEL: RES.: 647-968-2514	

LOT NUMBER	PHASE	HOUSE TYPE	REG. PLAN #		
362	4	Springfield Three (4 Bed with Guest Suite) Elev 1	62M-1266		
INV#	QTY	EXTRA / CHANGE			

CABINETRY ACCESSORIES

28,194 03Feb23	1 - ISLAND TO BE DONE AS PER SKETCH -SEE SKETCH WITH CORRECT DIMENSIONS- Note: ADD HANDLE ON DUMMY DOOR FACING FAMILY ROOM SIDE AS PER SKETCH	 
26,618 04Nov22	1 - CABINETRY FEE FOR FLUSH CUTOUT ON WALL SINGLE OVEN CABINET Note:	
26,618 04Nov22	1 - CABINETRY FEE FOR FLUSH CUTOUT ON WALL SINGLE SPEED OVEN Note:	
26,485 25Jan22	1 - KITCHEN CABINETRY BASE - PULLOUT RECYCLE 4 BIN - PRICE IS EACH Note:	
26,485 25Jan22	1 - KITCHEN CABINETRY BASE - COOKTOP CABINET WITH POT DRAWERS (2 DRAWERS) - UPGRADE 5 Note:	
26,485 25Jan22	1 - KITCHEN CABINETRY BASE - POT/PAN DRAWERS (CABINET) - UPGRADE 5 Note:	
26,485 25Jan22	2 - KITCHEN CABINETRY BASE - PULLOUT WIRE SPICE RACK - PRICE IS EACH Note:	
26,485 25Jan22	1 - ADD KITCHEN SOFT CLOSE DOORS AND DRAWERS Note:	
26,485 25Jan22	1 - KITCHEN HOOD CABINETS - CONTEMPORARY WOOD HOOD – UPGRADE 5 Note:	
26,485 25Jan22	4 - KITCHEN CABINETRY ACCESSORY - PULLOUT SHELVES STAINLESS STEEL SOFT CLOSE - PER SHELF Note:	
26,485 25Jan22	1 - KITCHEN CABINETRY UPPER - FULL DEPTH ABOVE FRIDGE - WITH GABLES - 600MM - PRICE IS EACH - UPGRADE 5 Note:	
26,485 25Jan22	2 - PANTRY UNIT UPGRADE - TO GO FROM 300MM TO 600MM DEEP - PRICE IS PER FOOT - UPGRADE 5 Note:	
26,485 25Jan22	1 - KITCHEN ADD OPENING FOR WINE FRIDGE ON ISLAND- Note:	
26,485 25Jan22	1 - KITCHEN CABINETRY - BUILT-IN FRIDGE CABINET - PRICE IS EACH Note:	
26,485 25Jan22	1 - KITCHEN CABINETRY ACCESSORY - LEMANS CORNER MECHANISM - 450MM MIN CABINET - PRICE IS EACH Note:	
26,485 25Jan22	1 - KITCHEN CABINETRY BASE - PIE CUT CORNER CABINET - BASE CABINETRY - UPGRADE 5 Note:	

GREY - FLAT FRONT
WOOD TOP



LEMAUS

SPICE
PULL
OUT

36" cooktop
w/pots + pans
GREY

SPICE
PULL
OUT

BASE
2 1/2 CUT

This drawing is the intellectual property of
SELBA INDUSTRIES INC. and is an
artistic
interpretation of the general
appearance of the design. It is
not meant to be an exact rendition.


2020
TECHNOLOGIES
Designed: 12/16/2021
Printed: 1/26/2022

RUSSELL GARDENS LOT 362 PH4 LAYOUT Drawing #: 1



2 DOOR BASE CAB.

Add Handle to Door

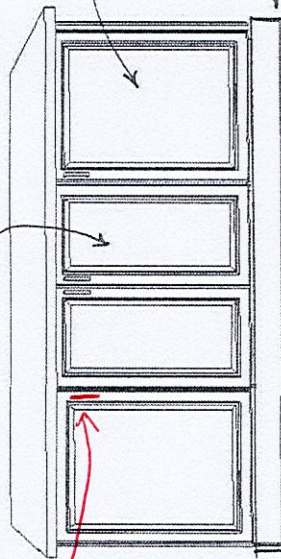

FIXED SIDE CABINET FOR BAL FRIDGE

SINGLE DOOR BASE CAB.

ADD PROFILE TOE KICK TO BACK & SIDES OF ISLAND

600 x 400 x 400 x 600

Designed: 1/26/2022
Printed: 3/15/2022



This drawing is the intellectual property of SELBA INDUSTRIES INC. and is an artistic interpretation of the general appearance of the design. It is not meant to be an exact rendition.


REV 0015122

REV MAR 22/22

LAYOUT

Drawing #: 1

RUSSELL GARDENS LOT 362 PH4

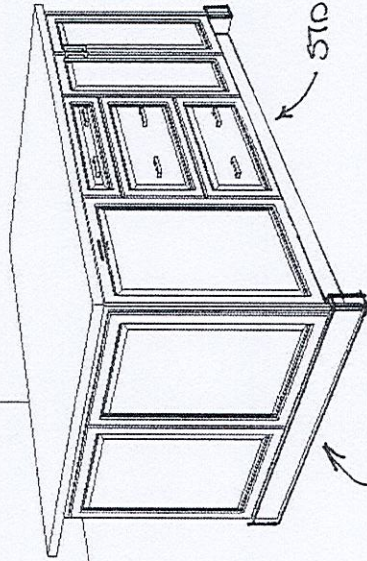


STO RESS T.V @ FRONT.

PERFIVE
T.V.

This drawing is the intellectual property of SELBA INDUSTRIES INC. and is an artistic interpretation of the general appearance of the design. It is not meant to be an exact rendition.		Designed: 3/15/2022 Printed: 3/22/2022	
		LAYOUT	Drawing #: 1

RUSSELL GARDENS 362

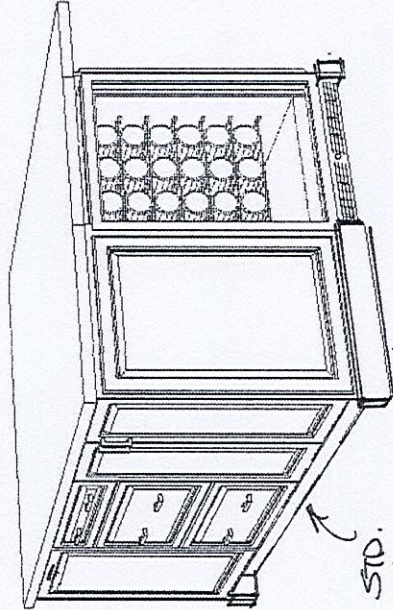

RETURN
OF
PROFILE
T.K.

STD.
T.K.

PROFILE
T.K.

Designed: 3/15/2022
Printed: 3/22/2022



This drawing is the intellectual property of
SELBA INDUSTRIES INC. and is an
artistic
interpretation of the general
appearance of the design. It is
not meant to be an exact rendition.

RUSSELL GARDENS 362	LAYOUT	Drawing #: 1
---------------------	--------	--------------