

PRELIMINARY

CONSTRUCTION SUMMARY

Red Oaks - Roundel Homes Inc.

PURCHASERS: Zahra BEHZADI and Habib BAHRAM

TEL: RES.: 647-505-7183

| | | | | |
|-----------------------|-------------------------|---------------------------------|--|--|
| LOT / PHASE 30 / 1 | REG. PLAN # 65M-4737 | HOUSE TYPE Pinetree 2 Elev 3 | | |
|-----------------------|-------------------------|---------------------------------|--|--|

ELECTRICAL

1 - ABOVE KITCHEN ISLAND - ADD LIGHT AND SWITCH - NO FIXTURE INCLUDED

16Feb23 Note:

PROMOTIONAL

1 - PARTIAL REDEMPTION OF PROMOTIONAL PACKAGE \$270.00 BALANCE FORWARD TO BE USED AT A LATER DATE \$9,730.00. ORIGINAL PROMOTIONAL PACKAGE OF \$10,000.00. AS PER SCHEDULE PE DATED 02/15/23.

16Feb23 Note:


This Document is Extremely Time Sensitive - Printed 16 Feb 23 at 9:22

PineTree 2



Pinetree 2

ELEV. 1 • 2,581 sq.ft. | ELEV. 3 • 2,598 sq.ft.

Includes 16 sq.ft. of open area.

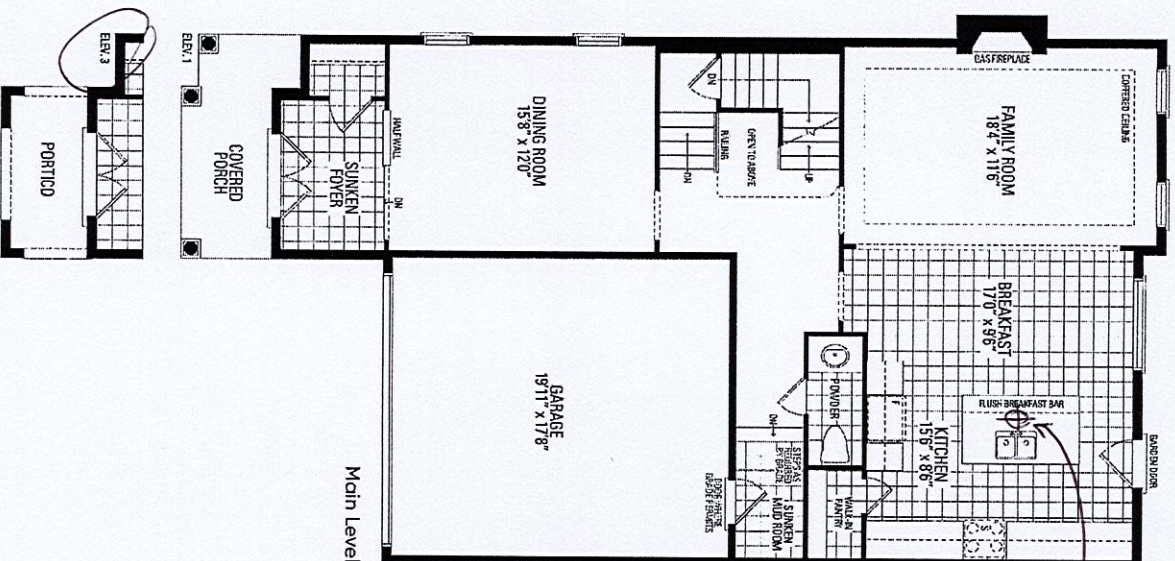

—Add a
light +
Switch above
Island

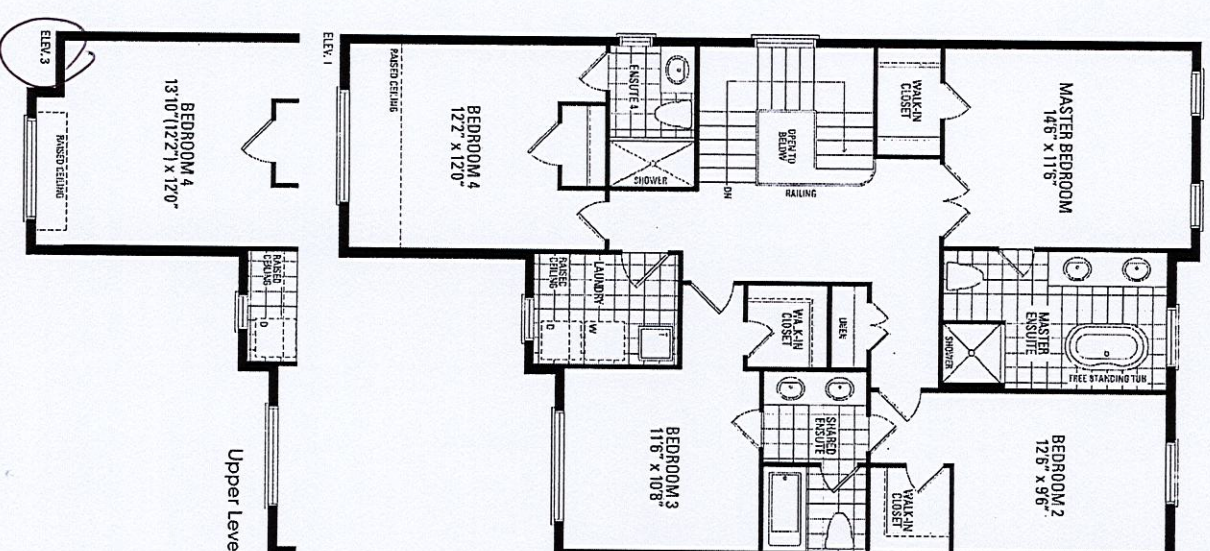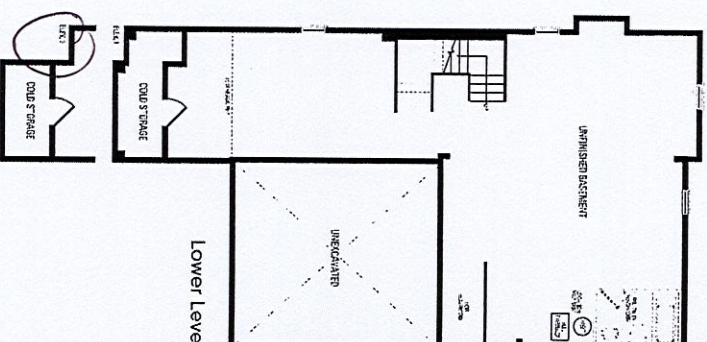

Orientation of home may be reversed and purchaser agrees to accept the same. Steps and porches may vary at any exterior entrance ways due to grading variance. Actual usable floor space may vary from the stated floor areas. All renderings are artist's concept. Dimensions, specifications and architectural detailing subject to modifications. Roofline and adjoining model types may vary due to siting. E. & O. E. June 2022