

CONSTRUCTION SUMMARY - PARTIAL ONLY

Mountainview Heights 3 (G) - Russell Gardens Building Ltd.



PURCHASERS: Bakuleshkumar D. PANDYA and Trupti B. PANDYA

TEL: RES.: 647-968-0395

LOT NUMBER	PHASE	HOUSE TYPE	REG. PLAN #		
541	4	Springfield One (5 Bed with Guest Suite) Elev 2	62M-1266		

INV#	QTY	EXTRA / CHANGE
------	-----	----------------

CABINETRY

28,298 03Mar23	1 - KITCHEN- SOFT CLOSE CABINETS THROUGHOUT KITCHEN AND SERVERY Note:	 
27,305 28Jun22	1 - CABINETRY - KITCHEN - UPGRADE 3 Note:	
27,305 28Jun22	1 - KITCHEN CABINETRY - TWO COLOUR KITCHEN - FLAT FEE Note:	
27,305 28Jun22	1 - KITCHEN - LIGHT VALANCE - NO ELECTRICAL Note:	
27,305 28Jun22	1 - KITCHEN - DELETE CABINETS ABOVE STOVE - VENDOR WILL SUPPLY 6 INCH VENT AS PER CONSTRUCTION SPECIFICATIONS AND VENT MAY NOT BE IN THE APPROPRIATE LOCATION FOR INSTALLATION OF PURCHASER SUPPLIED VENT - PURCHASER TO SUPPLY OWN FAN AFTER CLOSING Note:TEMPORARY HOOD FAN MAY BE PROVIDED	

CABINETRY ACCESSORIES


27,392 07Jul22	1 - KITCHEN CABINETRY - BUILT-IN FRIDGE CABINET Note:	
28,298 03Mar23	1 - DELETE- PANTRY UNIT 600MM DEEP- UPGRADE 3 PANTRY DOES NOT FIT ON FRIDGE WALL Note:	 
28,298 03Mar23	1 - KITCHEN CABINETRY BASE - DUMMY DOOR FOR BASE CABINETRY - PRICE IS PER DOOR - UPGRADE 3 DUMMY DOORS ADDED TO BOTH SIDES OF ISLAND AND AT END OF BASES NEXT TO DISHWASHER- SEE SKETCH ALL BASE DUMMY DOORS TO MATCH BASE CABINETS- LEGACY 626 STRATUS Note:	 
27,392 07Jul22	1 - VANITY CABINETRY - RAISE VANITY TO 36" HIGH VANITY IN LIEU OF STANDARD HEIGHT - PRICE IS PER GUEST ENSUITE BATHROOM Note:	
27,305 28Jun22	1 - KITCHEN - REDUCE ISLAND BY APPROX 2' TO ACCOMMODATE RELOCATION OF FRIDGE Note:	
27,305 28Jun22	1 - KITCHEN CABINETRY BASE - COOKTOP CABINET WITH POT DRAWERS (2 DRAWERS) - UPGRADE 3 Note:	
27,305 28Jun22	1 - KITCHEN CABINETRY - BUILT-IN MICROWAVE/OVEN COMBO - UPGRADE 3 Note:	
27,305 28Jun22	1 - KITCHEN CABINETRY BASE - PULLOUT WIRE SPICE RACK Note:	
27,305 28Jun22	1 - KITCHEN CABINETRY BASE - POT/PAN DRAWERS (CABINET) - UPGRADE 3 Note:	
27,305 28Jun22	1 - KITCHEN CABINETRY ACCESSORY - LEMANS CORNER MECHANISM - 450MM MIN CABINET - PRICE IS EACH Note:	

Selba & Construction
Revised
Kitchen upgrade

Lot 541
Russell Gardens
Ph. 4

Kitchen

- Upg. 3 Legacy Cabinetry
- 2-tone Cabinetry.
- Light-Valance
- Blu Motion Drawers Only.
- Reduce length of island approx. 8'

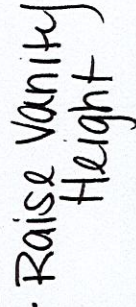

Selba Industries

W WIDTH		W HGT		W CNT		J #	
<p><i>This drawing is the intellectual property of SELBA INDUSTRIES INC. and is an unregistered trademark of SELBA INDUSTRIES INC. No part of this drawing may be reproduced or copied unless applicable fee has been paid or job order placed.</i></p>							
FLOOR HGT		DOOR HGT		BUILDER: GREENPARK			
				SITE: RUSSELL GARDENS PH.4			
ST CNT		2X4		VENT BOX COVER		MODEL: SPRINGFIELD 1X OPT GRND F	
				DESIGNER: LR		LOT #:	
				DATE: APR 28 21			

MODEL: SPRINGFIELD 1X OPT GRND FLR EL 1,2,3

DESIGNER: LR
DATE: APR 28 21
LOT #: