

CONSTRUCTION SUMMARY

Hazel Glenn - Barlassina Construction Inc.

PURCHASERS: Rajan TAMANG and Urmila TAMANG // Archana TAMANG

TEL: RES.: 416-902-3985

LOT / PHASE Block 119 TH32 / 1	REG. PLAN #	HOUSE TYPE Cherry 2 Elev 1		
-----------------------------------	-------------	-------------------------------	--	--

ELECTRICAL

1 - RELOCATE STANDARD KITCHEN LIGHT TO BE CENTERED OVER ISLAND 15Mar23 Note:	
---	--

PLUMBING

1 - TOE TESTER - ADD TOE TESTER TO SHOWER - MASTER ENSUITE 15Mar23 Note:	
---	--

PROMOTIONAL


1 - PARTIAL REDEMPTION OF PROMOTIONAL PACKAGE \$205 BALANCE FORWARD \$9,795 TO BE USED AT A LATER DATE. ORIGINAL PROMOTIONAL PACKAGE OF \$10,000 AS PER SCHEDULE PE 15Mar23 Note:	
--	--

This Document is Extremely Time Sensitive - Printed 15 Mar 23 at 14:04

BLK 119 TH32

Cherry 2

ELEVATION 1 & 2 - 2,030 sq.ft.

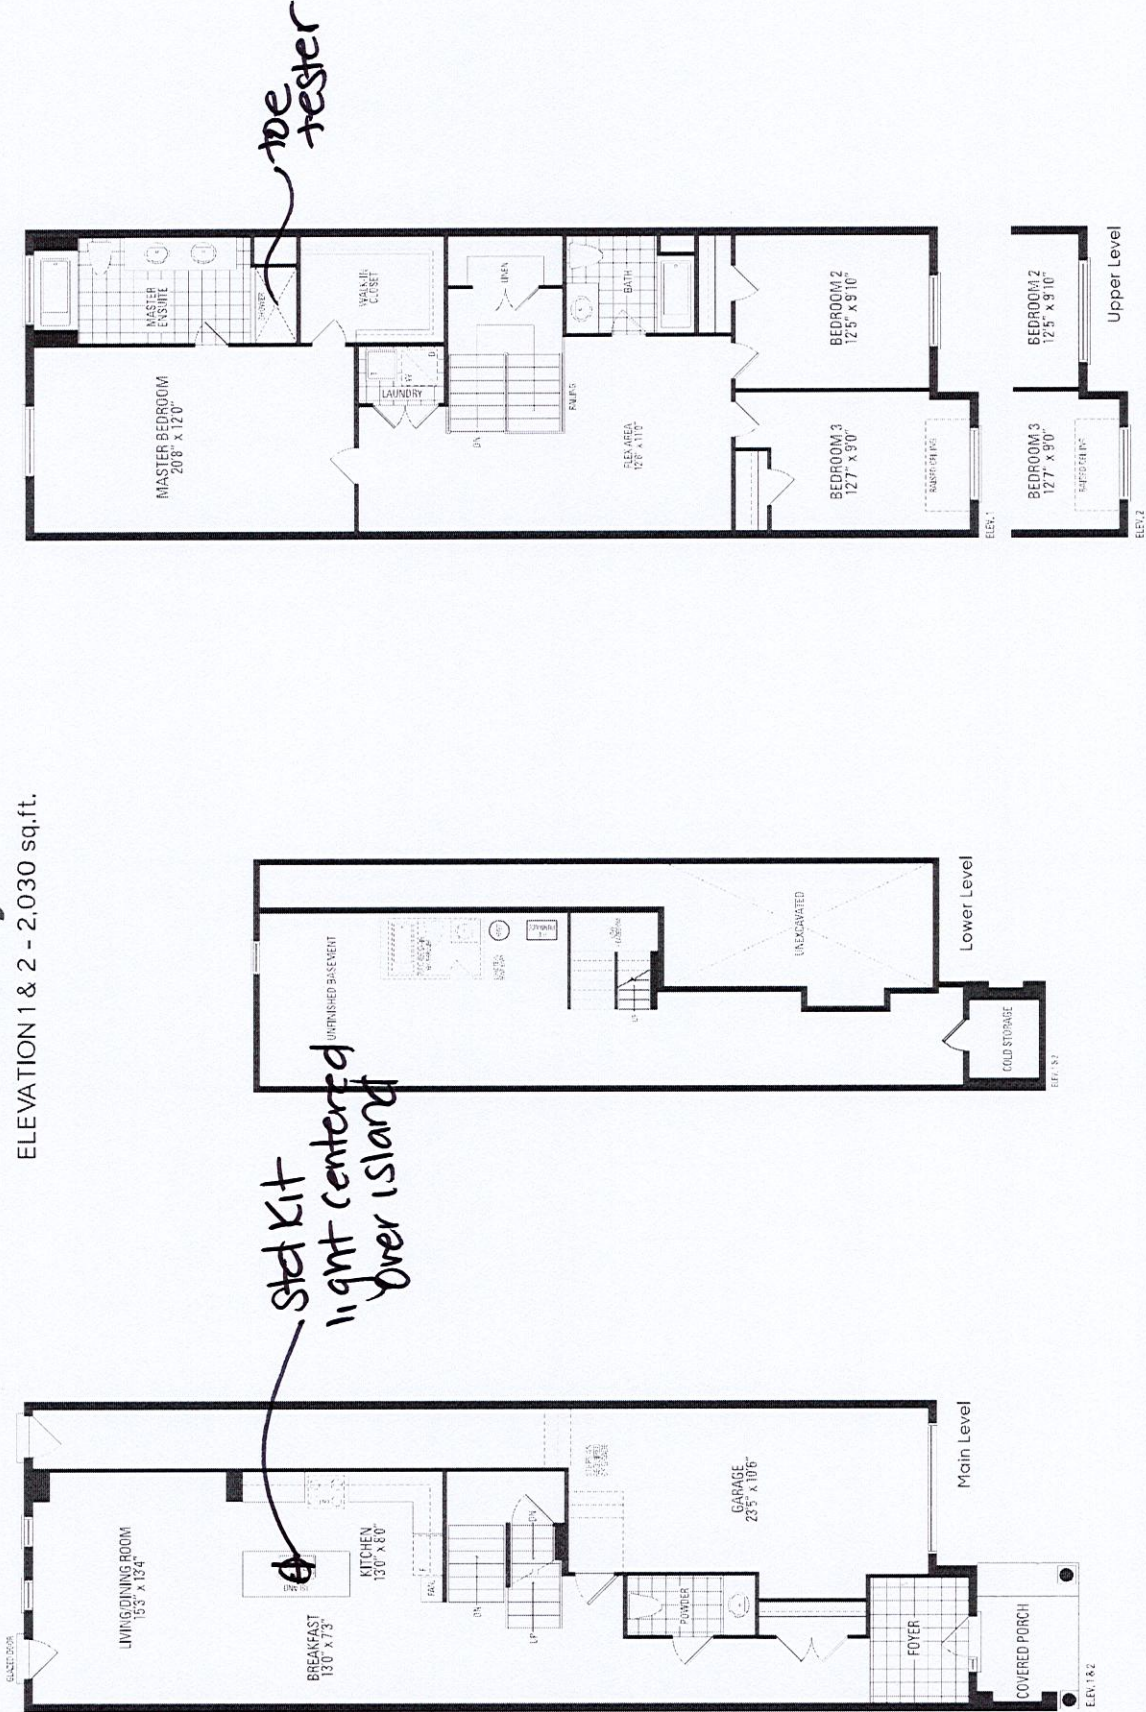

Orientation of home may be reversed and purchaser agrees to accept the same. Steps and porches may vary at any exterior entrance ways due to grading variance. Actual usable floor space may vary from the stated floor areas. All renderings are artist's concept. Dimensions, specifications and architectural detailing subject to modifications. Roofline and adjoining model types may vary due to siting. E. & O.E. October 2022