

CONSTRUCTION SUMMARY

Hazel Glenn - Barlassina Construction Inc.

PURCHASER: BIKRAMJIT SINGH

TEL: RES.: 647-588-2144

|                                   |             |                                |  |  |
|-----------------------------------|-------------|--------------------------------|--|--|
| LOT / PHASE<br>Block 119 TH36 / 1 | REG. PLAN # | HOUSE TYPE<br>Cherry 12 Elev 1 |  |  |
|-----------------------------------|-------------|--------------------------------|--|--|

CONSTRUCTION

|                                                                                                                                                                     |  |
|---------------------------------------------------------------------------------------------------------------------------------------------------------------------|--|
| 1 - FRAMELESS GLASS SHOWER ENCLOSURE PROVISION - REMOVE SIDE WALL AND REPLACE WITH GLASS TO ACCOMODATE FRAMELESS GLASS SHOWER ENCLOSURE SEE SKETCH<br>15Mar23 Note: |  |
|---------------------------------------------------------------------------------------------------------------------------------------------------------------------|--|

ELECTRICAL

|                                                                                                                                                          |  |
|----------------------------------------------------------------------------------------------------------------------------------------------------------|--|
| 3 - FAN - BATHROOM EXHAUST FAN - ENERGY STAR 80 CFM - IN LIEU OF STANDARD FAN- IN ALL SECOND FLOOR BATHROOMS- NOT INCLUDING POWDER ROOM<br>15Mar23 Note: |  |
| 1 - ABOVE KITCHEN ISLAND - ADD LIGHT AND SWITCH - NO FIXTURE INCLUDED<br>15Mar23 Note:                                                                   |  |
| 1 - PLUG - ELECTRICAL PLUG WITH GFI AND SWITCH - FOR FESTIVE LIGHTING<br>15Mar23 Note:                                                                   |  |

FIREPLACE AND ACCESSORIES

|                                                                                             |  |
|---------------------------------------------------------------------------------------------|--|
| 1 - GAS LINE ROUGH-IN FOR STOVE (INCLUDES ELECTRICAL OUTLET) - FIRST FLOOR<br>15Mar23 Note: |  |
|---------------------------------------------------------------------------------------------|--|

MIRRORS AND GLASS

|                                                                                                          |  |
|----------------------------------------------------------------------------------------------------------|--|
| 1 - MASTER ENSUITE – FRAMELESS GLASS SHOWER ENCLOSURE – INCLUDES CHROME KNOB AND HINGES<br>15Mar23 Note: |  |
|----------------------------------------------------------------------------------------------------------|--|

PLUMBING

|                                                                                                  |  |
|--------------------------------------------------------------------------------------------------|--|
| 1 - WATER LINE FOR FRIDGE - ROUGH-IN ONLY<br>15Mar23 Note:                                       |  |
| 2 - TOE TESTER - ADD TOE TESTER TO SHOWER- MASTER ENSUITE AND ENSUITE 3 SHOWERS<br>15Mar23 Note: |  |
| 1 - WASHROOM - 3 PIECE ROUGH-IN IN BASEMENT<br>15Mar23 Note:                                     |  |

PROMOTIONAL

|                                                                                                                                                                                        |  |
|----------------------------------------------------------------------------------------------------------------------------------------------------------------------------------------|--|
| 1 - PARTIAL REDEMPTION OF PROMOTIONAL PACKAGE \$8,960 BALANCE FORWARD \$1,040 TO BE USED AT A LATER DATE. ORIGINAL PROMOTIONAL PACKAGE OF \$10,000 AS PER SCHEDULE PE<br>15Mar23 Note: |  |
|----------------------------------------------------------------------------------------------------------------------------------------------------------------------------------------|--|

This Document is Extremely Time Sensitive - Printed 15 Mar 23 at 13:45


BLK 119TH36

# Cherry 12

ELEVATION 1 - 2,325 sq.ft. • ELEVATION 2 - 2,354 sq.ft.

Frameless glass enclosure

add to test

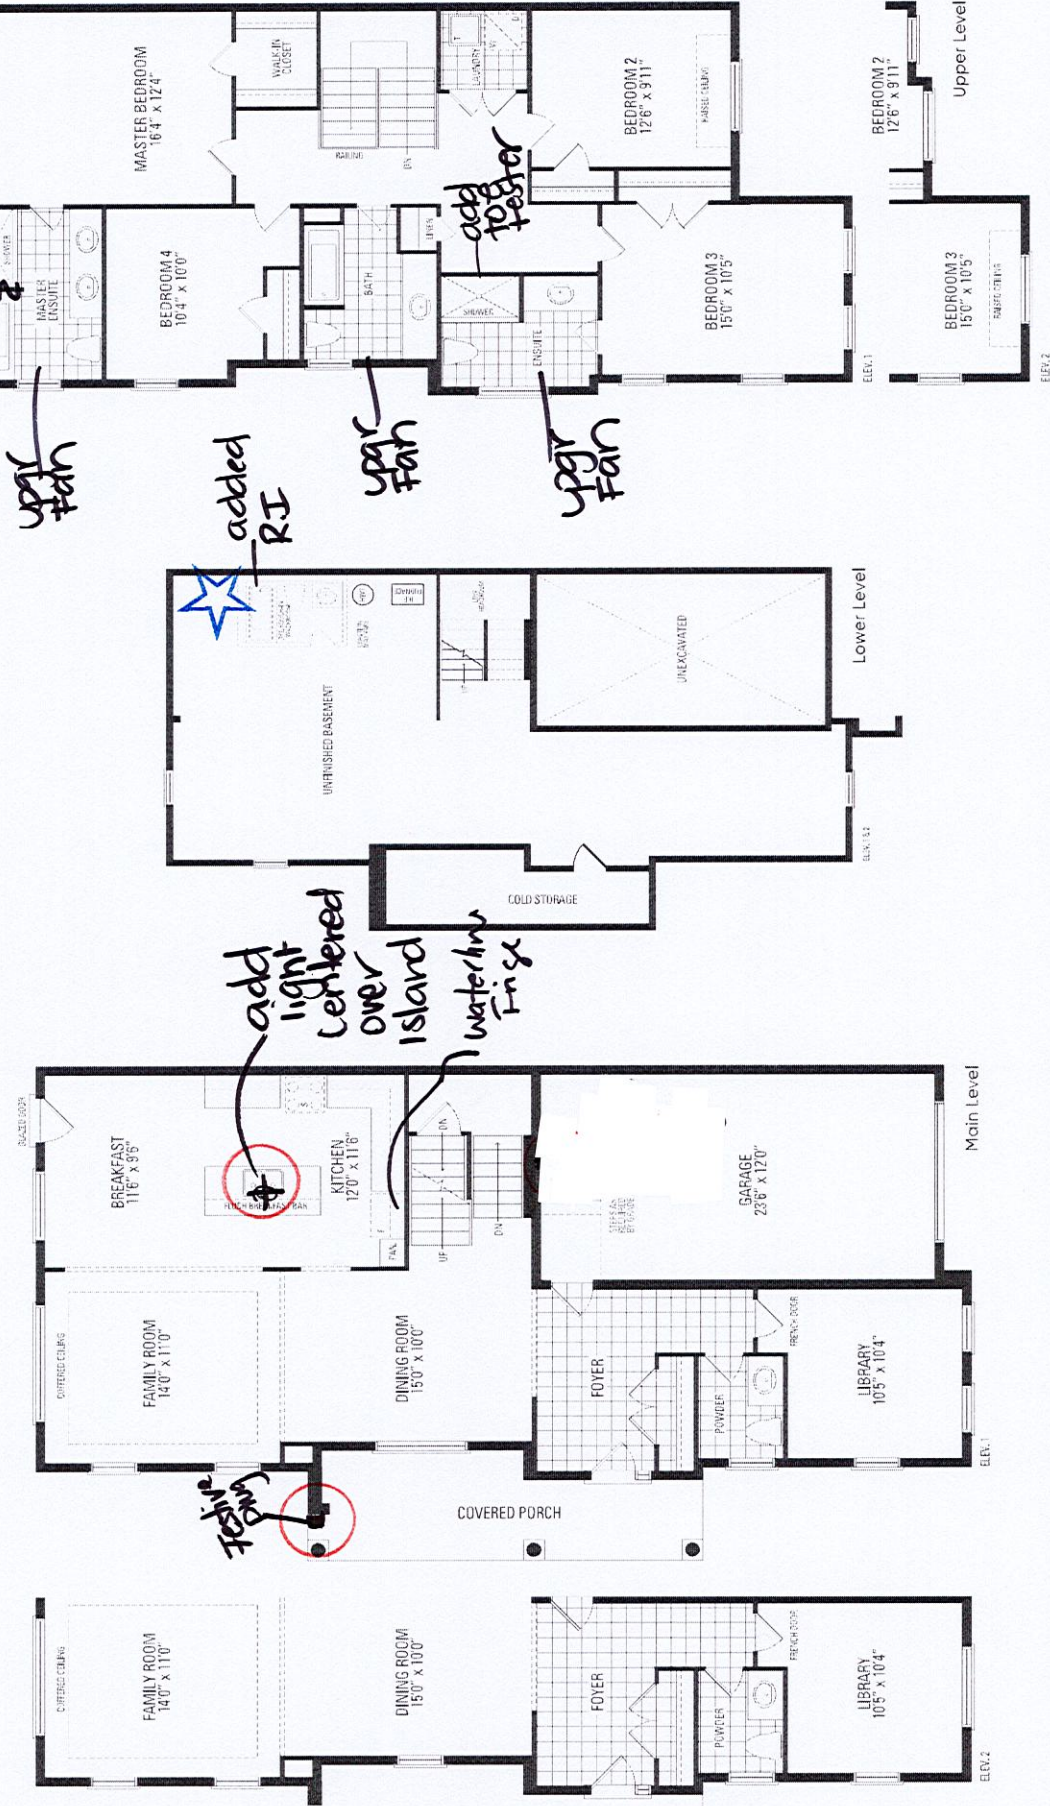

Orientation of home may be reversed and purchaser agrees to accept the same. Steps and porches may vary at any exterior entrance ways due to grading variance. Actual usable floor space may vary from the stated floor areas. All renderings are artist's concept. Dimensions, specifications and architectural detailing subject to modifications. Roofline and adjoining model types may vary due to siting. E. & O.E. October 2022