

CONSTRUCTION SUMMARY

Hazel Glenn - Barlassina Construction Inc.

PURCHASERS: Kiran PAUDEL and Bhawani KHADKA PAUDAYAL

TEL: RES.: 647-228-5920

|                                   |             |                               |  |  |
|-----------------------------------|-------------|-------------------------------|--|--|
| LOT / PHASE<br>Block 119 TH27 / 1 | REG. PLAN # | HOUSE TYPE<br>Cherry 1 Elev 2 |  |  |
|-----------------------------------|-------------|-------------------------------|--|--|

ELECTRICAL

|                                                                                                                               |  |
|-------------------------------------------------------------------------------------------------------------------------------|--|
| 1 - STANDARD DINING ROOM LIGHT TO BE CENTERED BETWEEN LIVING AND DINING ROOM<br>15Mar23 Note:                                 |  |
| 1 - PLUG - ELECTRICAL PLUG- 5FT FROM FLOOR FR FUTURE WALL MOUNTED TV- LIVING ROOM<br>SEE SKETCH FOR LOCATION<br>15Mar23 Note: |  |
| 1 - ABOVE KITCHEN ISLAND - ADD LIGHT AND SWITCH - NO FIXTURE INCLUDED<br>15Mar23 Note:                                        |  |

FIREPLACE AND ACCESSORIES

|                                                                                             |  |
|---------------------------------------------------------------------------------------------|--|
| 1 - GAS LINE ROUGH-IN FOR STOVE (INCLUDES ELECTRICAL OUTLET) - FIRST FLOOR<br>15Mar23 Note: |  |
|---------------------------------------------------------------------------------------------|--|

MISCELLANEOUS

|                                                                                                                                                    |  |
|----------------------------------------------------------------------------------------------------------------------------------------------------|--|
| 1 - GARAGE DOOR OPENER – LIFEMASTER 8155 WITH BELT DRIVE – INLCUDES 1 KEYPAD AND 2 HANDHELD CONTROL -<br>PRICE IS PER GARAGE DOOR<br>15Mar23 Note: |  |
|----------------------------------------------------------------------------------------------------------------------------------------------------|--|

PLUMBING

|                                                              |  |
|--------------------------------------------------------------|--|
| 1 - WASHROOM - 3 PIECE ROUGH-IN IN BASEMENT<br>15Mar23 Note: |  |
|--------------------------------------------------------------|--|

PROMOTIONAL




|                                                                                                                                                                                           |  |
|-------------------------------------------------------------------------------------------------------------------------------------------------------------------------------------------|--|
| 1 - PARTIAL REDEMPTION OF PROMOTIONAL PACKAGE \$3,800 BALANCE FORWARD \$6,200 TO BE USED AT A LATER DATE.<br>ORIGINAL PROMOTIONAL PACKAGE OF \$10,000 AS PER SCHEDULE PE<br>15Mar23 Note: |  |
|-------------------------------------------------------------------------------------------------------------------------------------------------------------------------------------------|--|

This Document is Extremely Time Sensitive - Printed 15 Mar 23 at 14:07



# Cherry 1

ELEVATION 1 - 1,951 sq.ft. • ELEVATION 2 - 1,960 sq.ft.  
Includes 14 sq.ft. of open area

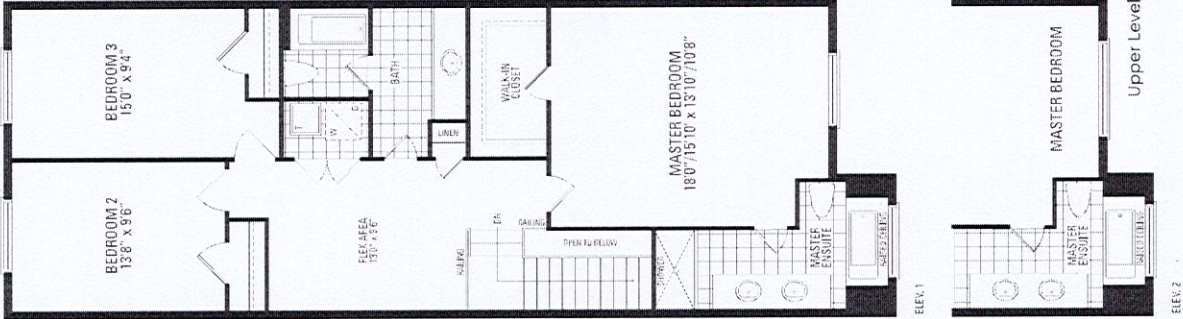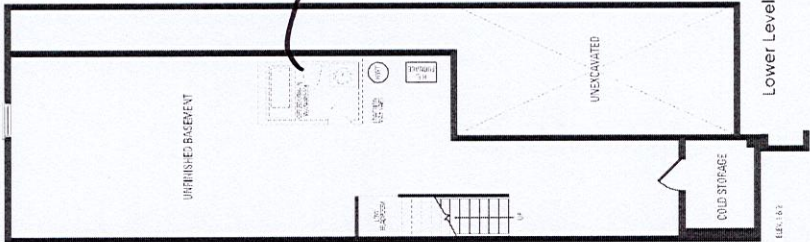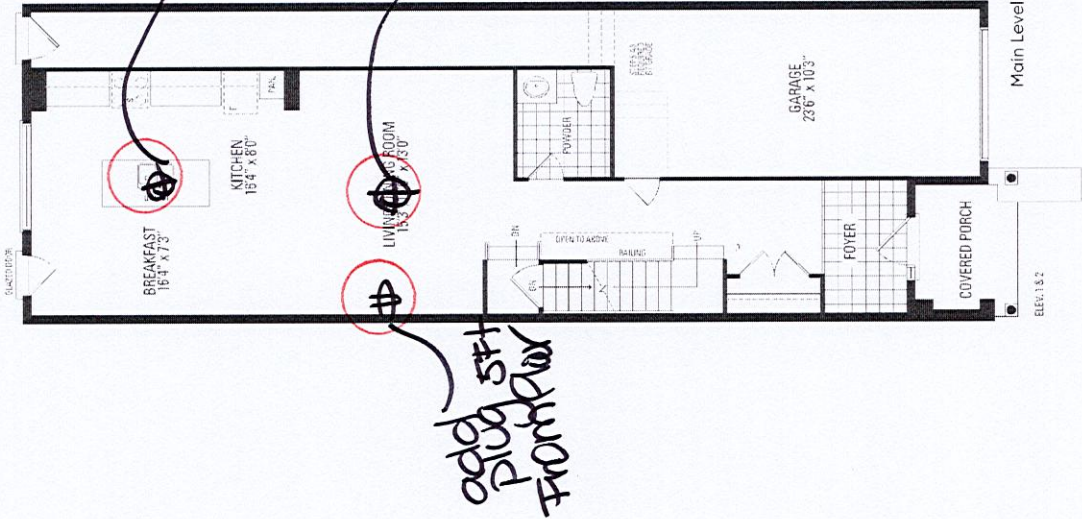

Orientation of home may be reversed and purchaser agrees to accept the same. Steps and porches may vary at any exterior entrance ways due to grading variance. Actual usable floor space may vary from the stated floor areas. All renderings are artist's concept. Dimensions, specifications and architectural detailing subject to modifications. Roofline and adjoining model types may vary due to siting. E. & O.E. October 2022