

DOOR SHEDULE:

- 1 = 2'-10" x 6'-8" INSULATED ENTRANCE DOOR  
1A = 2'-8" x 6'-8" INSULATED ENTRANCE DOOR  
2 = 2'-8" x 6'-8" EXTERIOR GLAZED DOOR  
3 = 2'-8" x 6'-8" SLAB DOOR (1 3/4" EXTERIOR)  
4 = 2'-8" x 6'-8" SLAB DOOR (1 3/8" INTERIOR)  
5 = 2'-6" x 6'-8" SLAB DOOR (1 3/8" INTERIOR)  
6 = 2'-2" x 6'-8" SLAB DOOR (1 3/8" INTERIOR)  
7 = 1'-6" x 6'-8" SLAB DOOR (1 3/8" INTERIOR)  
8 = 2'-6" x 6'-8" BI-FOLD (1 3/8" INTERIOR)  
9 = 3'-0" x 6'-8" BI-FOLD (1 3/8" INTERIOR)  
10= 2- 2'-0" x 6'-8" BI-FOLD (1 3/8" INTERIOR)  
11= 2- 2'-6" x 6'-8" BI-FOLD (1 3/8" INTERIOR)  
12 = 2'-6" x 6'-8" FRENCH DOOR (1 3/8" INTERIOR)

PAD FOOTING

120 KPa NATIVE SOIL	90 KPa ENGINEERED FILL SOIL
F1 = 42"x42"x18" CONCRETE PAD	F1 = 48"x48"x20" CONCRETE PAD
F2 = 36"x36"x16" CONCRETE PAD	F2 = 40"x40"x16" CONCRETE PAD
F3 = 30"x30"x12" CONCRETE PAD	F3 = 34"x34"x14" CONCRETE PAD
F4 = 24"x24"x12" CONCRETE PAD	F4 = 28"x28"x12" CONCRETE PAD
F5 = 16"x16"x8" CONCRETE PAD	F5 = 18"x18"x8" CONCRETE PAD
(REFER TO FLOOR PLAN FOR UNUSUAL SIZE PADS NOT ON CHART)	

NOTE:

WHEN VENEER CUT IS GREATER THAN 26" A 10" POURED CONC. FOUNDATION WALL IS REQUIRED.

NOTE:

ALL GARAGE SLABS, PORCH SLABS, STAIRS (EXPOSED CONC. FLAT WORK) TO BE 32 MPa WITH 5-8% AIR ENTRAINMENT.

BRICK VENEER LINTELS:

WL1 = 3 1/2" x 3 1/2" x 1 1/4" (90x90x6) + 2- 2" x 8" SPR.	WL6 = 5" x 3 1/2" x 5 1/6" (125x90x8) + 2- 2" x 12" SPR.
WL2 = 4" x 3 1/2" x 5 1/6" (100x90x8) + 2- 2" x 8" SPR.	WL7 = 5" x 3 1/2" x 5 1/6" (125x90x8) + 3- 2" x 10" SPR.
WL3 = 5" x 3 1/2" x 5 1/6" (125x90x8) + 2- 2" x 10" SPR.	WL8 = 5" x 3 1/2" x 5 1/6" (125x90x8) + 3- 2" x12" SPR.
WL4 = 6" x 3 1/2" x 3/8" (150x90x10) + 2- 2" x 12" SPR.	WL9 = 6" x 4" x 3/8" (150x100x10) + 3- 2" x 12" SPR.
WL5 = 6" x 4" x 3/8" (150x100x10) + 2- 2" x 12" SPR.	

WOOD LINTELS:

WB1 = 2- 2" x 8" SPRUCE BEAM	WB6 = 3- 2" x 12" SPRUCE BEAM
WB2 = 3- 2" x 8" SPRUCE BEAM	WB7 = 5- 2" x 12" SPRUCE BEAM
WB3 = 2- 2" x 10" SPRUCE BEAM	WB10 = 4- 2" x 8" SPRUCE BEAM
WB4 = 3- 2" x 10" SPRUCE BEAM	WB11 = 4- 2" x 10" SPRUCE BEAM
WB5 = 2- 2" x 12" SPRUCE BEAM	

STEEL LINTELS:

L1 = 3 1/2 x 3 1/2 x 1 1/4" (90 x 90 x 6)	L4 = 6" x 3 1/2" x 3/8" (150 x 90 x 10)
L2 = 4" x 3 1/2" x 5 1/6" (100 x 90 x 8)	L5 = 6" x 4" x 3/8" (150 x 100 x 10)
L3 = 5" x 3 1/2" x 5 1/6" (125 x 90 x 8)	L6 = 7" x 4" x 3/8" (180 x 100 x 10)

LAMINATED VENEER LUMBER (LVL BEAMS)

LVL1A =	1-1 3/4" x 7 1/4" (1-45x184)
LVL1 =	2-1 3/4" x 7 1/4" (2-45x184)
LVL2 =	3-1 3/4" x 7 1/4" (3-45x184)
LVL3 =	4-1 3/4" x 7 1/4" (4-45x184)
LVL4A =	1-1 3/4" x 9 1/2" (1-45x240)
LVL4 =	2-1 3/4" x 9 1/2" (2-45x240)
LVL5 =	3-1 3/4" x 9 1/2" (3-45x240)
LVL5A =	4-1 3/4" x 9 1/2" (4-45x240)
LVL6A=	1-1 3/4" x 11 7/8" (1-45x300)
LVL6 =	2-1 3/4" x 11 7/8" (2-45x300)
LVL7 =	3-1 3/4" x 11 7/8" (3-45x300)
LVL7A=	4-1 3/4" x 11 7/8" (4-45x300)
LVL8 =	2-1 3/4" x 14" (2-45x356)
LVL9 =	3-1 3/4" x 14" (3-45x356)



PROVIDE P.ENG APPROVED TRUSS & FLOOR DRAWINGS AND SPECIFICATIONS TO BUILDING INSPECTOR AT FRAMING INSPECTION

INSTALLATION OF FLUSH STEEL BEAMS SHALL CONFORM TO THE REQUIREMENTS OF 9.23.9.2.(3), (4) & (5)

P.ENG SOILS REPORT MAY BE REQ'D TO CONFIRM BEARING CAPACITY OF SOILS. SEE FIELD INSPECTOR

FINAL GRADING CERTIFICATE REQ'D BEFORE FINAL INSPECTION SIGN-OFF

ENERGY PERFORMANCE LABELS FOR ALL GLAZING PRODUCTS IDENTIFYING THE CERTIFIED VALUES SHALL REMAIN ON FOR REVIEW DURING CONSTRUCTION

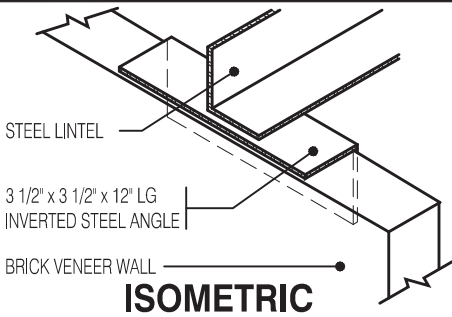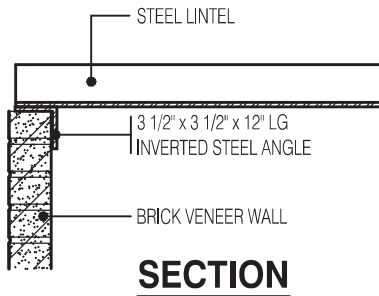

INVERTED STEEL ANGLE DETAIL

Scale: 3/4" = 1'-0"

WILLOW 1 ELEV.-1		ENERGY EFFICIENCY- SB12	
ELEVATION	WALL FT²	OPENING FT²	PERCENTAGE
FRONT	404.71	76.52	18.91 %
LEFT SIDE	1096.26	0.00	0.00 %
RIGHT SIDE	1096.26	0.00	0.00 %
REAR	379.06	82.74	21.83 %
TOTAL	2976.29	159.26	5.35 %

WILLOW 1 ELEV.-2		ENERGY EFFICIENCY- SB12	
ELEVATION	WALL FT²	OPENING FT²	PERCENTAGE
FRONT	394.90	83.17	21.06 %
LEFT SIDE	1088.76	0.00	0.00 %
RIGHT SIDE	1088.76	0.00	0.00 %
REAR	379.06	82.74	21.83 %
TOTAL	2951.48	165.91	5.62 %

WILLOW 1 ELEV.-3		ENERGY EFFICIENCY- SB12	
ELEVATION	WALL FT²	OPENING FT²	PERCENTAGE
FRONT	394.90	76.52	19.38 %
LEFT SIDE	1089.66	0.00	0.00 %
RIGHT SIDE	1089.66	0.00	0.00 %
REAR	379.06	82.74	21.83 %
TOTAL	2953.28	159.26	5.39 %

NOTE:

THESE DRAWINGS ARE TO BE READ IN CONJUNCTION WITH ENGINEER APPROVED DRAWINGS NOR INSPECTIONS MADE DURING INSTALLATION BY THE OFFICIAL HAVING JURISDICTION SHALL RELIEVE THE OWNER FROM REQUIREMENTS OF THE ONTARIO BUILDING CODE AND ANY OTHER REFERENCED REQUIREMENTS.

NOTE:

SPACE CONVENTIONAL FLOOR JOISTS @ 12" O.C. BELOW ALL CERAMIC TILE AREAS. PROVIDE 1 ROW BRIDGING FOR SPANS OF 5'-7", 2 ROWS FOR SPANS GREATER THAN 7'

NOTE:

THESE DRAWINGS ARE TO BE READ IN CONJUNCTION WITH ENGINEER APPROVED FLOOR TRUSS LAYOUT BY MANUFACTURER .

NOTE:

PLANS NOT DRAWN TO ACTUAL GRADE. REFER TO FINAL GRADING PLAN.

MASTER PLAN  
MODEL: WILLOW 1  
BEDROOMS: 3  
OPTIONS: (SAME AS ABOVE PLUS), 3-PC ROUGH-IN, 30"x24" BASEMENT WINDOW, SUNKEN MUDROOM

Block 122 Units 43 to 48

AREA CALCULATIONS EL-1

FIRST FLOOR AREA	=	706 Sq. Ft.
SECOND FLOOR AREA	=	990 Sq. Ft.
TOTAL FLOOR AREA	=	1696 Sq. Ft.
ADD OPEN AREAS	=	0 Sq. Ft.
ADD FIN. BASEMENT AREA	=	0 Sq. Ft.
GROSS FLOOR AREA	=	1696 Sq. Ft.
GROUND FLOOR COVERAGE	=	706 Sq. Ft.
GARAGE COVERAGE / AREA	=	343 Sq. Ft.
PORCH COVERAGE / AREA	=	71 Sq. Ft.
COVERAGE W/ PORCH	=	1049 Sq. Ft.
	=	97.46 Sq. m.
COVERAGE W/O PORCH	=	1120 Sq. Ft.
	=	104.05 Sq. m.

AREA CALCULATIONS EL-2

FIRST FLOOR AREA	=	706 Sq. Ft.
SECOND FLOOR AREA	=	990 Sq. Ft.
TOTAL FLOOR AREA	=	1696 Sq. Ft.
ADD OPEN AREAS	=	0 Sq. Ft.
ADD FIN. BASEMENT AREA	=	0 Sq. Ft.
GROSS FLOOR AREA	=	1696 Sq. Ft.
GROUND FLOOR COVERAGE	=	706 Sq. Ft.
GARAGE COVERAGE / AREA	=	343 Sq. Ft.
PORCH COVERAGE / AREA	=	71 Sq. Ft.
COVERAGE W/ PORCH	=	1049 Sq. Ft.
	=	97.46 Sq. m.
COVERAGE W/O PORCH	=	1120 Sq. Ft.
	=	104.05 Sq. m.

AREA CALCULATIONS EL-3

FIRST FLOOR AREA	=	706 Sq. Ft.
SECOND FLOOR AREA	=	990 Sq. Ft.
TOTAL FLOOR AREA	=	1696 Sq. Ft.
ADD OPEN AREAS	=	0 Sq. Ft.
ADD FIN. BASEMENT AREA	=	0 Sq. Ft.
GROSS FLOOR AREA	=	1696 Sq. Ft.
GROUND FLOOR COVERAGE	=	706 Sq. Ft.
GARAGE COVERAGE / AREA	=	343 Sq. Ft.
PORCH COVERAGE / AREA	=	71 Sq. Ft.
COVERAGE W/ PORCH	=	1049 Sq. Ft.
	=	97.46 Sq. m.
COVERAGE W/O PORCH	=	1120 Sq. Ft.
	=	104.05 Sq. m.

CITY OF CAMBRIDGE  
BUILDING DIVISION

THESE PLANS have been examined for compliance with the Ontario Building Code Requirements. A Building Permit is in Order to issue subject to any changes noted under the condition that the building will be constructed in accordance with the code

03/10/2023  
INSPECTOR

DATE

1696

6.10m LOTS

WILLOW 1 (GR)  
ELEVATION 1, 2 & 3

A1 PACKAGE

O.REG. 332/12

THE CONTRACTOR SHALL CHECK AND VERIFY ALL DIMENSIONS AND CONDITIONS ON SITE BEFORE PROCEEDING WITH CONSTRUCTION. ANY DISCREPANCIES SHALL BE REPORTED TO JARDIN DESIGN GROUP INC. PRIOR TO COMMENCEMENT OF WORK.

JARDIN DESIGN GROUP INC. IS NOT RESPONSIBLE FOR THE ACCURACY OF SURVEY, STRUCTURAL OR ENGINEERING INFORMATION SHOWN ON THESE DRAWINGS OR FOR CONSTRUCTION STARTED PRIOR TO THE ISSUANCE OF A BUILDING PERMIT. REFER TO THE APPROPRIATE ENGINEERING DRAWINGS BEFORE PROCEEDING WITH WORK.

AS CONSTRUCTED INVERTS MUST BE VERIFIED PRIOR TO POURING FOOTINGS.

JARDIN DESIGN GROUP INC. HAS NOT BEEN RETAINED TO CARRY OUT GENERAL REVIEW OF THE WORK AND ASSUMES NO RESPONSIBILITY FOR THE FAILURE OF THE CONTRACTOR OR SUB CONTRACTOR TO CARRY OUT THE WORK IN ACCORDANCE WITH THE CONTRACT DOCUMENTS.

THIS DRAWING IS AN INSTRUMENT OF SERVICE. IS PROVIDED BY AND IS THE PROPERTY OF JARDIN DESIGN GROUP INC. THIS DRAWING IS NOT TO BE SCALED.

7		
6		
5		
4	AUG. 31, 2022	ISSUED BUILDING PERMIT
3	AUG. 29, 2022	COORDINATED WITH FLOOR, ROOF & ENGINEER'S COMMENTS
2	JUNE 20, 2022	PREPARED TO PRE-COORDINATION STAGE & ISSUED TO CLIENT
1	MAR. 28, 2022	ISSUED TO CLIENT FOR BROCHURE

No: DATE: WORK DESCRIPTION:

jardin  
DESIGN GROUP INC  
64 JARDIN DR. SUITE 3A  
VAUGHAN ONT, L4K 3P3  
TEL: 905 660-3377 FAX: 905 660-3713  
EMAIL: info@jardindesign.ca

The undersigned has reviewed and takes responsibility for this design and has the qualifications and meets the requirements set out in the Ontario Building Code to be a designer

QUALIFICATION INFORMATION  
Required unless design is exempt under Division C, Subsection 3.2.5 of the building code

Walter Botter 21031  
NAME SIGNATURE BCIN

REGISTRATION INFORMATION  
Required unless design is exempt under Division C, Subsection 3.2.4 of the building code


jardin design group inc. 27763  
FIRM NAME BCIN

TITLE SHEET

BARLASSINA CONSTRUCTION  
CITY OF CAMBRIDGE

	MODEL:	
	WILLOW 1	
	SCALE:	
	3/16"= 1'-0"	
PROJ. No.	DWG. No.	
	21-35	0

STRUDET INC.

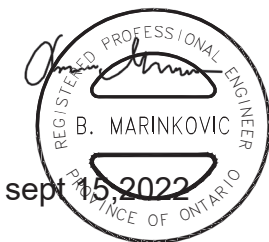

FOR STRUCTURE ONLY

It is the builder's complete responsibility to ensure that all plans submitted for approval fully comply with the Architectural Guidelines and all applicable regulations and requirements including zoning provisions and any provisions in the subdivision agreement. The Control Architect is not responsible in any way for examining or approving site (lotting) plans or working drawings with respect to any zoning or building code or permit matter or that any house can be properly built or located on its lot.

This is to certify that these plans comply with the applicable Architectural Design Guidelines approved by the City of CAMBRIDGE

LEGEND:

- BUILDING FACE < THAN 4'-0" (1.2m) (45 MIN. FIRE RATING REQ'D)
- INDICATES SOLID BEARING REQUIRED OR POINT LOAD FROM ABOVE
- STL. PLATE FOR STEEL COL'N ABOVE LAMINATED VENEER LUMBER
- S.J. SINGLE JOIST
- D.J. DOUBLE JOIST
- T.J. TRIPLE JOIST
- REPEAT NOTE
- SHOWER WEEPERS




**Basement Layout Details:**

- Overall Dimensions:** 58'-2" [17.73m] by 20'-0" [6.10m].
- Rooms and Features:**
  - UNEXCAVATED:** Two areas labeled "UNEXCAVATED REMOVE TOP SOIL ONLY".
  - OPTIONAL ROUGH-IN BATHROOM:** Located in the upper left, with dimensions 26'-9" x 3'-5".
  - HOT WATER:** Indicated by a red circle with "H.W." and a checkmark.
  - H.E. FURNACE:** Heating equipment location.
  - HRV:** Heat Recovery Ventilator location.
  - WB-1 (-1R):** Wall beam locations.
  - EVLC (FLUSH):** Electrical vertical load center locations.
  - BBFM (FLUSH):** Basement beam foundation locations.
  - 4"x4" WOOD COL'N ON CONC. FT'G.:** Column locations on concrete footings.
  - 11 7/8" ENG. APPR. FLR. JOIST SYSTEM:** Floor joist system details.
  - PERIMETER INSULATION:** Note: (SEE BUILDER'S SPEC'D COMPLIANCE PACKAGE).
  - NOTE:** PROVIDE GUARD OR 2x4 SPR. WALL FINISHED WITH 1/2" DRYWALL ONE SIDE AROUND BASEMENT STAIR AS PER 9.8.8.1(3).
  - SUMP:** Indicated by a red circle with "SUMP" and a checkmark.
  - 24"x24" BENT 10M DOWELS @ 23 5/8" O.C. ALL AROUND (TYP.):** Dowel locations for cold cellar.
  - LID TO BE SEALED:** Note for the sump area.
- Construction Notes:**
  - CHECK CONC. FDTN. FOR MAN DOOR ABOVE.
  - NON-LOAD BEARING WALLS NOT PERMITTED TO BE FRAMED (TYP.).
  - 2"x6" SPR. @ 16" O.C. BEARING PARTITION ON 14" WIDE x 6" DEEP CONC. FOOTING.
  - PROVIDE 2-20M REBARS TO EXTEND 3'-0" BEYOND OPENING @ EACH END W/ 1" CONC. COVER.
  - CHECK CONC. FDTN. FOR SUNKEN AREA ABOVE.
  - CHECK CONC. FDTN. FOR O/H DOOR ABOVE.

MODEL:		WILLOW 1	
SCALE:		3/16" = 1'-0"	
PROJ. No.	21-35	DWG. No.	1A



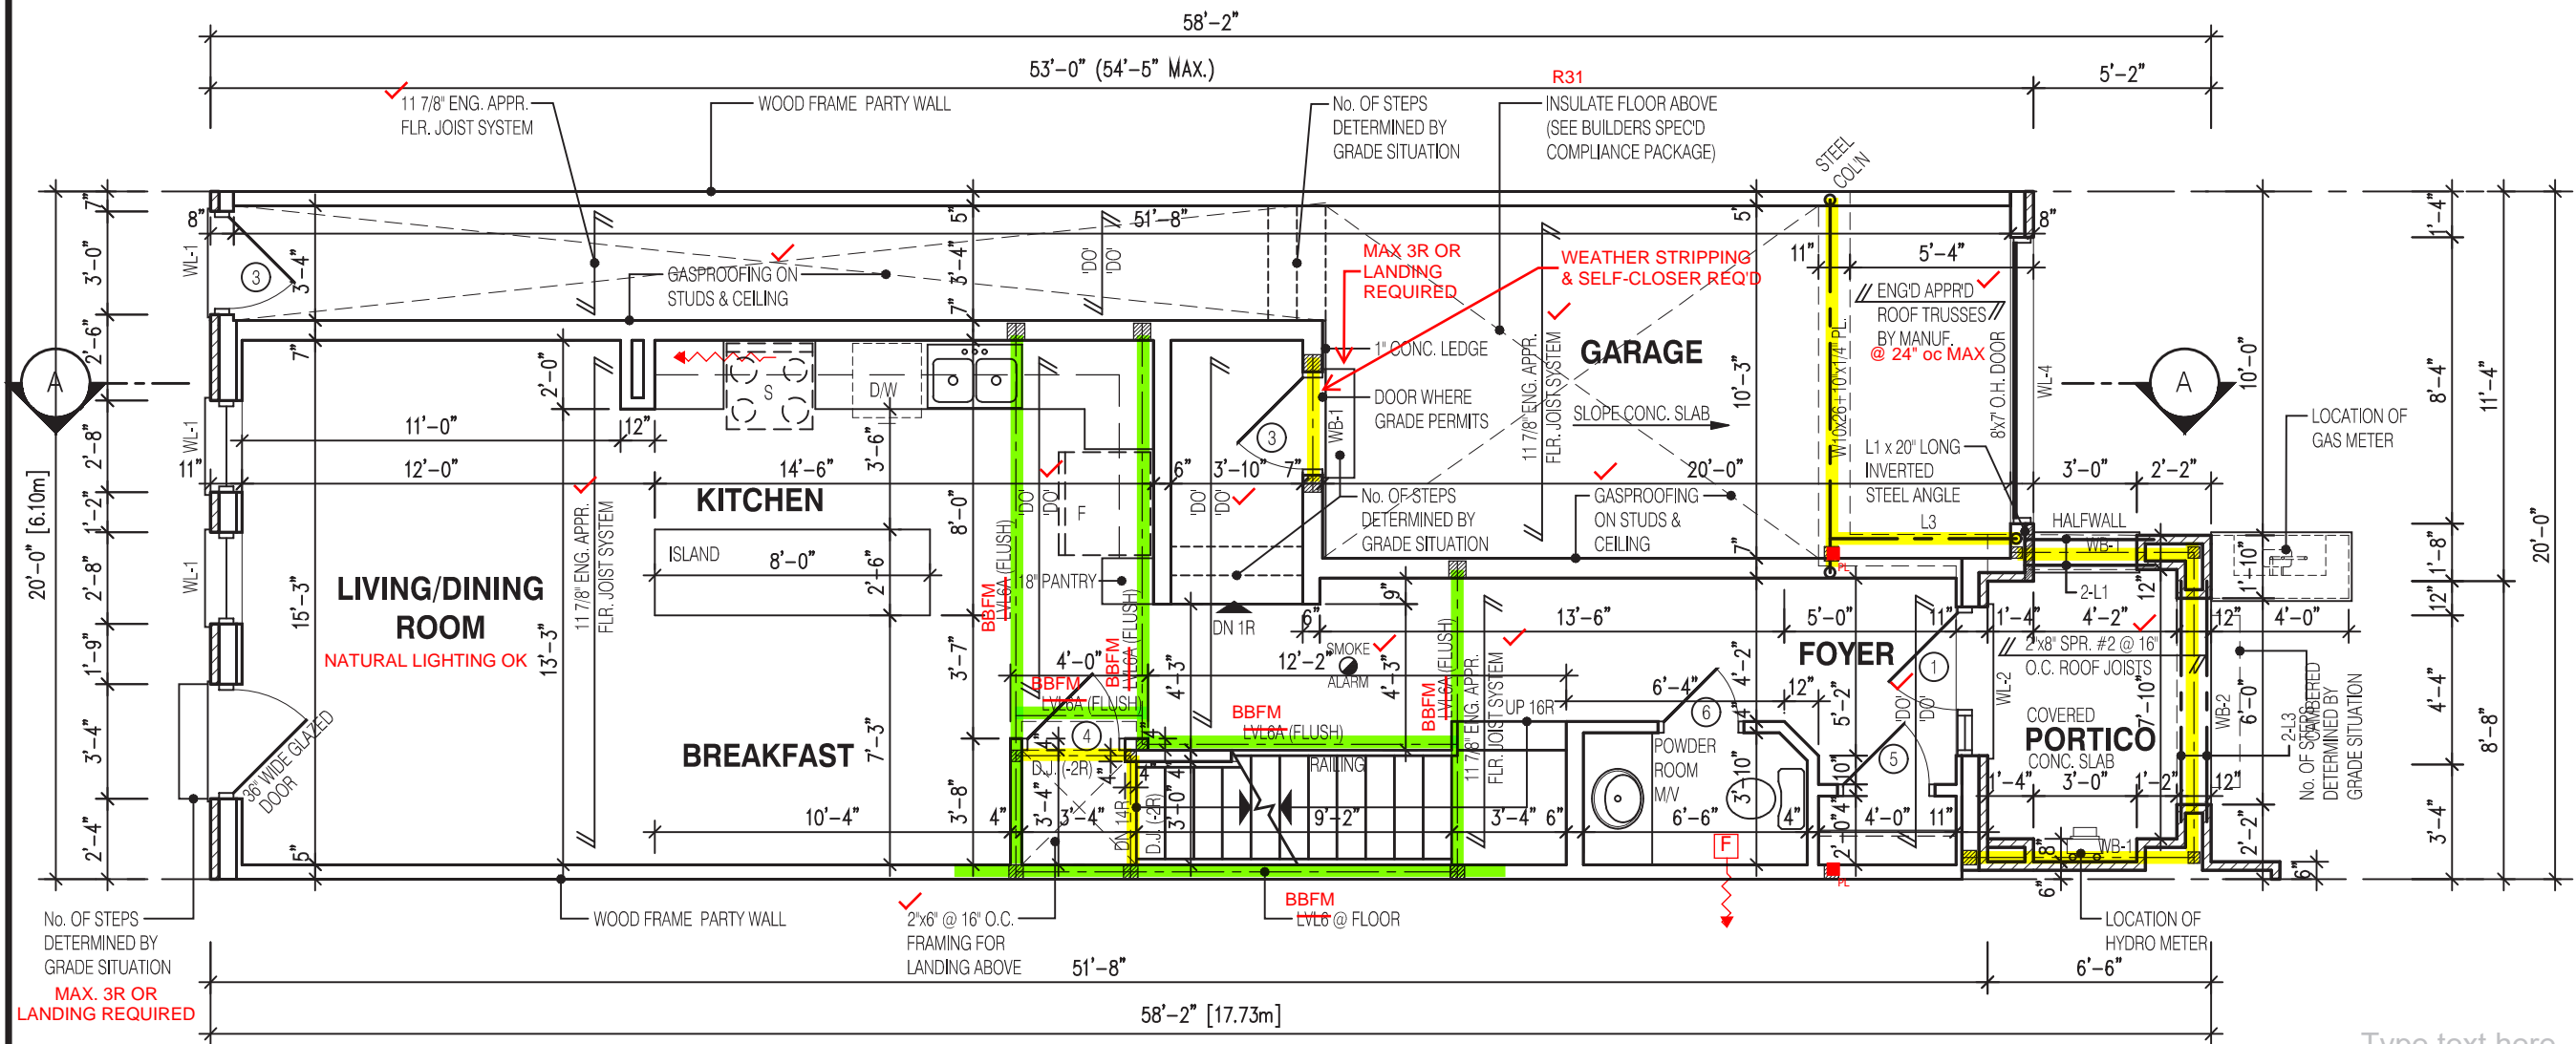

WILLOW 1  
FIRST FLOOR PLAN EL-2

NOT THE GRANTING OF A PERMIT NOR REVIEWING OF SPECS & DRAWINGS NOR INSPECTIONS MADE DURING INSTALLATION BY THE OFFICIAL HAVING JURISDICTION SHALL RELIEVE THE OWNER FROM REQUIREMENTS OF THE ONTARIO BUILDING CODE AND ANY OTHER REFERENCED REQUIREMENTS.

<b>NOTE:</b> THESE DRAWINGS ARE TO BE READ IN CONJUNCTION WITH ENGINEER APPROVED ROOF TRUSS DRAWINGS BY MANUFACTURER .	<b>NOTE:</b> SPACE CONVENTIONAL FLOOR JOISTS @ 12" O.C. BELOW ALL CERAMIC TILE AREAS. PROVIDE 1 ROW BRIDGING FOR SPANS OF 5'-7"; 2 ROWS FOR SPANS GREATER THAN 7'
<b>NOTE:</b> REFER TO SHEET NO. 0-1 FOR LINTEL, BEAMS AND DOOR SIZE	<b>NOTE:</b> THESE DRAWINGS ARE TO BE READ IN CONJUNCTION WITH ENGINEER APPROVED FLOOR TRUSS LAYOUT BY MANUFACTURER .

<b>NOTE:</b> SUBFLOOR TO BE 5/8" PLYWOOD ON THIS LEVEL  ALL FLOORS TO BE NAILED AND GLUED ON THIS LEVEL	<b>LEGEND:</b> ■ BUILDING FACE < THAN 4'-0" (1.2m) (45 MIN. FIRE RATING REQ'D) ■ INDICATES SOLID BEARING REQUIRED OR POINT LOAD FROM ABOVE ■ STL. PLATE FOR STEEL COL'N ABOVE LVL LAMINATED VENEER LUMBER S.J. SINGLE JOIST D.J. DOUBLE JOIST T.J. TRIPLE JOIST ○ REPEAT NOTE ○ SHOWER WEEPERS
--	---

It is the builder's complete responsibility to ensure that all plans submitted for approval fully comply with the Architectural Guidelines and all applicable regulations and requirements including zoning provisions and any provisions in the subdivision agreement. The Control Architect is not responsible in any way for examining or approving site (lotting) plans or working drawings with respect to any zoning or building code or permit matter or that any house can be properly built or located on its lot.

JOHN G. WILLIAMS LTD., ARCHITECT  
ARCHITECTURAL CONTROL REVIEW AND APPROVAL

APPROVED BY: [Signature]  
DATE: OCT 11, 2022

This stamp certifies compliance with the applicable Design Guidelines only and bears no further professional responsibility.

STRUDET INC.

REGISTERED PROFESSIONAL ENGINEER  
B. MARINKOVIC  
sept 15 2022  
MINISTRY OF ONTARIO

FOR STRUCTURE ONLY

1696

6.10m LOTS

WILLOW 1 (GR)  
ELEVATION 2

A1 PACKAGE

O.REG. 332/12

THE CONTRACTOR SHALL CHECK AND VERIFY ALL DIMENSIONS AND CONDITIONS ON SITE BEFORE PROCEEDING WITH CONSTRUCTION. ANY DISCREPANCIES SHALL BE REPORTED TO JARDIN DESIGN GROUP INC. PRIOR TO COMMENCEMENT OF WORK.

JARDIN DESIGN GROUP INC. IS NOT RESPONSIBLE FOR THE ACCURACY OF SURVEY, STRUCTURAL OR ENGINEERING INFORMATION SHOWN ON THESE DRAWINGS OR FOR CONSTRUCTION STARTED PRIOR TO THE ISSUANCE OF A BUILDING PERMIT. REFER TO THE APPROPRIATE ENGINEERING DRAWINGS BEFORE PROCEEDING WITH WORK.

AS CONSTRUCTED INVERTS MUST BE VERIFIED PRIOR TO POURING FOOTINGS.

JARDIN DESIGN GROUP INC. HAS NOT BEEN RETAINED TO CARRY OUT GENERAL REVIEW OF THE WORK AND ASSUMES NO RESPONSIBILITY FOR THE FAILURE OF THE CONTRACTOR OR SUB CONTRACTOR TO CARRY OUT THE WORK IN ACCORDANCE WITH THE CONTRACT DOCUMENTS.

THIS DRAWING IS AN INSTRUMENT OF SERVICE. IS PROVIDED BY AND IS THE PROPERTY OF JARDIN DESIGN GROUP INC. THIS DRAWING IS NOT TO BE SCALED.

7		
6		
5		
4	AUG. 31, 2022	ISSUED BUILDING PERMIT
3	AUG. 29, 2022	COORDINATED WITH FLOOR, ROOF & ENGINEER'S COMMENTS
2	JUNE 20, 2022	PREPARED TO PRE-COORDINATION STAGE & ISSUED TO CLIENT
1	MAR. 28, 2022	ISSUED TO CLIENT FOR BROCHURE

No:      DATE:      WORK DESCRIPTION:

jardin

DESIGN GROUP INC

64 JARDIN DR. SUITE 3A  
VAUGHAN ONT, L4K 3P3  
TEL: 905 660-3377 FAX: 905 660-3713  
EMAIL: info@jardindesign.ca

The undersigned has reviewed and takes responsibility for this design and has the qualifications and meets the requirements set out in the Ontario Building Code to be a designer

QUALIFICATION INFORMATION  
Required unless design is exempt under Division C, Subsection 3.2.5 of the building code

Walter Botter [Signature] 21031  
NAME SIGNATURE BCIN

REGISTRATION INFORMATION  
Required unless design is exempt under Division C, Subsection 3.2.4 of the building code

jardin design group inc. 27763  
FIRM NAME BCIN


FIRST FLOOR PLAN EL-2

BARLASSINA CONSTRUCTION  
CITY OF CAMBRIDGE

BILD	MODEL:	WILLOW 1
	SCALE:	3/16"= 1'-0"
	PROJ. No.	DWG. No.
	21-35	2A



NOT THE GRANTING OF A PERMIT NOR REVIEWING OF SPECS & DRAWINGS NOR INSPECTIONS MADE DURING INSTALLATION BY THE OFFICIAL HAVING JURISDICTION SHALL RELIEVE THE OWNER FROM REQUIREMENTS OF THE ONTARIO BUILDING CODE AND ANY OTHER REFERENCED REQUIREMENTS.

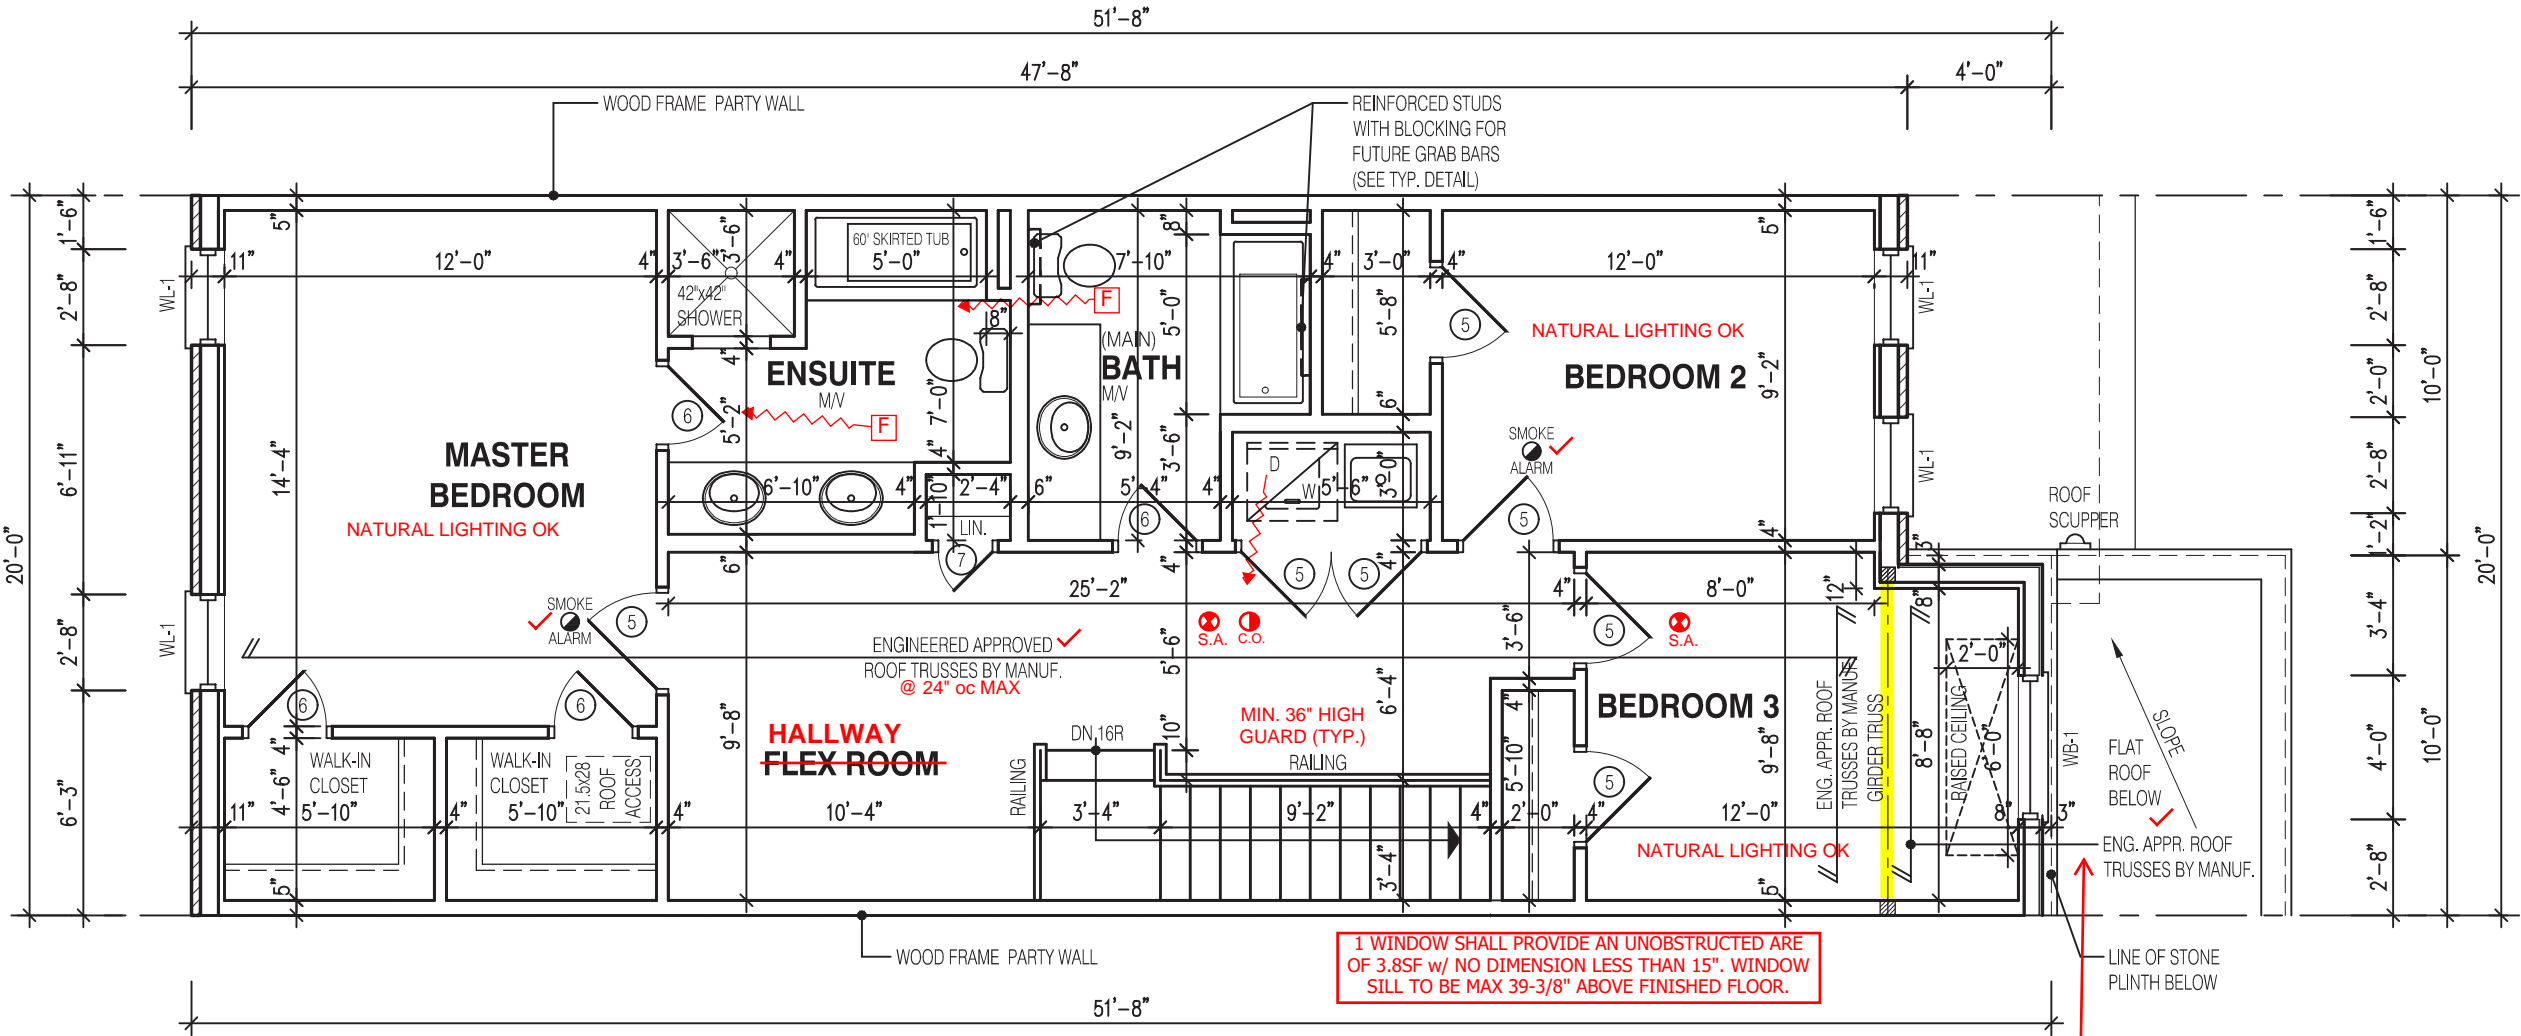

WILLOW 1  
SECOND FLOOR PLAN EL-2

**NOTE:**  
THESE DRAWINGS ARE TO BE READ IN CONJUNCTION WITH ENGINEER APPROVED ROOF TRUSS DRAWINGS BY MANUFACTURER.


- LEGEND:**
- BUILDING FACE < THAN 4'-0" (1.2m) (45 MIN. FIRE RATING REQ'D)
  - INDICATES SOLID BEARING REQUIRED OR POINT LOAD FROM ABOVE
  - STL. PLATE FOR STEEL COL'N ABOVE
  - LVL LAMINATED VENEER LUMBER
  - S.J. SINGLE JOIST
  - D.J. DOUBLE JOIST
  - T.J. TRIPLE JOIST
  - REPEAT NOTE
  - SHOWER WEEPERS

It is the builder's complete responsibility to ensure that all plans submitted for approval fully comply with the Architectural Guidelines and all applicable regulations and requirements including zoning provisions and any provisions in the subdivision agreement. The Control Architect is not responsible in any way for examining or approving site (lotting) plans or working drawings with respect to any zoning or building code or permit matter or that any house can be properly built or located on its lot.

This is to certify that these plans comply with the applicable Architectural Design Guidelines approved by the City of CAMBRIDGE

**JOHN G. WILLIAMS LTD., ARCHITECT**  
ARCHITECTURAL CONTROL REVIEW AND APPROVAL  
APPROVED BY:   
DATE: OCT 11, 2022  
This stamp certifies compliance with the applicable Design Guidelines only and bears no further professional responsibility.

STRUDET INC.

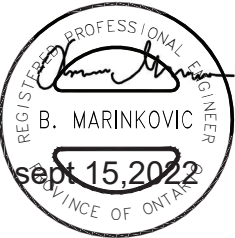

FOR STRUCTURE ONLY

1696  
6.10m LOTS  
WILLOW 1 (GR)  
ELEVATION 2  
A1 PACKAGE  
O.REG. 332/12

THE CONTRACTOR SHALL CHECK AND VERIFY ALL DIMENSIONS AND CONDITIONS ON SITE BEFORE PROCEEDING WITH CONSTRUCTION. ANY DISCREPANCIES SHALL BE REPORTED TO JARDIN DESIGN GROUP INC. PRIOR TO COMMENCEMENT OF WORK.  
JARDIN DESIGN GROUP INC. IS NOT RESPONSIBLE FOR THE ACCURACY OF SURVEY, STRUCTURAL OR ENGINEERING INFORMATION SHOWN ON THESE DRAWINGS OR FOR CONSTRUCTION STARTED PRIOR TO THE ISSUANCE OF A BUILDING PERMIT. REFER TO THE APPROPRIATE ENGINEERING DRAWINGS BEFORE PROCEEDING WITH WORK.  
AS CONSTRUCTED INVERTS MUST BE VERIFIED PRIOR TO POURING FOOTINGS.  
JARDIN DESIGN GROUP INC. HAS NOT BEEN RETAINED TO CARRY OUT GENERAL REVIEW OF THE WORK AND ASSUMES NO RESPONSIBILITY FOR THE FAILURE OF THE CONTRACTOR OR SUB CONTRACTOR TO CARRY OUT THE WORK IN ACCORDANCE WITH THE CONTRACT DOCUMENTS.  
THIS DRAWING IS AN INSTRUMENT OF SERVICE. IS PROVIDED BY AND IS THE PROPERTY OF JARDIN DESIGN GROUP INC. THIS DRAWING IS NOT TO BE SCALED.

7		
6		
5		
4	AUG. 31, 2022	ISSUED BUILDING PERMIT
3	AUG. 29, 2022	COORDINATED WITH FLOOR, ROOF & ENGINEER'S COMMENTS
2	JUNE 20, 2022	PREPARED TO PRE-COORDINATION STAGE & ISSUED TO CLIENT
1	MAR. 28, 2022	ISSUED TO CLIENT FOR BROCHURE

No: DATE: WORK DESCRIPTION:

**jardin**  
DESIGN GROUP INC  
64 JARDIN DR. SUITE 3A  
VAUGHAN ONT, L4K 3P3  
TEL: 905 660-3377 FAX: 905 660-3713  
EMAIL: info@jardindesign.ca

The undersigned has reviewed and takes responsibility for this design and has the qualifications and meets the requirements set out in the Ontario Building Code to be a designer  
QUALIFICATION INFORMATION  
Required unless design is exempt under Division C, Subsection 3.2.5 of the building code

Walter Botter 21031  
NAME SIGNATURE BCIN


REGISTRATION INFORMATION  
Required unless design is exempt under Division C, Subsection 3.2.4 of the building code

jardin design group inc. 27763  
FIRM NAME BCIN

SEC. FLOOR PLAN EL-2  
BARLASSINA CONSTRUCTION  
CITY OF CAMBRIDGE

MODEL: WILLOW 1  
SCALE: 3/16" = 1'-0"  
PROJ. No. 21-35 DWG. No. 3A



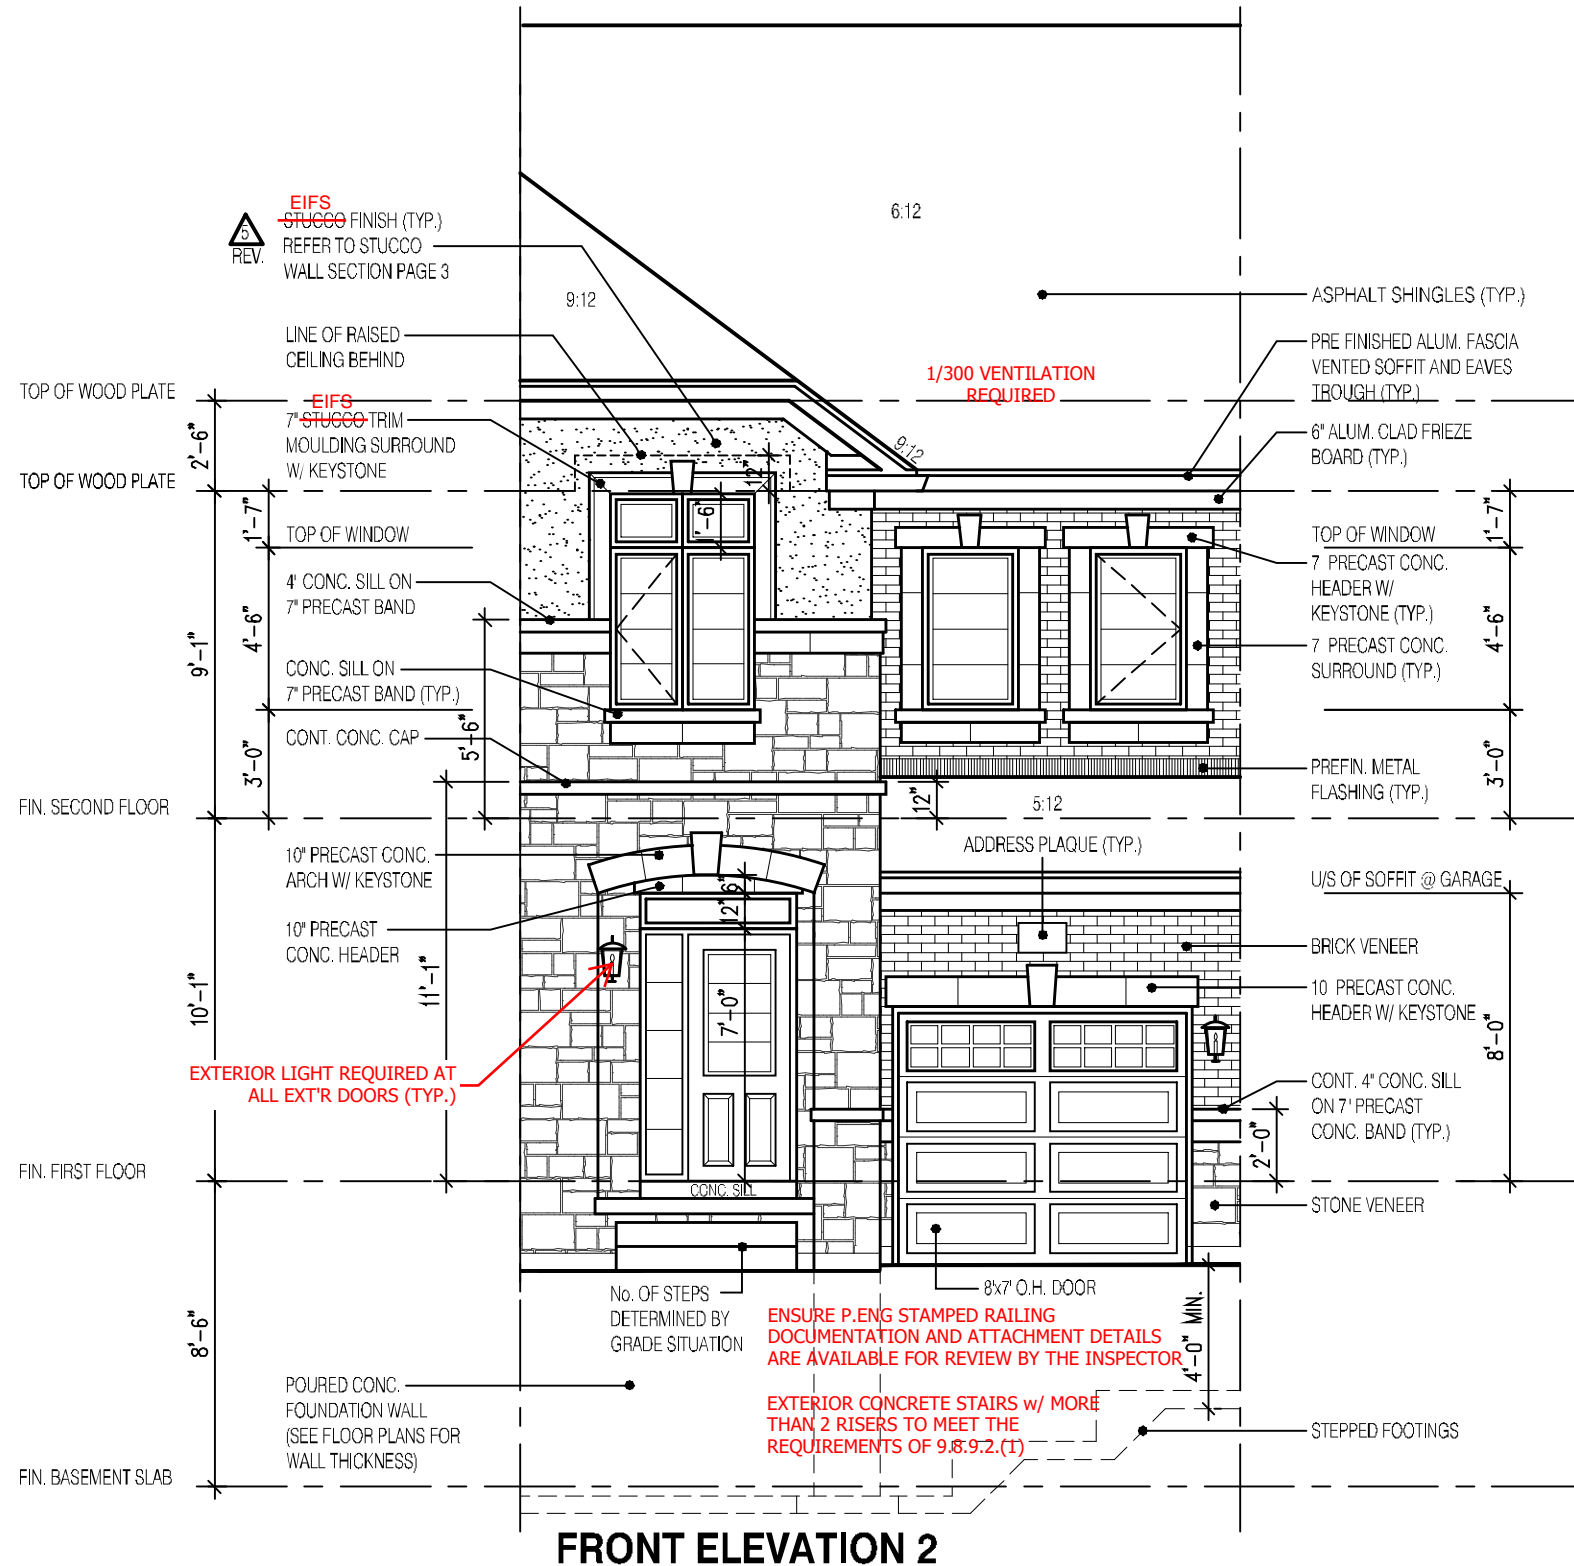

NOT THE GRANTING OF A PERMIT NOR REVIEWING OF SPECS & DRAWINGS NOR INSPECTIONS MADE DURING INSTALLATION BY THE OFFICIAL HAVING JURISDICTION SHALL RELIEVE THE OWNER FROM REQUIREMENTS OF THE ONTARIO BUILDING CODE AND ANY OTHER REFERENCED REQUIREMENTS.

1696

6.10m LOTS

WILLOW 1 (GR)  
ELEVATION 2

A1 PACKAGE

O.REG. 332/12

THE CONTRACTOR SHALL CHECK AND VERIFY ALL DIMENSIONS AND CONDITIONS ON SITE BEFORE PROCEEDING WITH CONSTRUCTION. ANY DISCREPANCIES SHALL BE REPORTED TO JARDIN DESIGN GROUP INC. PRIOR TO COMMENCEMENT OF WORK.

JARDIN DESIGN GROUP INC. IS NOT RESPONSIBLE FOR THE ACCURACY OF SURVEY, STRUCTURAL OR ENGINEERING INFORMATION SHOWN ON THESE DRAWINGS OR FOR CONSTRUCTION STARTED PRIOR TO THE ISSUANCE OF A BUILDING PERMIT. REFER TO THE APPROPRIATE ENGINEERING DRAWINGS BEFORE PROCEEDING WITH WORK.

AS CONSTRUCTED INVERTS MUST BE VERIFIED PRIOR TO POURING FOOTINGS.

JARDIN DESIGN GROUP INC. HAS NOT BEEN RETAINED TO CARRY OUT OR FINAL REVIEW OF THE WORK AND ASSUMES NO RESPONSIBILITY FOR THE FAILURE OF THE CONTRACTOR OR SUB CONTRACTOR TO CARRY OUT THE WORK IN ACCORDANCE WITH THE CONTRACT DOCUMENTS.

THIS DRAWING IS AN INSTRUMENT OF SERVICE IS PROVIDED BY AND IS THE PROPERTY OF JARDIN DESIGN GROUP INC. THIS DRAWING IS NOT TO BE REPRODUCED.

7		
6		
5	MAR. 8, 2023	REV. STUCCO NOTE AS PER CITY COMMENT, REISSUED FOR PERMIT
4	AUG. 31, 2022	ISSUED BUILDING PERMIT
3	AUG. 29, 2022	COORDINATED WITH FLOOR, ROOF & ENGINEER'S COMMENTS
2	JUNE 20, 2022	PREPARED TO PRE-COORDINATION STAGE & ISSUED TO CLIENT
1	MAR. 28, 2022	ISSUED TO CLIENT FOR BROCHURE

No: DATE: WORK DESCRIPTION:

**jardin**  
DESIGN GROUP INC  
64 JARDIN DR. SUITE 3A  
VAUGHAN ONT. L4K 3P3  
TEL: 905 660-3377 FAX: 905 660-3713  
EMAIL: info@jardindesign.ca

The undersigned has reviewed and takes responsibility for this design and has the qualifications and meets the requirements set out in the Ontario Building Code to be a designer

QUALIFICATION INFORMATION  
Required unless design is exempt under Division C, Subsection 3.2.5 of the building code

Walter Botter 21031  
NAME SIGNATURE BCIN

REGISTRATION INFORMATION  
Required unless design is exempt under Division C, Subsection 3.2.4 of the building code

Jardin design group inc. 27763  
FIRM NAME BCIN

FRONT ELEVATION 2


BARLASSINA CONSTRUCTION  
CITY OF CAMBRIDGE



MODEL:  
WILLOW 1  
SCALE:  
3/16"=1'-0"  
PROJ. No.  
21-35  
DWG. No.  
4A



WILLOW 1 ELEV.-2 (OPT. 30"x24" WINDOW)		ENERGY EFFICIENCY- SB12	
ELEVATION	WALL FT²	OPENING FT²	PERCENTAGE
FRONT	394.90	83.17	21.06 %
LEFT SIDE	1088.76	0.00	0.00 %
RIGHT SIDE	1088.76	0.00	0.00 %
REAR	379.06	84.44	22.28 %
TOTAL	2951.48	167.61	5.68 %

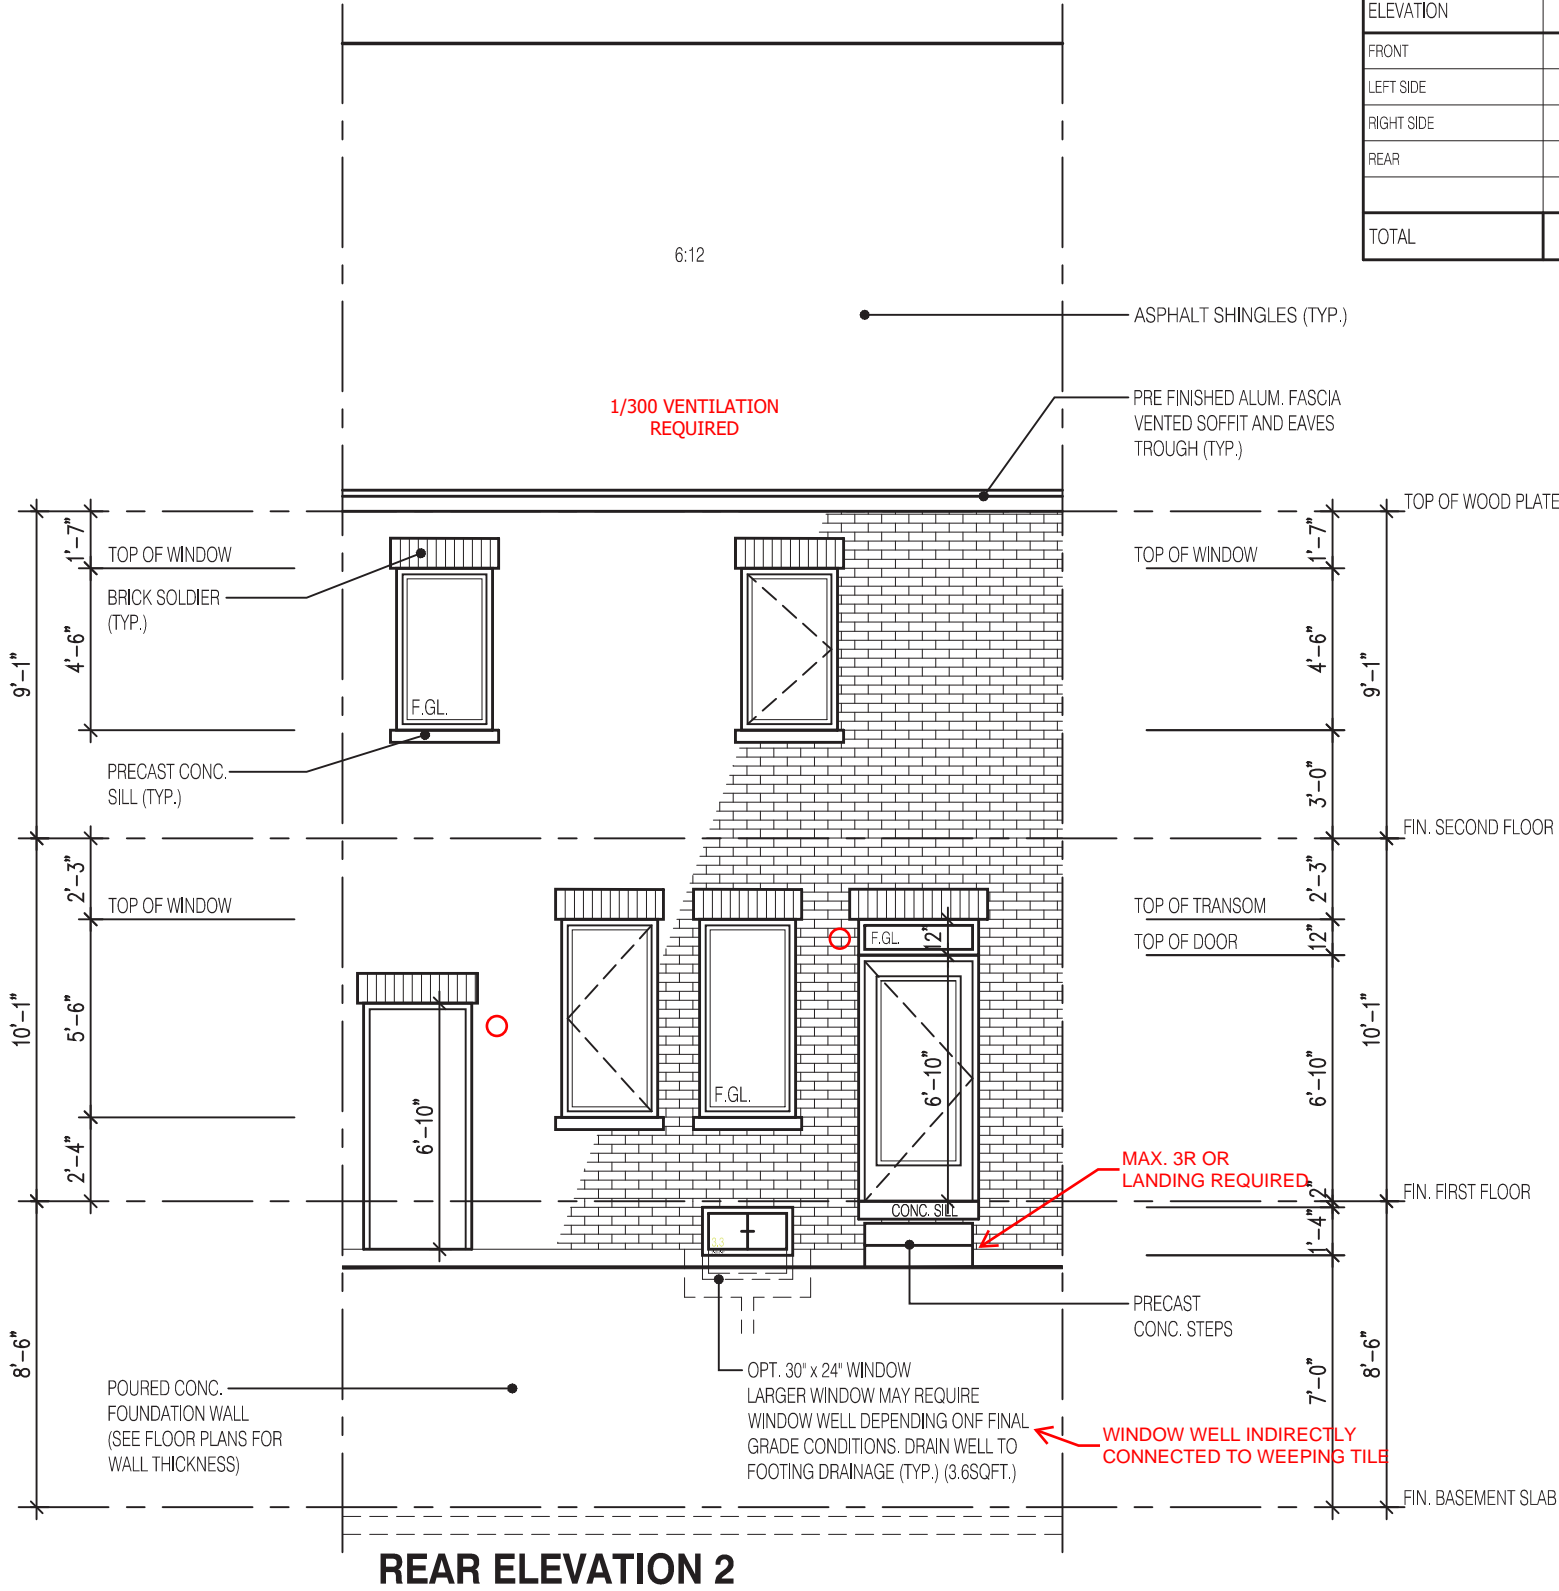

REAR ELEVATION 2

NOT THE GRANTING OF A PERMIT NOR REVIEWING OF SPECS & DRAWINGS NOR INSPECTIONS MADE DURING INSTALLATION BY THE OFFICIAL HAVING JURISDICTION SHALL RELIEVE THE OWNER FROM REQUIREMENTS OF THE ONTARIO BUILDING CODE AND ANY OTHER REFERENCED REQUIREMENTS.

It is the builder's complete responsibility to ensure that all plans submitted for approval fully comply with the Architectural Guidelines and all applicable regulations and requirements including zoning provisions and any provisions in the subdivision agreement. The Control Architect is not responsible in any way for examining or approving site (lotting) plans or working drawings with respect to any zoning or building code or permit matter or that any house can be properly built or located on its lot.

Walter Botter 21031  
NAME SIGNATURE BCIN

REGISTRATION INFORMATION  
Required unless design is exempt under Division C, Subsection 3.2.4 of the building code

jardin design group inc. 27763  
FIRM NAME BCIN

This is to certify that these plans comply with the applicable Architectural Design Guidelines approved by the City of CAMBRIDGE

JOHN G. WILLIAMS LTD., ARCHITECT  
ARCHITECTURAL CONTROL REVIEW  
AND APPROVAL

APPROVED BY: [Signature]  
DATE: OCT 11, 2022

This stamp certifies compliance with the applicable Design Guidelines only and bears no further professional responsibility.

1696

6.10m LOTS

WILLOW 1 (GR)  
ELEVATION 2

A1 PACKAGE

O.REG. 332/12

THE CONTRACTOR SHALL CHECK AND VERIFY ALL DIMENSIONS AND CONDITIONS ON SITE BEFORE PROCEEDING WITH CONSTRUCTION. ANY DISCREPANCIES SHALL BE REPORTED TO JARDIN DESIGN GROUP INC. PRIOR TO COMMENCEMENT OF WORK.

JARDIN DESIGN GROUP INC. IS NOT RESPONSIBLE FOR THE ACCURACY OF SURVEY, STRUCTURAL OR ENGINEERING INFORMATION SHOWN ON THESE DRAWINGS OR FOR CONSTRUCTION STARTED PRIOR TO THE ISSUANCE OF A BUILDING PERMIT. REFER TO THE APPROPRIATE ENGINEERING DRAWINGS BEFORE PROCEEDING WITH WORK.

AS CONSTRUCTED INVERTS MUST BE VERIFIED PRIOR TO POURING FOOTINGS.

JARDIN DESIGN GROUP INC. HAS NOT BEEN RETAINED TO CARRY OUT GENERAL REVIEW OF THE WORK AND ASSUMES NO RESPONSIBILITY FOR THE FAILURE OF THE CONTRACTOR OR SUB CONTRACTOR TO CARRY OUT THE WORK IN ACCORDANCE WITH THE CONTRACT DOCUMENTS.

THIS DRAWING IS AN INSTRUMENT OF SERVICE. IS PROVIDED BY AND IS THE PROPERTY OF JARDIN DESIGN GROUP INC. THIS DRAWING IS NOT TO BE SCALED.

7		
6		
5		
4	AUG. 31, 2022	ISSUED BUILDING PERMIT
3	AUG. 29, 2022	COORDINATED WITH FLOOR, ROOF & ENGINEER'S COMMENTS
2	JUNE 20, 2022	PREPARED TO PRE-COORDINATION STAGE & ISSUED TO CLIENT
1	MAR. 28, 2022	ISSUED TO CLIENT FOR BROCHURE

No: DATE: WORK DESCRIPTION:

jardin

DESIGN GROUP INC

64 JARDIN DR. SUITE 3A  
VAUGHAN ONT. L4K 3P3  
TEL: 905 660-3377 FAX: 905 660-3713  
EMAIL: info@jardindesign.ca

The undersigned has reviewed and takes responsibility for this design and has the qualifications and meets the requirements set out in the Ontario Building Code to be a designer

QUALIFICATION INFORMATION  
Required unless design is exempt under Division C, Subsection 3.2.5 of the building code

Walter Botter 21031

NAME SIGNATURE BCIN

REGISTRATION INFORMATION  
Required unless design is exempt under Division C, Subsection 3.2.4 of the building code

jardin design group inc. 27763

FIRM NAME BCIN

REAR ELEVATION 2

BARLASSINA CONSTRUCTION  
CITY OF CAMBRIDGE

BILD


MODEL:  
WILLOW 1

SCALE:  
3/16" = 1'-0"

PROJ. No.  
21-35

DWG. No.  
5A



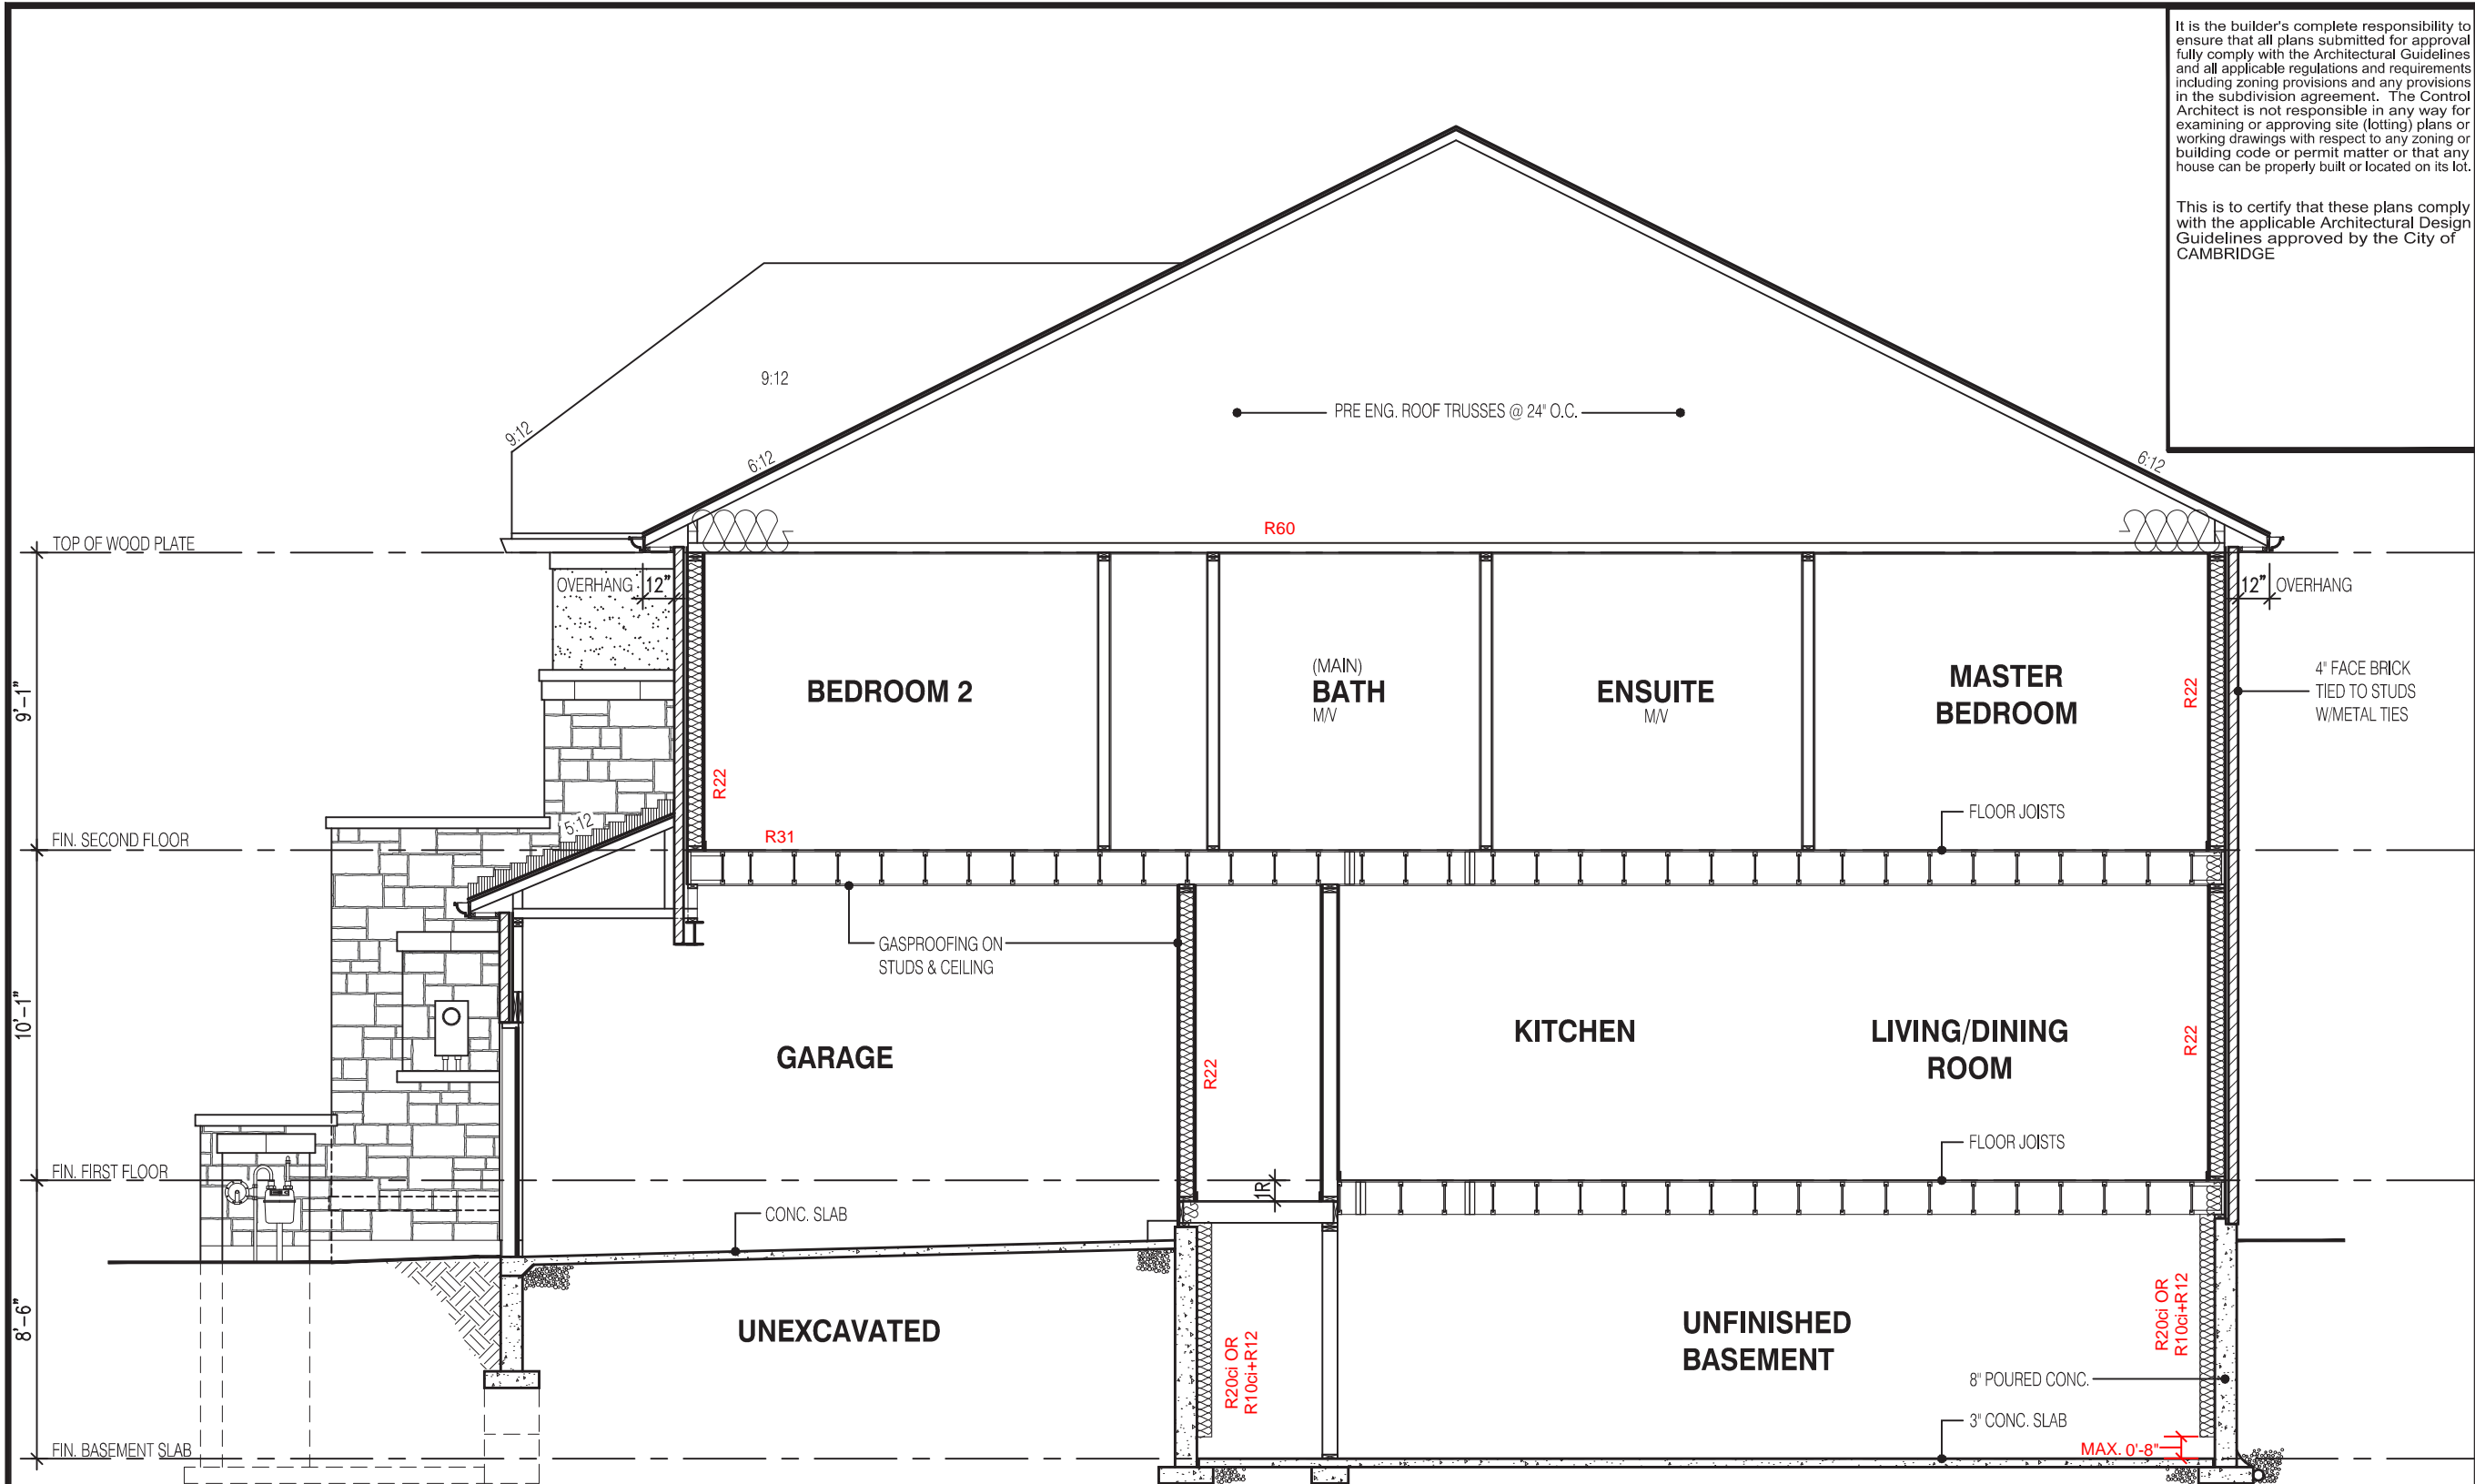

SECTION A-A ELEVATION 2

NOT THE GRANTING OF A PERMIT NOR REVIEWING OF SPECS & DRAWINGS NOR INSPECTIONS MADE DURING INSTALLATION BY THE OFFICIAL HAVING JURISDICTION SHALL RELIEVE THE OWNER FROM REQUIREMENTS OF THE ONTARIO BUILDING CODE AND ANY OTHER REFERENCED REQUIREMENTS.

It is the builder's complete responsibility to ensure that all plans submitted for approval fully comply with the Architectural Guidelines and all applicable regulations and requirements including zoning provisions and any provisions in the subdivision agreement. The Control Architect is not responsible in any way for examining or approving site (lotting) plans or working drawings with respect to any zoning or building code or permit matter or that any house can be properly built or located on its lot.

This is to certify that these plans comply with the applicable Architectural Design Guidelines approved by the City of CAMBRIDGE

1696
6.10m LOTS
WILLOW 1 (GR) ELEVATION 2
A1 PACKAGE
O.REG. 332/12

THE CONTRACTOR SHALL CHECK AND VERIFY ALL DIMENSIONS AND CONDITIONS ON SITE BEFORE PROCEEDING WITH CONSTRUCTION. ANY DISCREPANCIES SHALL BE REPORTED TO JARDIN DESIGN GROUP INC. PRIOR TO COMMENCEMENT OF WORK.

JARDIN DESIGN GROUP INC. IS NOT RESPONSIBLE FOR THE ACCURACY OF SURVEY, STRUCTURAL OR ENGINEERING INFORMATION SHOWN ON THESE DRAWINGS OR FOR CONSTRUCTION STARTED PRIOR TO THE ISSUANCE OF A BUILDING PERMIT. REFER TO THE APPROPRIATE ENGINEERING DRAWINGS BEFORE PROCEEDING WITH WORK.

AS CONSTRUCTED INVERTS MUST BE VERIFIED PRIOR TO POURING FOOTINGS.

JARDIN DESIGN GROUP INC. HAS NOT BEEN RETAINED TO CARRY OUT GENERAL REVIEW OF THE WORK AND ASSUMES NO RESPONSIBILITY FOR THE FAILURE OF THE CONTRACTOR OR SUB CONTRACTOR TO CARRY OUT THE WORK IN ACCORDANCE WITH THE CONTRACT DOCUMENTS.

THIS DRAWING IS AN INSTRUMENT OF SERVICE. IS PROVIDED BY AND IS THE PROPERTY OF JARDIN DESIGN GROUP INC. THIS DRAWING IS NOT TO BE SCALED.

7		
6		
5		
4	AUG. 31, 2022	ISSUED BUILDING PERMIT
3	AUG. 29, 2022	COORDINATED WITH FLOOR, ROOF & ENGINEER'S COMMENTS
2	JUNE 20, 2022	PREPARED TO PRE-COORDINATION STAGE & ISSUED TO CLIENT
1	MAR. 28, 2022	ISSUED TO CLIENT FOR BROCHURE

No:      DATE:      WORK DESCRIPTION:

jardin

DESIGN GROUP INC

64 JARDIN DR. SUITE 3A  
VAUGHAN ONT. L4K 3P3  
TEL: 905 660-3377 FAX: 905 660-3713  
EMAIL: info@jardindesign.ca

The undersigned has reviewed and takes responsibility for this design and has the qualifications and meets the requirements set out in the Ontario Building Code to be a designer

QUALIFICATION INFORMATION  
Required unless design is exempt under Division C, Subsection 3.2.5 of the building code

Walter Botter 21031  
NAME SIGNATURE BCIN

REGISTRATION INFORMATION  
Required unless design is exempt under Division C, Subsection 3.2.4 of the building code

jardin design group inc. 27763  
FIRM NAME BCIN

SECTION A-A ELEV-2  
BARLASSINA CONSTRUCTION  
CITY OF CAMBRIDGE


	MODEL:	LAKEWOOD 2
	SCALE:	3/16"=1'-0"
	PROJ. No.	DWG. No.
	21-35	6A

STRUDET INC.

FOR STRUCTURE ONLY



FOR GAS METER INSTALLATION REFER TO "NATURAL GAS METER, REGULATOR AND EQUIPEMENT EXTERIOR CLEARANCES - R2"

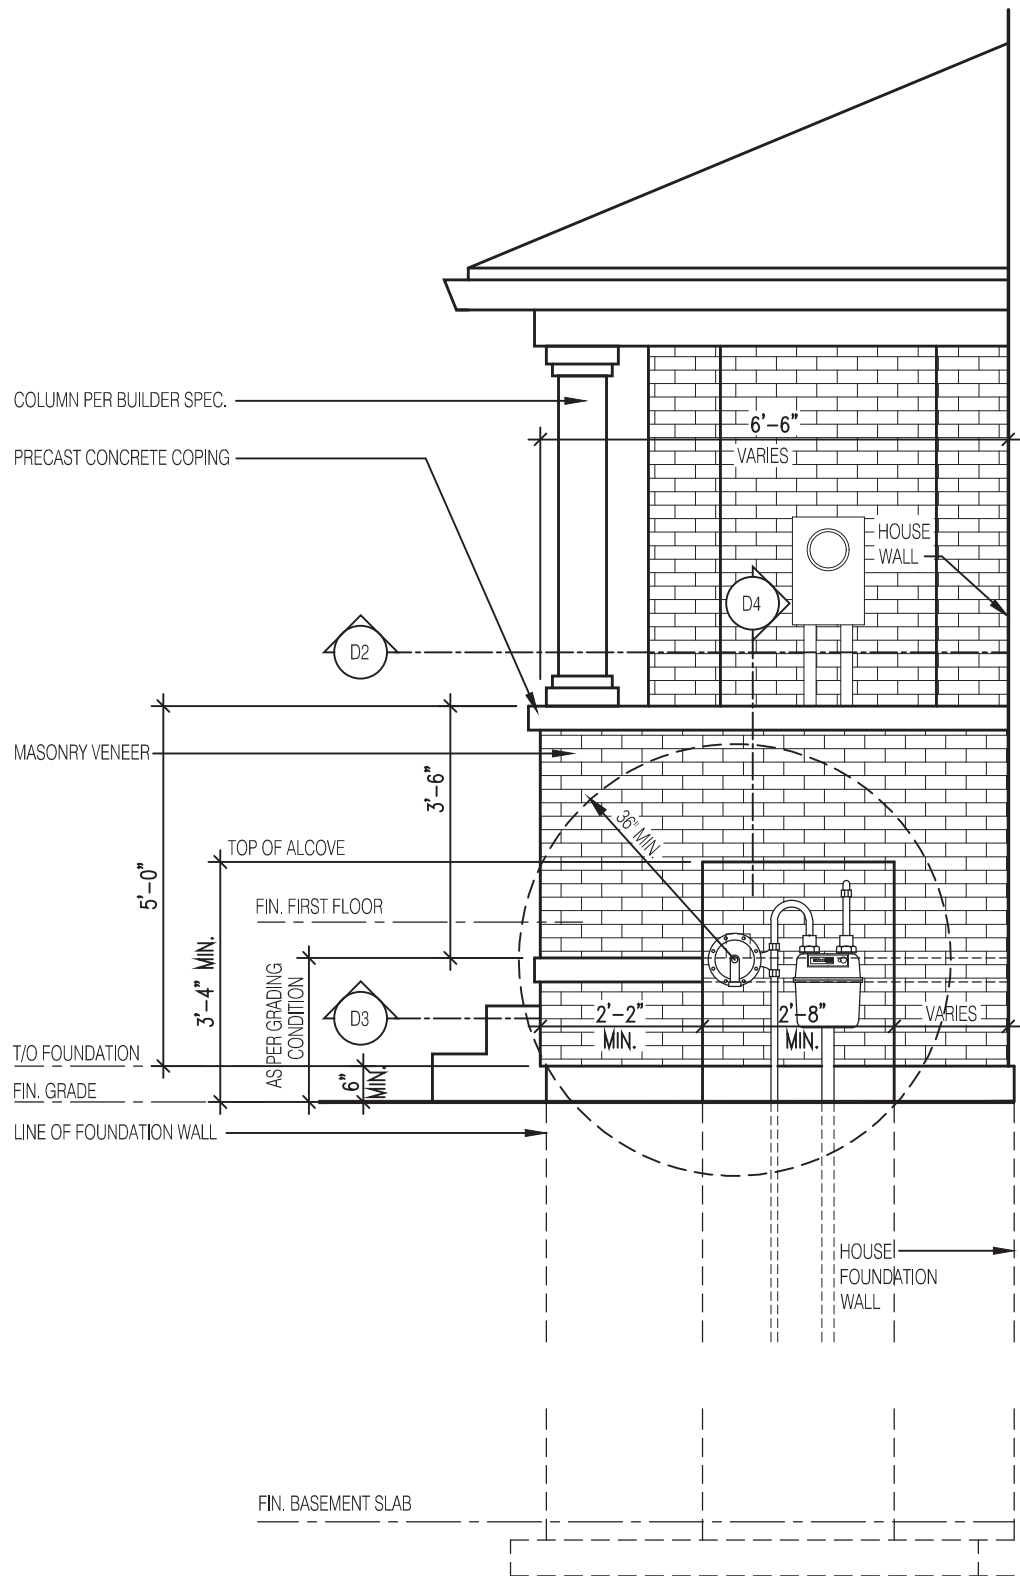

ELEVATION OF RECESSED WALL FOR GAS METER AT PORCH

Scale: 3/8" = 1'-0"

D-1

PLAN OF RECESSED WALL FOR GAS METER AT PORCH


Scale: 1/4" = 1'-0"

D-2

SECTION OF RECESSED WALL FOR GAS METER BY AT PORCH

Scale: 1/4" = 1'-0"

D-3

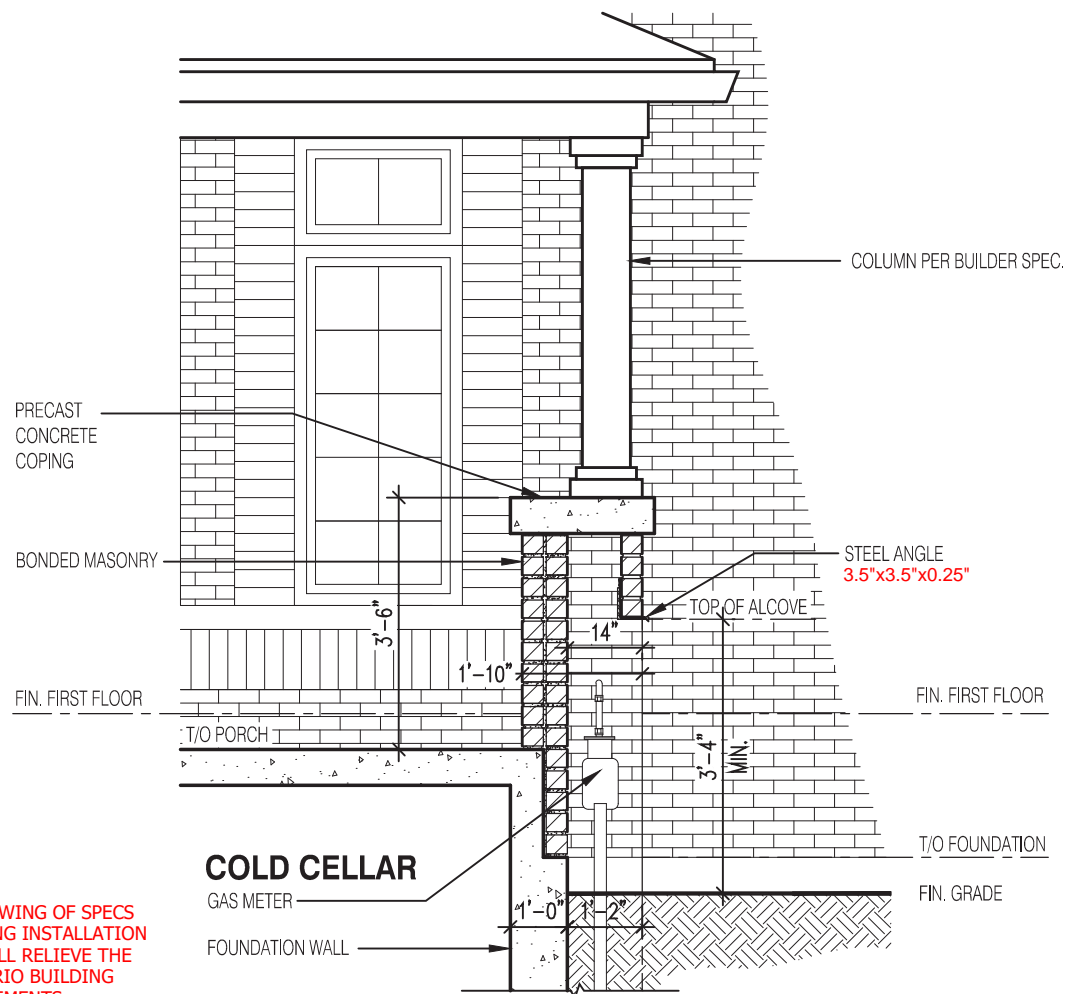

SECTION OF RECESSED WALL FOR GAS METER AT PORCH

Scale: 3/8" = 1'-0"

D-4

1696

6.10m LOTS

WILLOW 1 (GR)  
ELEV- 1,2 & 3

A1 PACKAGE

O.REG. 332/12

THE CONTRACTOR SHALL CHECK AND VERIFY ALL DIMENSIONS AND CONDITIONS ON SITE BEFORE PROCEEDING WITH CONSTRUCTION. ANY DISCREPANCIES SHALL BE REPORTED TO JARDIN DESIGN GROUP INC. PRIOR TO COMMENCEMENT OF WORK.

JARDIN DESIGN GROUP INC. IS NOT RESPONSIBLE FOR THE ACCURACY OF SURVEY, STRUCTURAL OR ENGINEERING INFORMATION SHOWN ON THESE DRAWINGS OR FOR CONSTRUCTION STARTED PRIOR TO THE ISSUANCE OF A BUILDING PERMIT. REFER TO THE APPROPRIATE ENGINEERING DRAWINGS BEFORE PROCEEDING WITH WORK.

AS CONSTRUCTED INVERTS MUST BE VERIFIED PRIOR TO POURING FOOTINGS.

JARDIN DESIGN GROUP INC. HAS NOT BEEN RETAINED TO CARRY OUT GENERAL REVIEW OF THE WORK AND ASSUMES NO RESPONSIBILITY FOR THE FAILURE OF THE CONTRACTOR OR SUB CONTRACTOR TO CARRY OUT THE WORK IN ACCORDANCE WITH THE CONTRACT DOCUMENTS.

THIS DRAWING IS AN INSTRUMENT OF SERVICE. IS PROVIDED BY AND IS THE PROPERTY OF JARDIN DESIGN GROUP INC. THIS DRAWING IS NOT TO BE SCALED.

7		
6		
5		
4		
3		
2	AUG. 31, 2022	ISSUED BUILDING PERMIT
1	FEB. 15, 2022	PREPARED AND ISSUED TO CLIENT FOR REVIEW
No:	DATE:	WORK DESCRIPTION:

**jardin**  
DESIGN GROUP INC  
64 JARDIN DR. SUITE 3A  
VAUGHAN ONT, L4K 3P3  
TEL: 905 660-3377 FAX: 905 660-3713  
EMAIL: info@jardindesign.ca

The undersigned has reviewed and takes responsibility for this design and has the qualifications and meets the requirements set out in the Ontario Building Code to be a designer

QUALIFICATION INFORMATION  
Required unless design is exempt under Division C, Subsection 3.2.5 of the building code

Walter Botter *Walter Botter* 21031  
NAME SIGNATURE BCIN

REGISTRATION INFORMATION  
Required unless design is exempt under Division C, Subsection 3.2.4 of the building code

jardin design group inc. 27763  
FIRM NAME BCIN

GAS METER DETAIL

BARLASSINA CONSTRUCTION  
CITY OF CAMBRIDGE



MODEL:  
SCALE: AS NOTED  
PROJ. No. 21-35  
DWG. No. 7



