

CONSTRUCTION SUMMARY

Red Oaks - Roundel Homes Inc.

PURCHASER: YUFEI WANG

TEL: RES.: 437-363-8760

LOT / PHASE 26 / 1	REG. PLAN # 65M-4737	HOUSE TYPE Pinetree 2 Elev 1		
-----------------------	-------------------------	---------------------------------	--	--

ELECTRICAL

1 - ABOVE KITCHEN ISLAND - ADD LIGHT AND SWITCH - NO FIXTURE INCLUDED 20Mar23 Note:	
--	--

PLUMBING

1 - WATER LINE FOR FRIDGE - ROUGH-IN ONLY 20Mar23 Note:	
--	--




PROMOTIONAL

1 - PARTIAL REDEMPTION OF PROMOTIONAL PACKAGE \$665.00 BALANCE FORWARD TO BE USED AT A LATER DATE \$9,335.00.ORIGINAL PROMOTIONAL PACKAGE OF \$10,000.00 AS PER SCHEDULE PE DATED 03/08/2023 20Mar23 Note:	
--	--

This Document is Extremely Time Sensitive - Printed 22 Mar 23 at 9:00

Pinetree 2

Includes 16 sq.ft. of open area.

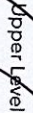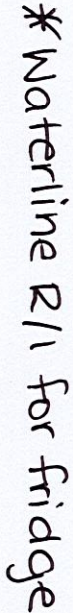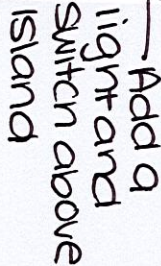

Orientation of home may be reversed and purchaser agrees to accept the same. Steps and porches may vary at any exterior entrance ways due to grading variance. Actual usable floor space may vary from the stated floor areas. All renderings are artist's concept. Dimensions, specifications and architectural detailing subject to modifications. Roofline and adjoining model types may vary due to siting. E. & O. E. June 2022