

CONSTRUCTION SUMMARY	
Hazel Glenn - Barlassina Construction Inc.	
PURCHASERS: Indrea Duvashanie BHOJ and Ryan Robert ROOPCHAND	TEL: RES.: 647-996-4814

LOT / PHASE Block 120 TH22 / 1	REG. PLAN #	HOUSE TYPE Cherry 1 Elev 1		
-----------------------------------	-------------	-------------------------------	--	--

ELECTRICAL

1 - STANDARD DINING ROOM LIGHT TO BE CENTERED BETWEEN LIVING AND DINING ROOM 24Mar23 Note:	
1 - PLUG - ELECTRICAL PLUG WITH GFI AND SWITCH - FOR FESTIVE LIGHTING 24Mar23 Note:	
1 - RELOCATE STANDARD KITCHEN LIGHT TO BE CENTERED OVER ISLAND 24Mar23 Note:	
1 - PLUG - ELECTRICAL PLUG - 5 FEET FROM FINISHED FLOOR FOR FUTURE WALL MOUNTED TV - SEE SKETCH 24Mar23 Note:	

MISCELLANEOUS

1 - GARAGE DOOR OPENER – LIFEMASTER 8155 WITH BELT DRIVE – INLCUDES 1 KEYPAD AND 2 HANDHELD CONTROL - PRICE IS PER GARAGE DOOR 24Mar23 Note:	
---	--

PLUMBING

1 - WASHROOM - 3 PIECE ROUGH-IN IN BASEMENT 24Mar23 Note:	
--	--


PROMOTIONAL

1 - PARTIAL REDEMPTION OF PROMOTIONAL PACKAGE \$2,845 BALANCE FORWARD \$7,155 TO BE USED AT A LATER DATE. ORIGINAL PROMOTIONAL PACKAGE OF \$10,000 AS PER SCHEDULE PE 24Mar23 Note:	
--	--

This Document is Extremely Time Sensitive - Printed 24 Mar 23 at 15:19

Cherry 1

ELEVATION 1 - 1,951 sq.ft. • ELEVATION 2 - 1,960 sq.ft.
Includes 14 sq.ft. of open area

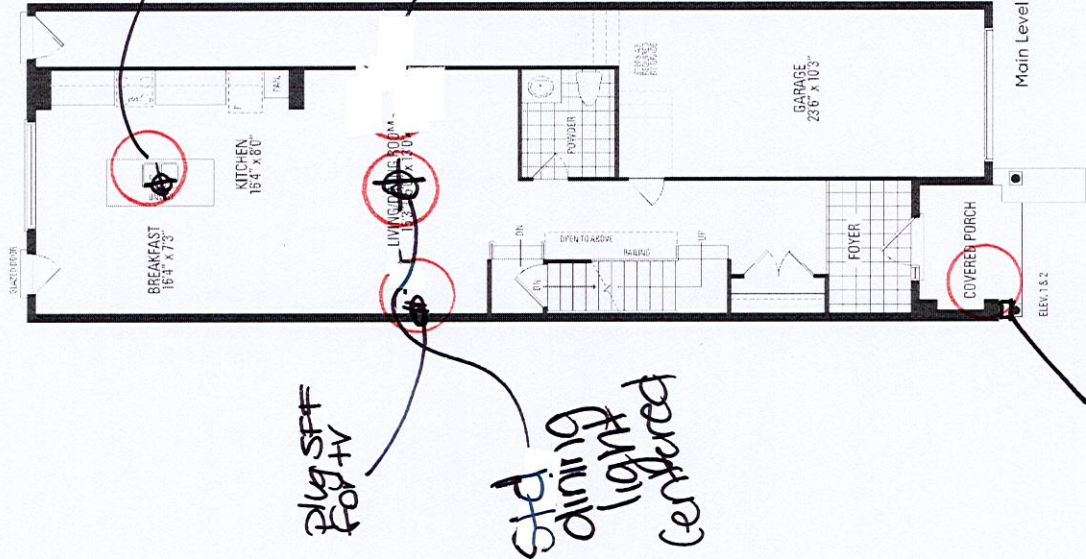


Relocate
Std Kit Centered
light over
island

plug for TV

std
dining
light
centered

festive
plug

★ Add
R.I.

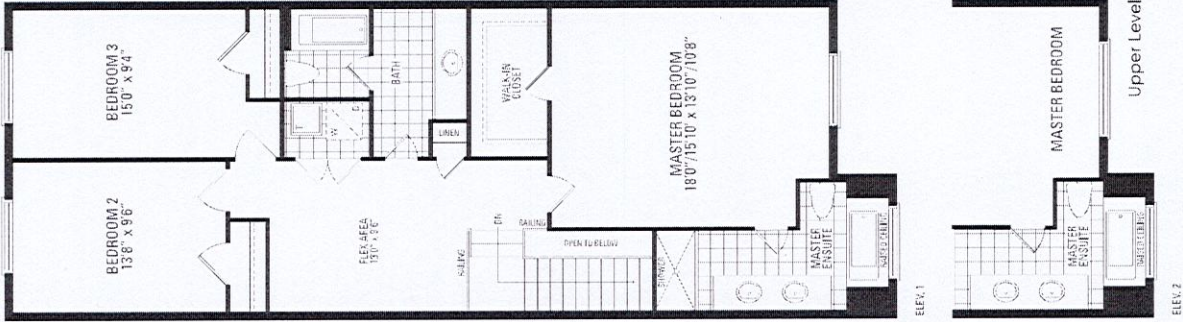

★ Signature:

Orientation of home may be reversed and purchaser agrees to accept the same. Steps and porches may vary at any exterior entrance ways due to grading variance. Actual usable floor space may vary from the stated floor areas. All renderings are artist's concept. Dimensions, specifications and architectural detailing subject to modifications. Roofline and adjoining model types may vary due to siting. E. & O.E. October 2022