

CONSTRUCTION SUMMARY	
Hazel Glenn - Barlassina Construction Inc.	
PURCHASERS: Rishi KAPOOR and Suruchi KAPOOR	TEL: RES.: 365-778-1129

LOT / PHASE Block 120 TH21 / 1	REG. PLAN #	HOUSE TYPE Cherry 2 Elev 1		
-----------------------------------	-------------	-------------------------------	--	--

ELECTRICAL

1 - ABOVE KITCHEN ISLAND - ADD LIGHT AND SWITCH - NO FIXTURE INCLUDED 30Mar23 Note:	
--	--

PLUMBING

2 - HOSE BIB - EXTERIOR FROST FREE- ON BOTH FRONT AND REAR BIBS 30Mar23 Note:	
1 - WASHROOM - 3 PIECE ROUGH-IN IN BASEMENT 30Mar23 Note:	

PROMOTIONAL


1 - PARTIAL REDEMPTION OF PROMOTIONAL PACKAGE \$2,330 BALANCE FORWARD \$7,670 TO BE USED AT A LATER DATE. ORIGINAL PROMOTIONAL PACKAGE OF \$10,000 AS PER SCHEDULE PE 30Mar23 Note:	
--	--

This Document is Extremely Time Sensitive - Printed 30 Mar 23 at 10:45

Frost Free
Hose BIBs Added
to Front & Rear
Hoses.

Cherry 2

ELEVATION 1 & 2 - 2,030 sq.ft.

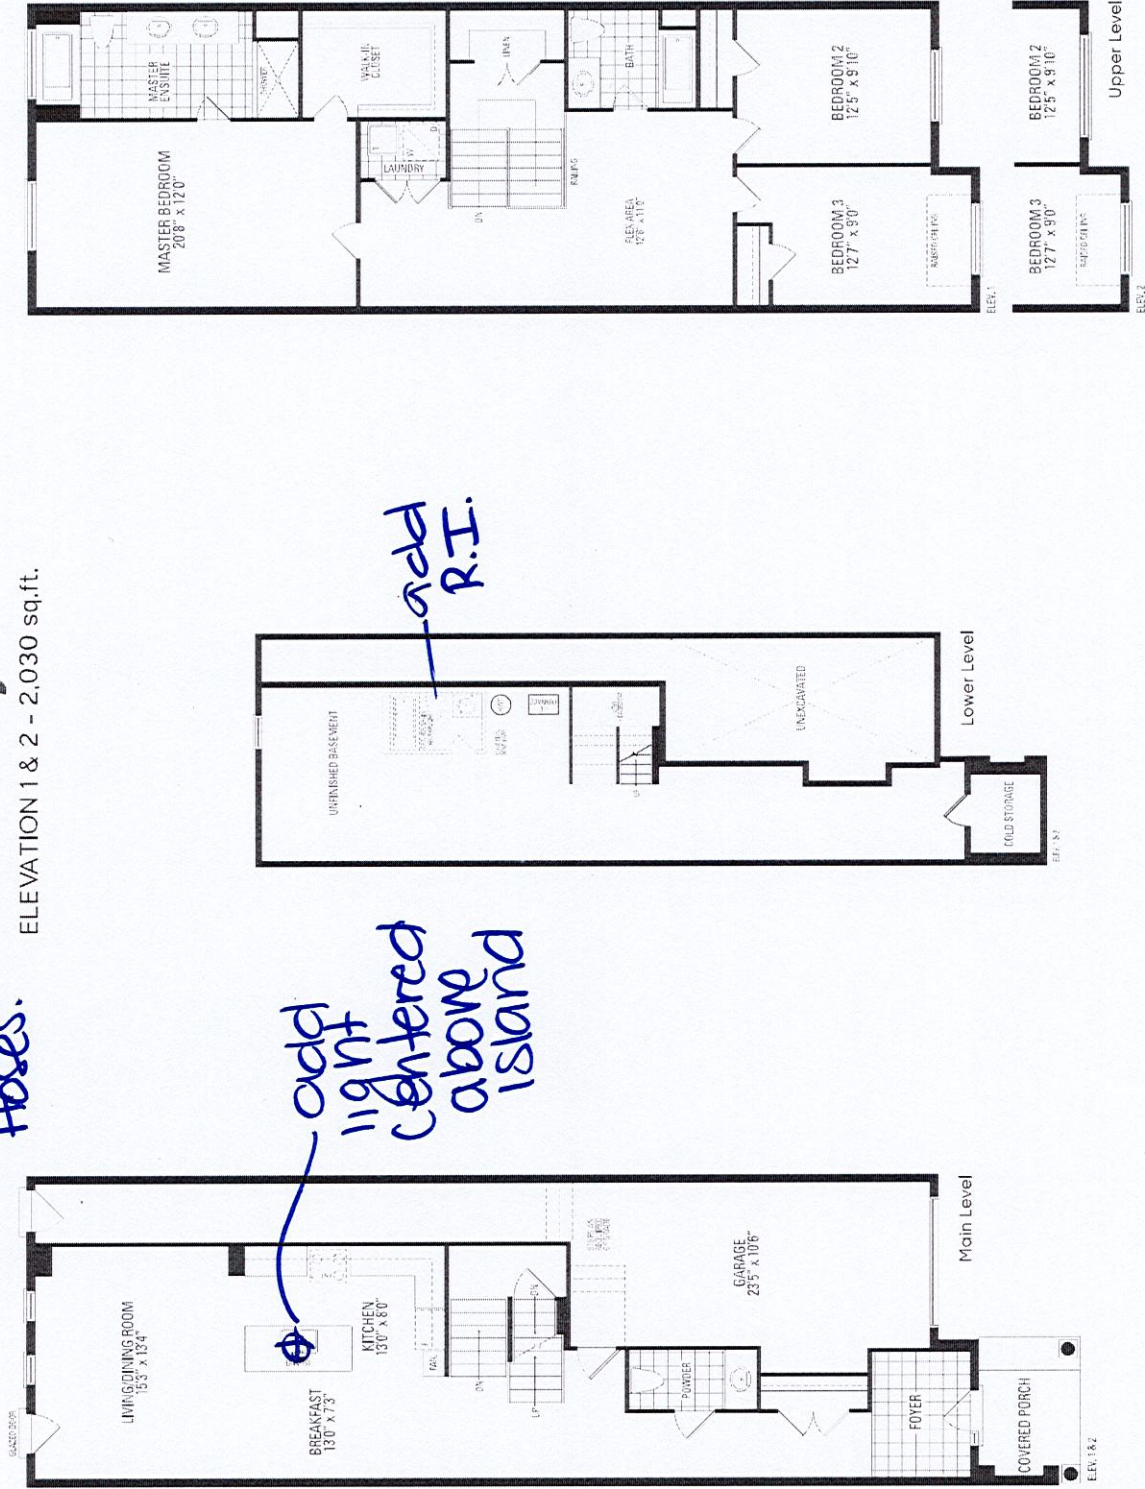

Orientation of home may be reversed and purchaser agrees to accept the same. Steps and porches may vary at any exterior entrance ways due to grading variance. Actual usable floor space may vary from the stated floor areas. All renderings are artist's concept. Dimensions, specifications and architectural detailing subject to modifications. Roofline and adjoining model types may vary due to siting. E. & O.E. October 2022