

CONSTRUCTION SUMMARY

Hazel Glenn - Barlassina Construction Inc.

RECEIVED

PURCHASERS: JASVINDER SINGH and Arvinder K. SAINI

APR 10 2023

TEL: RES.: 205-520-4325

LOT / PHASE Block 122 TH58 / 1	REG. PLAN #	HOUSE TYPE Willow 2 Elev 3		
-----------------------------------	-------------	-------------------------------	--	--

CABINETRY

1 - CABINETRY PROVISION – PROVISION FOR PLUG ON KITCHEN ISLAND (PLUG EXTRA ORDERED SEPARATELY) 03Apr23 Note:	
---	--

ELECTRICAL

1 - PLUG - ELECTRICAL PLUG - ADD TO ISLAND 03Apr23 Note:	
1 - LIGHT AND SWITCH - NO FIXTURE INCLUDED - LIVING ROOM 03Apr23 Note:	
1 - ABOVE KITCHEN ISLAND - ADD LIGHT AND SWITCH - NO FIXTURE INCLUDED 03Apr23 Note:	

FIREPLACE AND ACCESSORIES

1 - GAS LINE ROUGH-IN FOR STOVE (INCLUDES ELECTRICAL OUTLET) - FIRST FLOOR 03Apr23 Note:	
---	--

MISCELLANEOUS

1 - GARAGE DOOR OPENER – LIFEMASTER 8155 WITH BELT DRIVE – INLCUDES 1 KEYPAD & 2 HANDHELD CONTROLS - PRICE IS PER GARAGE DOOR 03Apr23 Note:	
--	--

PLUMBING

1 - WATER LINE FOR FRIDGE - ROUGH-IN ONLY 03Apr23 Note:	
1 - WASHROOM - 3 PIECE ROUGH-IN IN BASEMENT 03Apr23 Note:	

PROMOTIONAL

1 - PARTIAL REDEMPTION OF PROMOTIONAL PACKAGE \$4,665.00. BALANCE FORWARD TO BE USED AT A LATER DATE \$5,335.00. ORIGINAL PROMOTIONAL PACKAGE OF \$10,000.00. AS PER SCHEDULE PE DATED 11/21/22. 03Apr23 Note:	
---	--




This Document is Extremely Time Sensitive - Printed 3 Apr 23 at 11:18



Block 122 TH58

Willow 2

ELEVATION 1, 2 & 3 - 1,795 sq.ft.

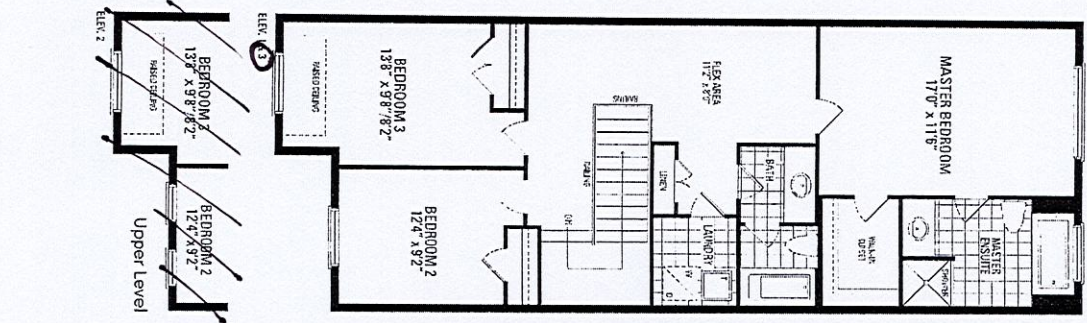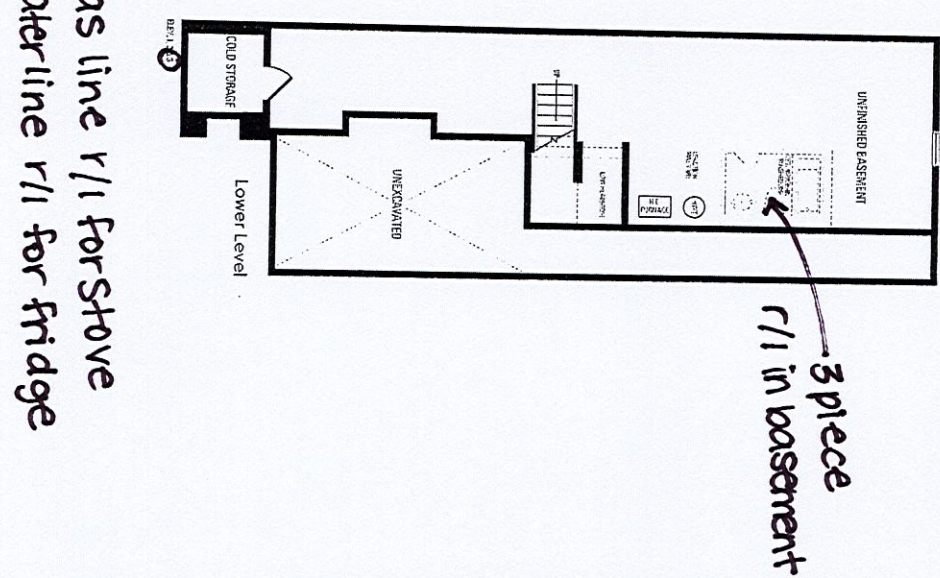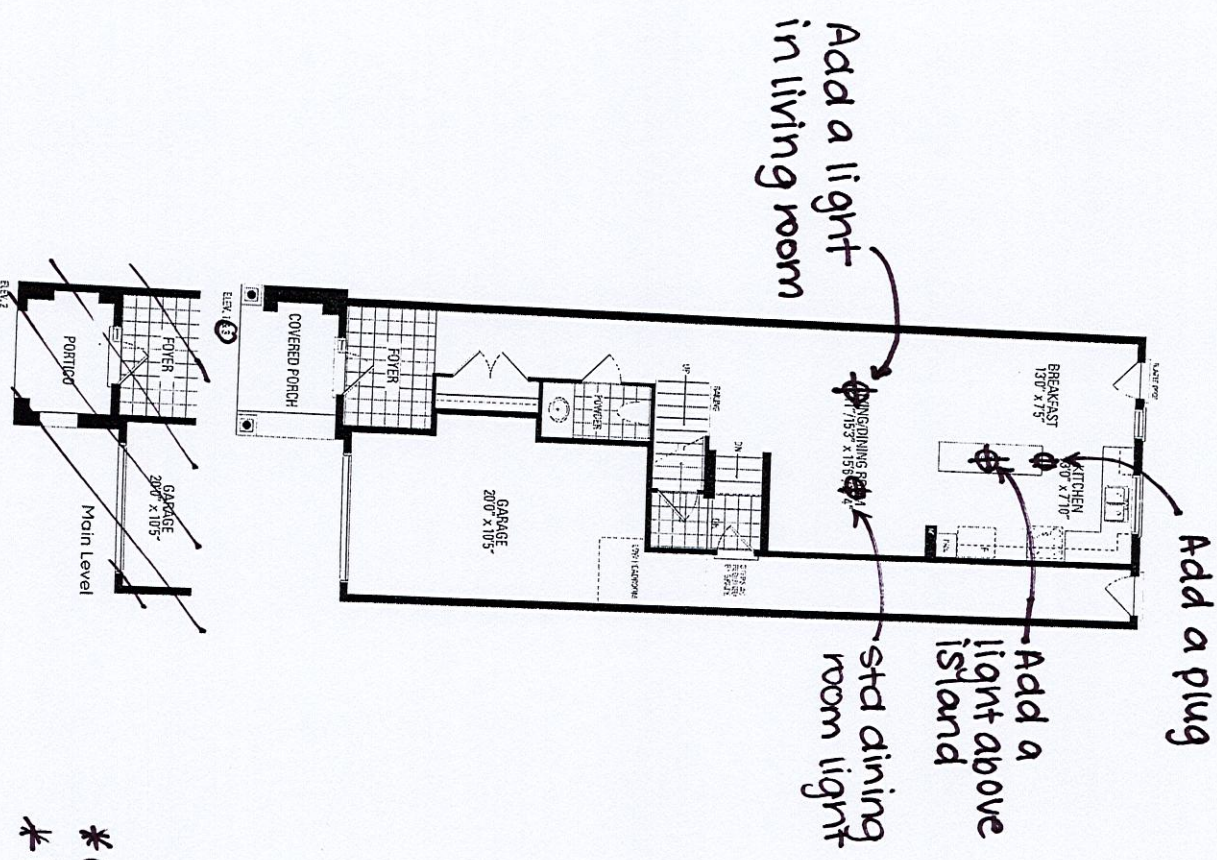

HAZEL GLENN  
ARCHT.

Orientation of home may be reversed and purchaser agrees to accept the same. Steps and porches may vary at any exterior entrance ways due to grading variance. Actual usable floor space may vary from the stated floor areas. All renderings are artist's concept. Dimensions, specifications and architectural detailing subject to modifications. Roofline and adjoining model types may vary due to siting. E. & O.E. October 2022