

"PRELIMINARY"

CONSTRUCTION SUMMARY	
Hazel Glenn - Barlassina Construction Inc.	
PURCHASER: Razwana ALEEM	RECEIVED APR 10 2023 TEL: RES.: 416-417-7178

LOT / PHASE	REG. PLAN #	HOUSE TYPE		
Block 122 TH56 / 1		Willow 1 Elev 3		

PLUMBING

1 - TUB TO SHOWER CONVERSION - 5 FOOT SHOWER WITH SLIDING GLASS CHROME DOORS IN LIEU OF TUB INCLUDES SHOWER POT LIGHT 10Apr23 Note:	
MAIN BATHROOM	

PROMOTIONAL




1 - PARTIAL REDEMPTION OF PROMOTIONAL PACKAGE \$3,500.00. BALANCE FORWARD \$6,500.00 TO BE USED AT A LATER DATE. ORIGINAL PROMOTIONAL PACKAGE OF \$10,000.00 AS PER SCHEDULE PE. 10Apr23 Note:	
---	--

This Document is Extremely Time Sensitive - Printed 10 Apr 23 at 13:49



# Willow 1

ELEVATION 1, 2 & 3 - 1,696 sq.ft.

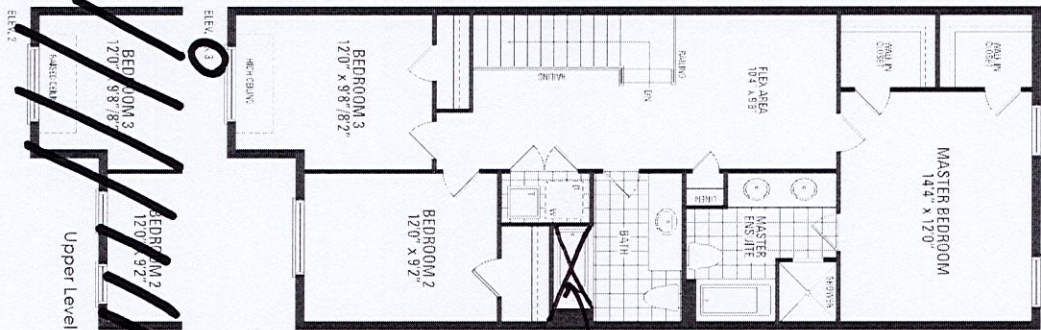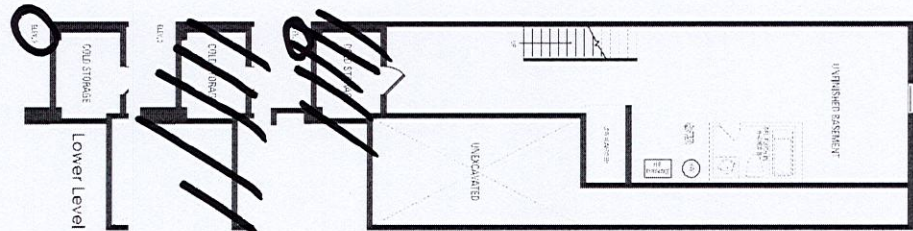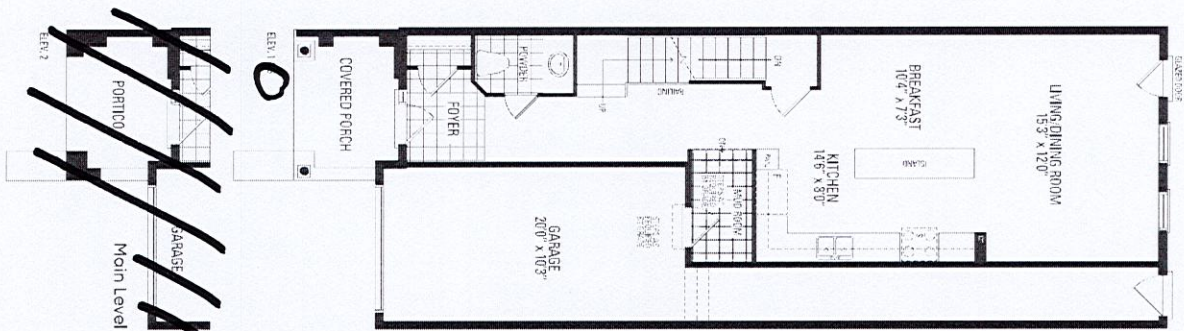

convert tub to shower

Orientation of home may be reversed and purchaser agrees to accept the same. Steps and porches may vary at any exterior entrance ways due to grading variance. Actual usable floor space may vary from the stated floor areas. All renderings are artist's concept. Dimension, specifications and architectural detailing subject to modifications. Roofline and adjoining model types may vary due to siting. E. & O.E. October 2022