

Preliminary

CONSTRUCTION SUMMARY				
Hazel Glenn - Barlassina Construction Inc. RECEIVED				
PURCHASERS: Sumanth POTLURI and Saradvalli VALLABHANENI			APR 13 2023 TEL: RES.: 437-986-6333	
LOT / PHASE	REG. PLAN #	HOUSE TYPE		
Block 121 TH11 / 1		Cherry 1 Elev 1		

CONSTRUCTION

1 - SMOOTH CEILINGS FIRST FLOOR ONLY 11Apr23 Note:	
---	--

ELECTRICAL

1 - STANDARD DINING ROOM LIGHT TO BE CENTERED BETWEEN LIVING AND DINING ROOM 11Apr23 Note:	
12 - POT LIGHT - LED - FIRST FLOOR INSTALLATION 11Apr23 Note:	
2 - PLUG - ELECTRICAL PLUG - 5 FEET FROM FINISHED FLOOR FOR FUTURE WALL MOUNTED TV - SEE SKETCH - LIVING/DINING ROOM AND FLEX AREA 11Apr23 Note:	
1 - RELOCATE STANDARD KITCHEN LIGHT TO BE CENTERED OVER ISLAND 11Apr23 Note:	
1 - ELECTRIC VEHICLE ROUGH-IN PROVISION ONLY FOR FUTURE ELECTRIC CAR (CONDUIT FROM BASEMENT INTO JUNCTION BOX IN GARAGE WITH PULL STRING, NO WIRE) 11Apr23 Note:	

PLUMBING

1 - WATER LINE FOR FRIDGE - ROUGH-IN ONLY 11Apr23 Note:	
1 - TUB TO SHOWER CONVERSION - 5 FOOT SHOWER WITH SLIDING GLASS CHROME DOORS IN LIEU OF TUB INCLUDES SHOWER POT LIGHT 11Apr23 Note:	

PROMOTIONAL

1 - LESS BALANCE OF CREDIT FROM PURCHASER EXTRA SHEET IN OFFER 11Apr23 Note:	
---	--

This Document is Extremely Time Sensitive - Printed 11 Apr 23 at 10:33

Cherry 1

ELEVATION 1 - 1,951 sq.ft. • ELEVATION 2 - 1,960 sq.ft.
Includes 14 sq.ft. of open area

5 potson
1 switch

relocate
std kit light
to island




Center
std light

4 potson 1 switch

plug 5ft
from
#100x

3 potson
1 switch

electric
car plug

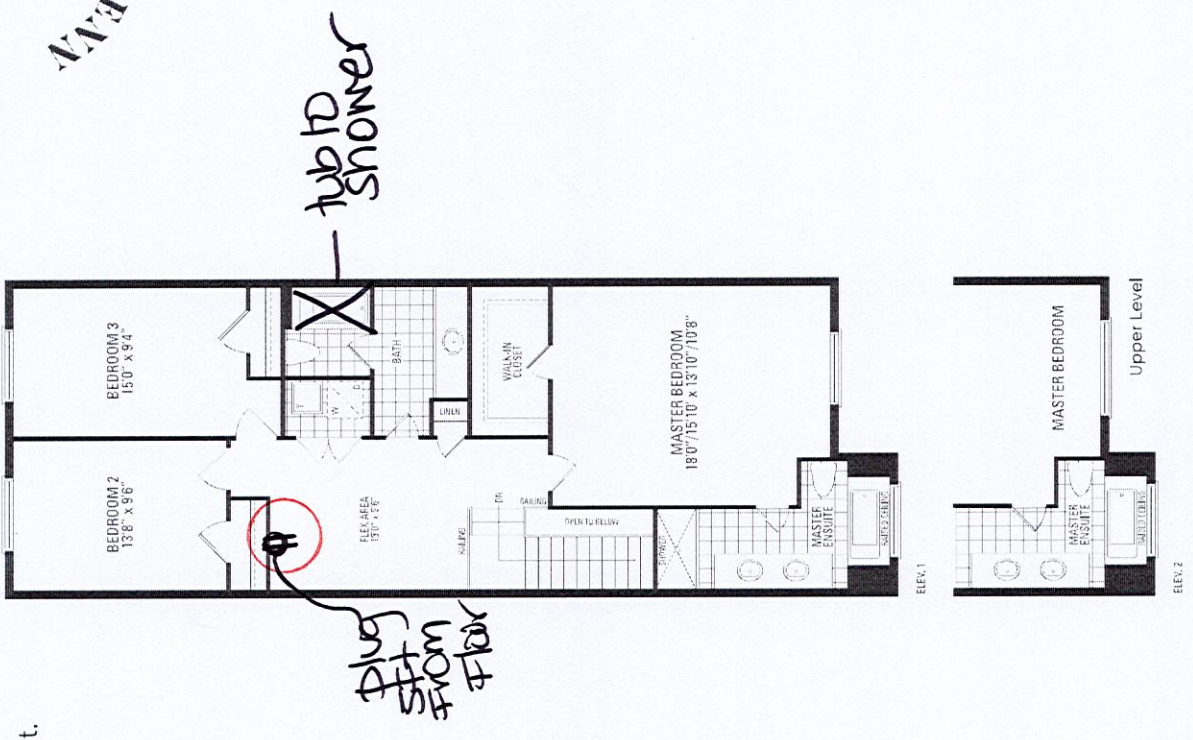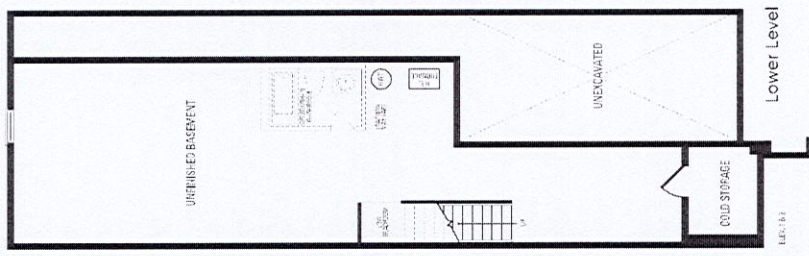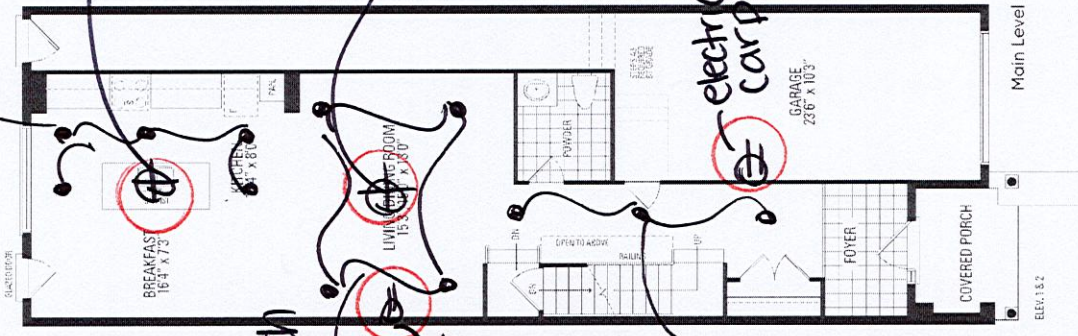

Signature: _____

Orientation of home may be reversed and purchaser agrees to accept the same. Steps and porches may vary at any exterior entrance ways due to grading variance. Actual usable floor space may vary from the stated floor areas. All renderings are artist's concept. Dimensions, specifications and architectural detailing subject to modifications. Roofline and adjoining model types may vary due to siting. E. & O. E. October 2022