

☐ CATCH BASIN STREET LIGHT

TRANSFORMER INFILTRATION TRENCH (BELOW)

GARAGE DOOR LOCATION

A CABLE TV PEDESTAL ■ BELL PEDESTAL △ ENTRANCE DOOR LOCATION

THAT DISCHARGE TO STORM

- HYDRANT

UNITS REQUIRING SUMP PUMPS HYDRO METER H THAT DISCHARGE TO SURFACE

SP UNITS REQUIRING SUMP PUMPS GAS METER **G**

MATE COMMUNITY MAILBOX TTT PROPOSED BERM \otimes


STORM MANHOLE

100.00 PROPOSED SWALE GRADE — SWALE DIRECTION DOWNSPOUT LOCATION F.FLR. FINISHED FLOOR ELEVATION VALVE AND CHAMBER T/WALL TOP OF FOUNDATION WALL SANITARY MANHOLE F.SLAB FIN. BASEMENT FLOOR SLAB

100.00 PROPOSED GRADE

100.00 EXISTING GRADE

PART OF LOT 1 **CONCESSION 9** CITY OF CAMBRIDGE REGIONAL MUNICIPALITY OF WATERLOO **REGISTERED PLAN** U/FTG. UNDERSIDE FOOTING ELEVATION

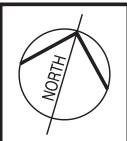

LEGEND

NOT THE GRANTING OF A PERMIT NOR REVIEWING OF SPECS & DRAWINGS NOR INSPECTIONS MADE DURING INSTALLATION BY THE OFFICIAL HAVING JURISDICTION SHALL RELIEVE THE OWNER FROM REQUIREMENTS OF THE ONTARIO BUILDING CODE AND ANY OTHER REFERENCED REQUIREMENTS.

FINAL GRADING CERTIFICATE REQ'D BEFORE FINAL INSPECTION SIGN-OFF

P.ENG SOILS REPORT IS REQ'D TO CONFIRM BEARING CAPACITY OF SOILS. SEE FIELD INSPECTOR

CERTIFICATE OF U/S OF FOOTING ELEVATION IND P.ENG SOILS REPORT REQ'D AT FOOTING INSPECTION (see inspector)


MIN. 4' FROST PROTECTION FOR ALL FOOTINGS

CITY OF CAMBRIDGE **BUILDING DIVISION**

THESE PLANS have been examined for compliance with the Ontario Building Code Requirements. A Building Permit is in Order to issue subject to any hanges noted under the condition that the building will nstructed in accordance with the code


2023-03-13 Thomas Weekhar INSPECTOR

DATE

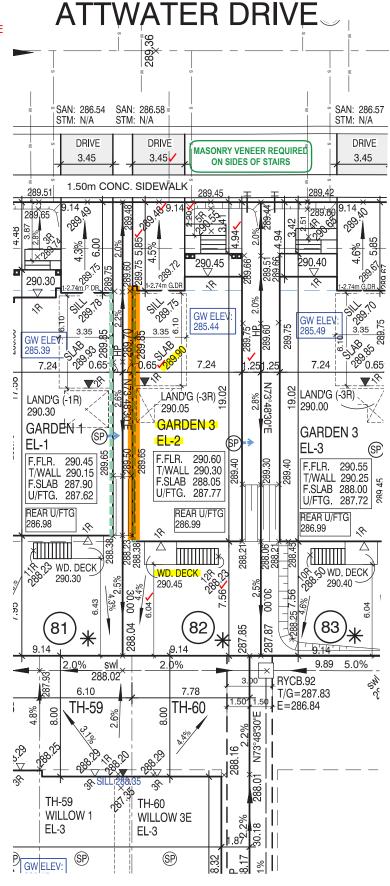

CITY OF CAMBRIDGE **GRADING APPROVAL** And Shill 02/07/2023 SIGNATURE

Clear stone must be used when the building separation by the City prior to the placement of stone. The depth of the clear stone shall not be less than 150mm and placed on the geotextile membrane.

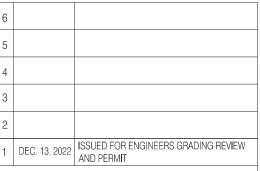

We certify that the proposed grades at the lot corners are correct, and that the lot grading of the subject lot is in general conformity to the approved subdivision grading plans and City of Cambridge standards.



CITY OF CAMBRIDGE **ZONING APPROVAL** 02/14/2023 DATE

45 MINUTE RATED WALL WITH SIDE YARD < 1.2m

It is the builder's complete responsibility to ensure that all plans submitted for approval fully comply with the Architectural Guidelines and all applicable regulations and requirements including zoning provisions and any provisions in the subdivision agreement. The Control Architect is not responsible in any way for exampling as appropriate site (ditting) plage or examining or approving site (lotting) plans or working drawings with respect to any zoning or building code or permit matter or that any house can be properly built or located on its lot.

This is to certify that these plans comply with the applicable Architectural Design Guidelines approved by the City of CAMBRIDGE.

JOHN G. WILLIAMS LTD., ARCHITECT AND APPROVA APPROVED BY: DATE: ___ DEC 21, 2022 This stamp certifies compliance with the applicable Design Guidelines only and bears no further professional responsibility

REVISIONS:

E CONTRACTOR SHALL CHECK AND VERIFY ALL DIMENSIONS AND CONDITIONS ON E BEFORE PROCEEDING WITH CONSTRUCTION. ANY DISCREPANCIES SHALL BE PORTED TO JARDIN DESIGN GROUP INC. PRIOR TO COMMENCEMENT OF WORK.

ARDIN DESIGN GROUP INC. IS NOT RESPONSIBLE FOR THE ACCURACY OF SURVEY. IRUCTURAL OR ENGINEERING INFORMATION SHOWN ON THESE DRAWINGS OR FOR ONSTRUCTION STARTED PRIOR TO THE ISSUANCE OF A BUILDING PERMIT. REFER TO HE APPROPRIATE ENGINEERING DRAWINGS BEFORE PROCEEDING WITH WORK.

S CONSTRUCTED INVERTS MUST BE VERIFIED PRIOR TO POURING FOOTINGS.

ARDIN DESIGN GROUP INC. HAS NOT BEEN RETAINED TO CARRY OUT GENERAL REVIEW THE WORK AND ASSUMES NO RESPONSIBILITY FOR THE FAILURE OF THE INTRACTOR OR SUB CONTRACTOR TO CARRY OUT THE WORK IN ACCORDANCE WITH IE CONTRACT DOCUMENTS.

HIS DRAWING IS AN INSTRUMENT OF SERVICE, IS PROVIDED BY AND IS THE PROPERTY JARDIN DESIGN GROUP INC. THIS DRAWING IS NOT TO BE SCALED.

SCALE 1:250 5m 10m

BARLASSINA CONSTRUCTION INC.

PROJ. No. 21-35

LOT No. 82

MUNICIPAL ADDRESS



The undersigned has reviewed and takes responsibility for thi design and has the qualifications and meets the requirements set out in the Ontario Building Code to be a designer



jardin design group inc.

FIRM NAME



64 JARDIN DR. SUITE 3A VAUGHAN ONT. L4K 3P3 TEL: 905 660-3377 FAX: 905 660-3713 EMAIL: info@jardindesign.ca