

CONSTRUCTION SUMMARY

Red Oaks - Roundel Homes Inc.

RECEIVED

APR 14 2023 TEL: RES.: 306-209-2680

PURCHASER: Lizhong DING

LOT / PHASE 31 / 1	REG. PLAN # 65M-4737	HOUSE TYPE Pinetree 3 Elev 2		
-----------------------	-------------------------	---------------------------------	--	--

CABINETRY ACCESSORIES

1 - KITCHEN CABINETS UPPER - FULL DEPTH ABOVE FRIDGE - WITH GABLES - 600MM - PRICE IS EACH - STANDARD 14Apr23 Note:	
--	--

ELECTRICAL

1 - ABOVE KITCHEN ISLAND - ADD LIGHT AND SWITCH - NO FIXTURE INCLUDED 14Apr23 Note:	
1 - LIGHT AND SWITCH - NO FIXTURE INCLUDED - LIVING ROOM 14Apr23 Note:	
1 - PLUG - ELECTRICAL PLUG - TO BE INSTALLED OVER FIREPLACE 14Apr23 Note:	
1 - PLUG - ELECTRICAL PLUG WITH GFI AND SWITCH - FOR FESTIVE LIGHTING 14Apr23 Note:	
1 - ELECTRIC VEHICLE ROUGH-IN PROVISION ONLY FOR FUTURE ELECTRIC CAR (CONDUIT FROM BASEMENT INTO JUNCTION BOX IN GARAGE WITH PULL STRING, NO WIRE) 14Apr23 Note:	

FIREPLACE AND ACCESSORIES

1 - GAS LINE ROUGH-IN FOR DRYER (INCLUDES ELECTRICAL OUTLET) - FIRST FLOOR 14Apr23 Note:	
---	--

PLUMBING

1 - WATER LINE FOR FRIDGE - ROUGH-IN ONLY 14Apr23 Note:	
--	--

PROMOTIONAL

1 - PARTIAL REDEMPTION OF PROMOTIONAL PACKAGE \$4,045 BALANCE FORWARD \$5,955 TO BE USED AT A LATER DATE. ORIGINAL PROMOTIONAL PACKAGE OF \$10,000.00 AS PER SCHEDULE PE 14Apr23 Note:	
---	--

This Document is Extremely Time Sensitive - Printed 14 Apr 23 at 13:00

add light
centered
above island

Add Plug place
over Fire place




Pinetree 3

ELEV. 1 • 2,682 sq.ft. | ELEV. 2 • 2,673 sq.ft. | ELEV. 3 • 2,686 sq.ft.
Includes 38 sq.ft. of open area.

Gas Line →
Underline →
for Fridge





Add Light
in Living
Room

Electric Car
Charger Rough in
Festive
Plug.

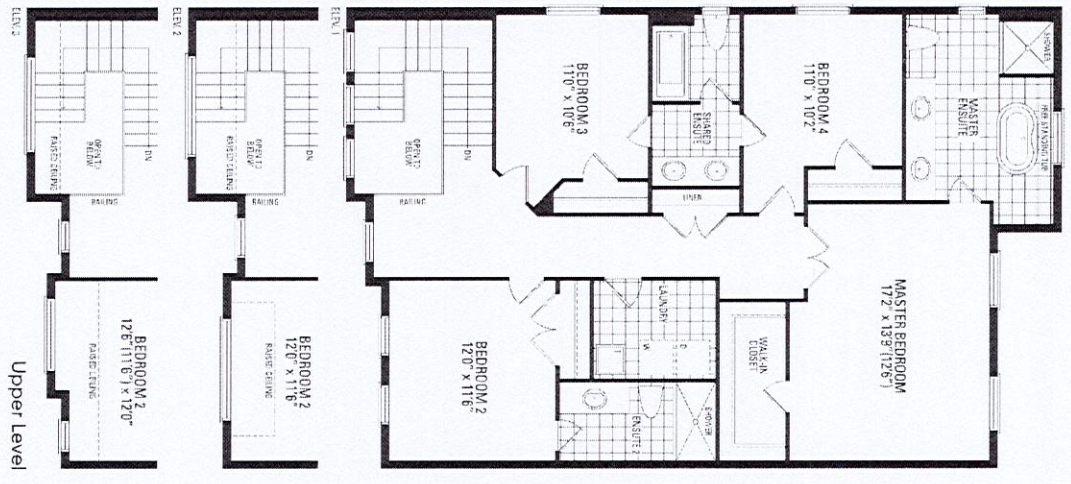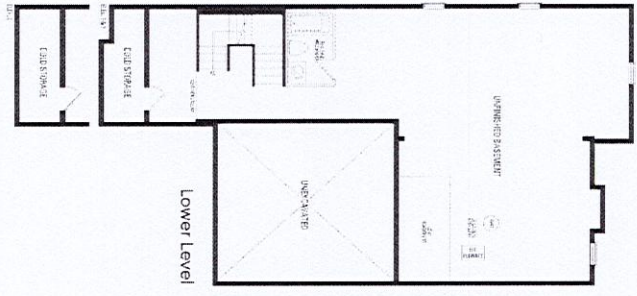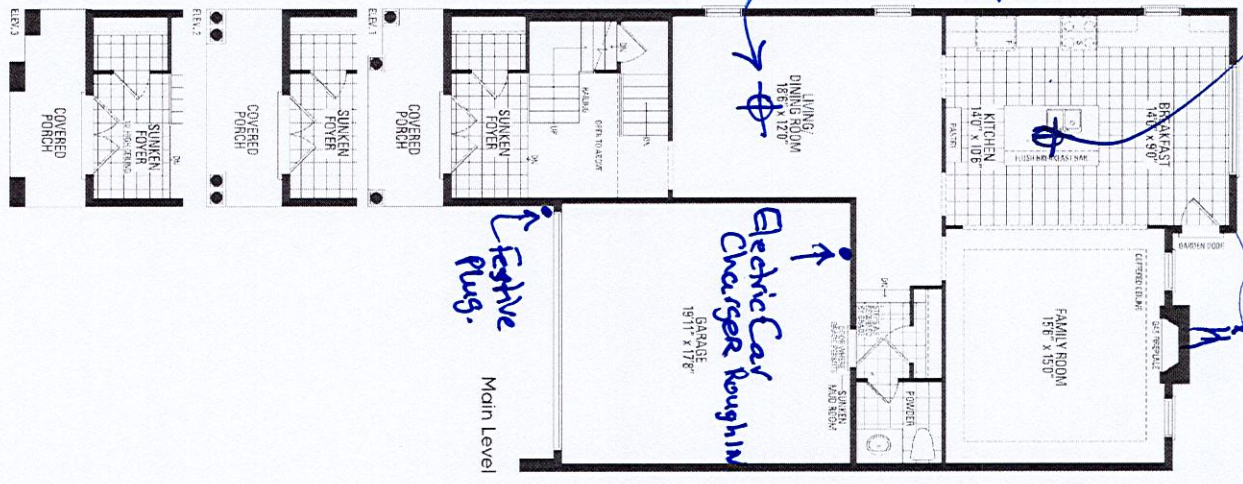


Orientation of home may be reversed and purchaser agrees to accept the same. Steps and porches may vary at any exterior entrance ways due to grading variance. Actual usable floor space may vary from the stated floor areas. All renderings are artist's concept. Dimensions, specifications and architectural detailing subject to modifications. Roofline and adjoining model types may vary due to stiling. E. & O. E. June 2022



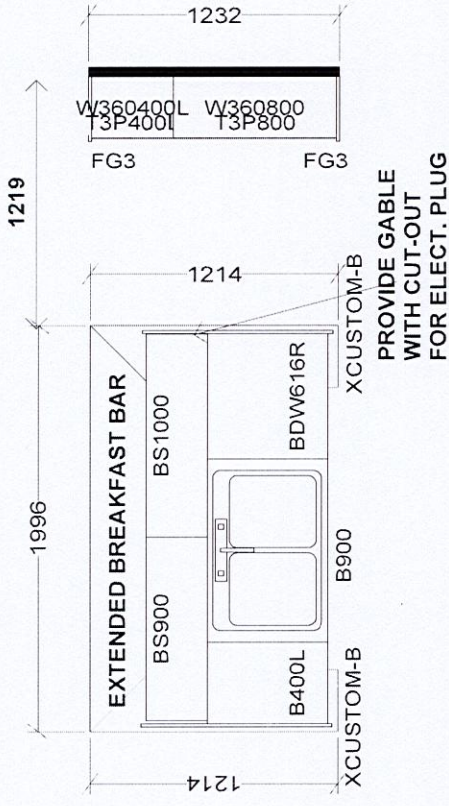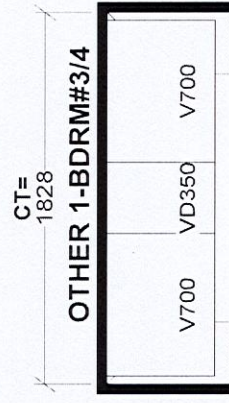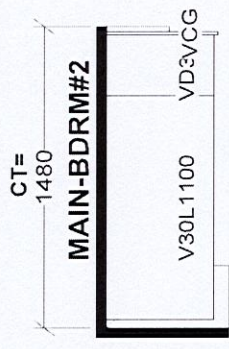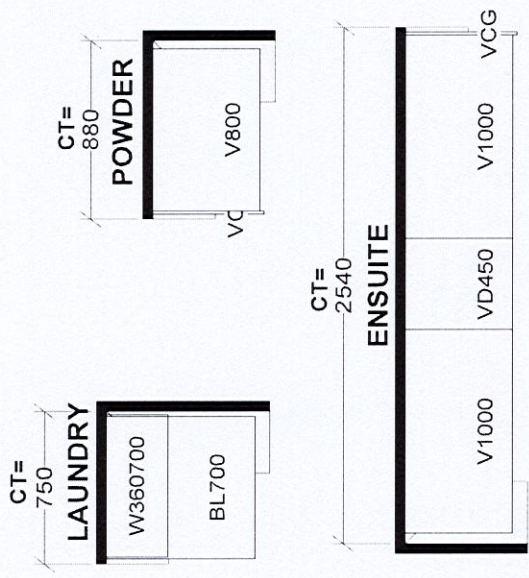

Full Depth Fridge

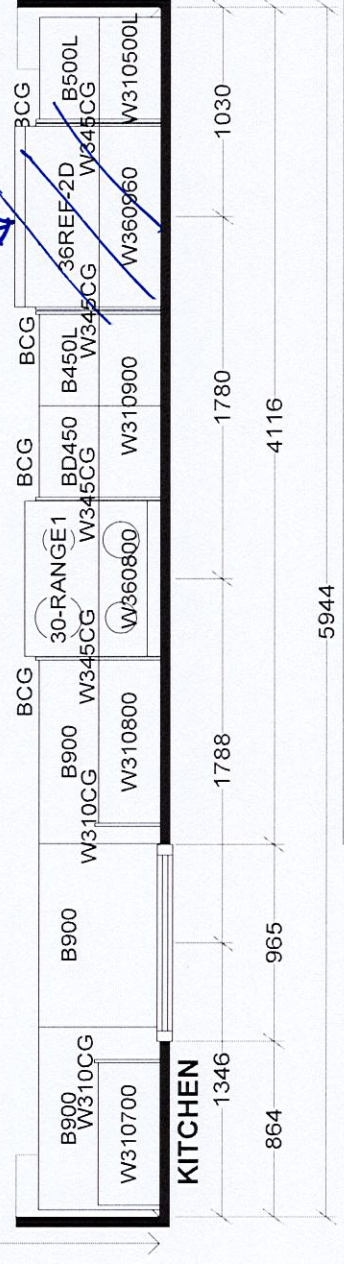

Selba Industries		J #	
W WDT	W HGT	W CNT	JOB NUMBER:
FLOOR HGHT			BUILDER: GREENPARK
DOOR HGHT			SITE: ROUNDEL, Richmond Hill
ST CENT	2X4	VENT BOX COVER	MODEL: PINETREE 3X EL 1,2,3
DESIGNER: KS			LOT #:
DATE: JUNE 7 21			