

CONSTRUCTION SUMMARY		RECEIVED
Hazel Glenn - Barlassina Construction Inc.		APR 21 2023
PURCHASER: Rochelle M. ATKINS		TEL: RES.: 647-546-0833

LOT / PHASE Block 122 TH40 / 1	REG. PLAN #	HOUSE TYPE Willow 2 Elev 3		
-----------------------------------	-------------	-------------------------------	--	--

CONSTRUCTION

1 - PRIMARY ENSUITE - FRAMELESS GLASS SHOWER ENCLOSURE PROVISION - REMOVE SIDE WALL AND REPLACE WITH GLASS TO ACCOMODATE FRAMELESS GLASS SHOWER ENCLOSURE SEE SKETCH 19Apr23 Note:	
---	--

ELECTRICAL

1 - MAIN - FAN - BATHROOM EXHAUST FAN - ENERGY STAR 80 CFM - IN LIEU OF STANDARD FAN 19Apr23 Note:	
1 - PRIMARY ENSUITE - BATHROOM EXHAUST FAN - ENERGY STAR 80 CFM - IN LIEU OF STANDARD FAN 19Apr23 Note:	
1 - LIGHT AND SWITCH - NO FIXTURE INCLUDED - LIVING ROOM 19Apr23 Note:	
1 - ABOVE KITCHEN ISLAND - ADD LIGHT AND SWITCH - NO FIXTURE INCLUDED 19Apr23 Note:	
1 - ELECTRIC VEHICLE ROUGH-IN PROVISION ONLY FOR FUTURE ELECTRIC CAR (CONDUIT FROM BASEMENT INTO JUNCTION BOX IN GARAGE WITH PULL STRING, NO WIRE) 19Apr23 Note:	

HEATING AND AIR CONDITIONING

1 - HUMIDIFER 19Apr23 Note:	
--------------------------------	--

MIRRORS AND GLASS

1 - MASTER ENSUITE - FRAMELESS GLASS SHOWER ENCLOSURE - INCLUDES CHROME KNOB AND HINGES 19Apr23 Note:	
--	--

PLUMBING

1 - BACKYARD - HOSE BIB - EXTERIOR FROST FREE 19Apr23 Note:	
1 - WASHROOM - 3 PIECE ROUGH-IN IN BASEMENT 19Apr23 Note:	

PROMOTIONAL




1 - PARTIAL REDEMPTION OF PROMOTIONAL PACKAGE \$8,430.00 BALANCE FORWARD \$1,570.00 TO BE USED AT A LATER DATE. ORIGINAL PROMOTIONAL PACKAGE OF \$10,000.00 AS PER SCHEDULE PE. 19Apr23 Note:	
--	--

This Document is Extremely Time Sensitive - Printed 19 Apr 23 at 13:22

BLK 122 TA40

Willow 2

ELEVATION 1, 2 & 3 - 1,795 sq.ft.

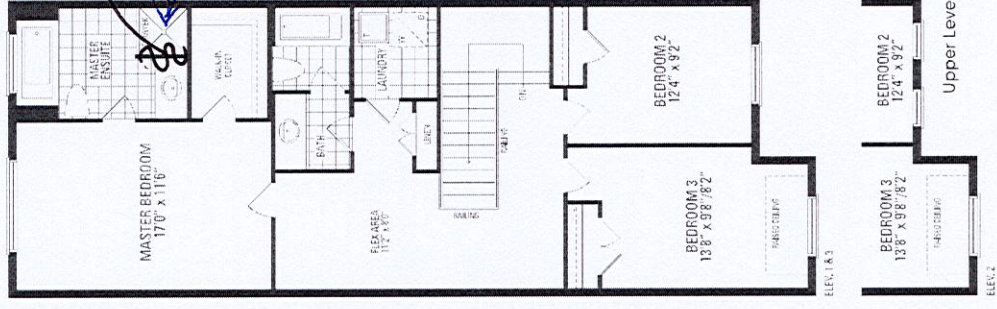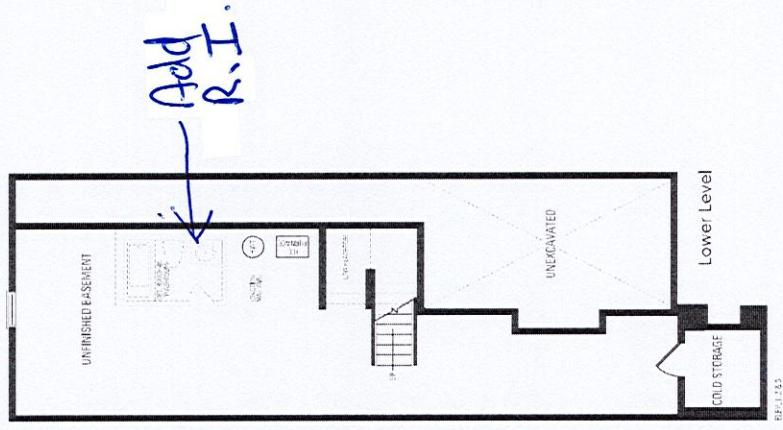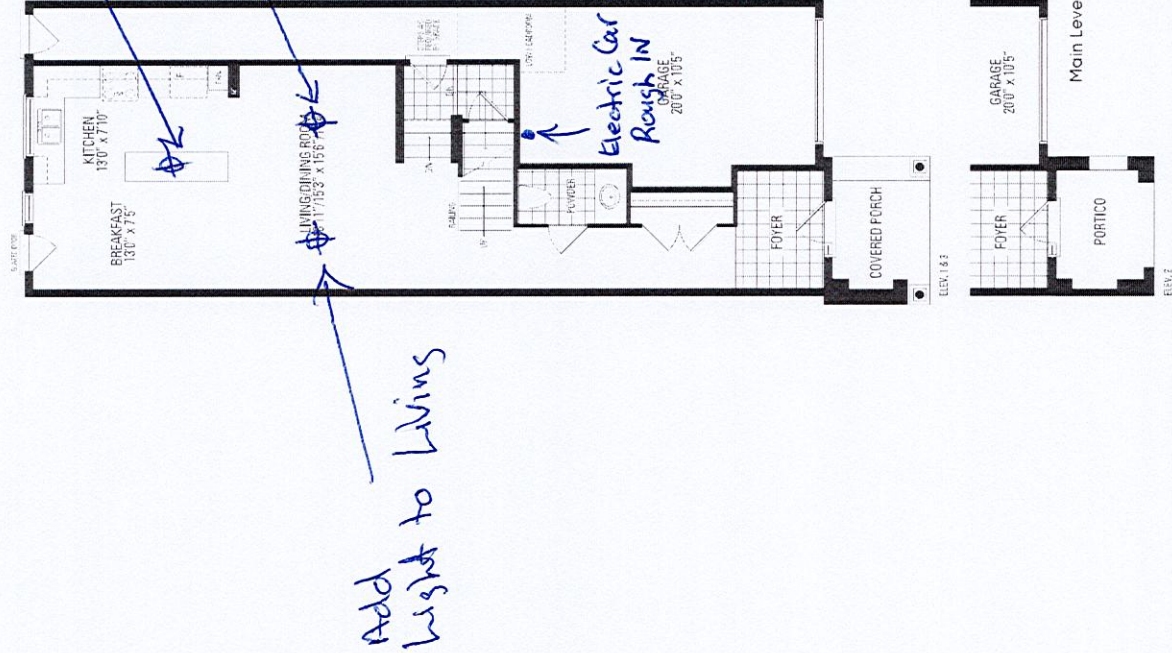

HAZEL
GLENN

Orientation of home may be reversed and purchaser agrees to accept the same. Steps and porches may vary at any exterior entrance ways due to grading variance. Actual usable floor space may vary from the stated floor areas. All renderings are artist's concept. Dimensions, specifications and architectural detailing subject to modifications. Roofline and adjoining model types may vary due to siting. E. & O.E. October 2022