

CONSTRUCTION SUMMARY

Hazel Glenn - Barlassina Construction Inc.

RECEIVED
MAY - 4 2023

TEL: RES.: 416-666-6126

PURCHASER: Sadia MIRZA

LOT / PHASE Block 122 TH46 / 1	REG. PLAN #	HOUSE TYPE Willow 2 Elev 2		
-----------------------------------	-------------	-------------------------------	--	--

ELECTRICAL

1 - LIGHT AND SWITCH - NO FIXTURE INCLUDED - LIVING ROOM 03May23 Note:	
1 - RELOCATE STANDARD KITCHEN LIGHT TO BE CENTERED OVER ISLAND 03May23 Note:	

MISCELLANEOUS

1 - GARAGE DOOR OPENER – LIFEMASTER 8155 WITH BELT DRIVE – INLCUDES 1 KEYPAD & 2 HANDHELD CONTROLS - PRICE IS PER GARAGE DOOR 03May23 Note:	
--	--




PLUMBING

1 - WASHROOM - 3 PIECE ROUGH-IN IN BASEMENT 03May23 Note:	
--	--

This Document is Extremely Time Sensitive - Printed 3 May 23 at 16:30

Willow 2

ELEVATION 1, 2 & 3 - 1,795 sq.ft.

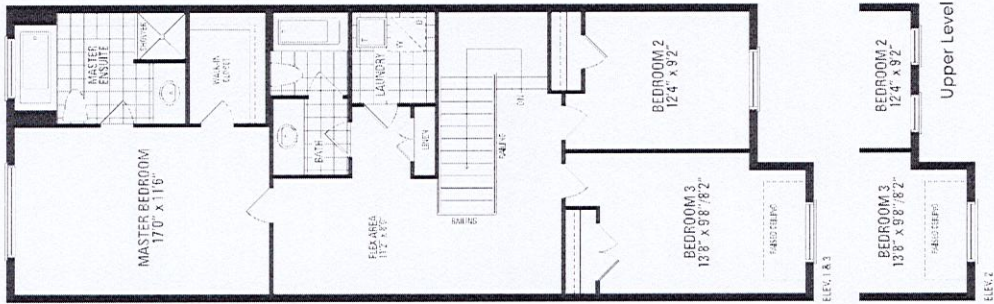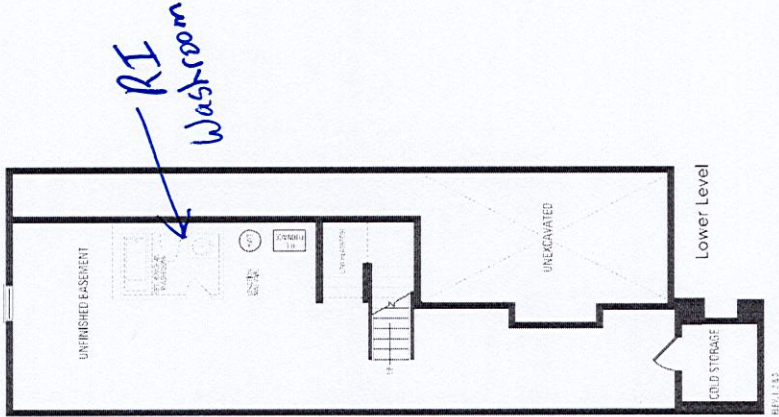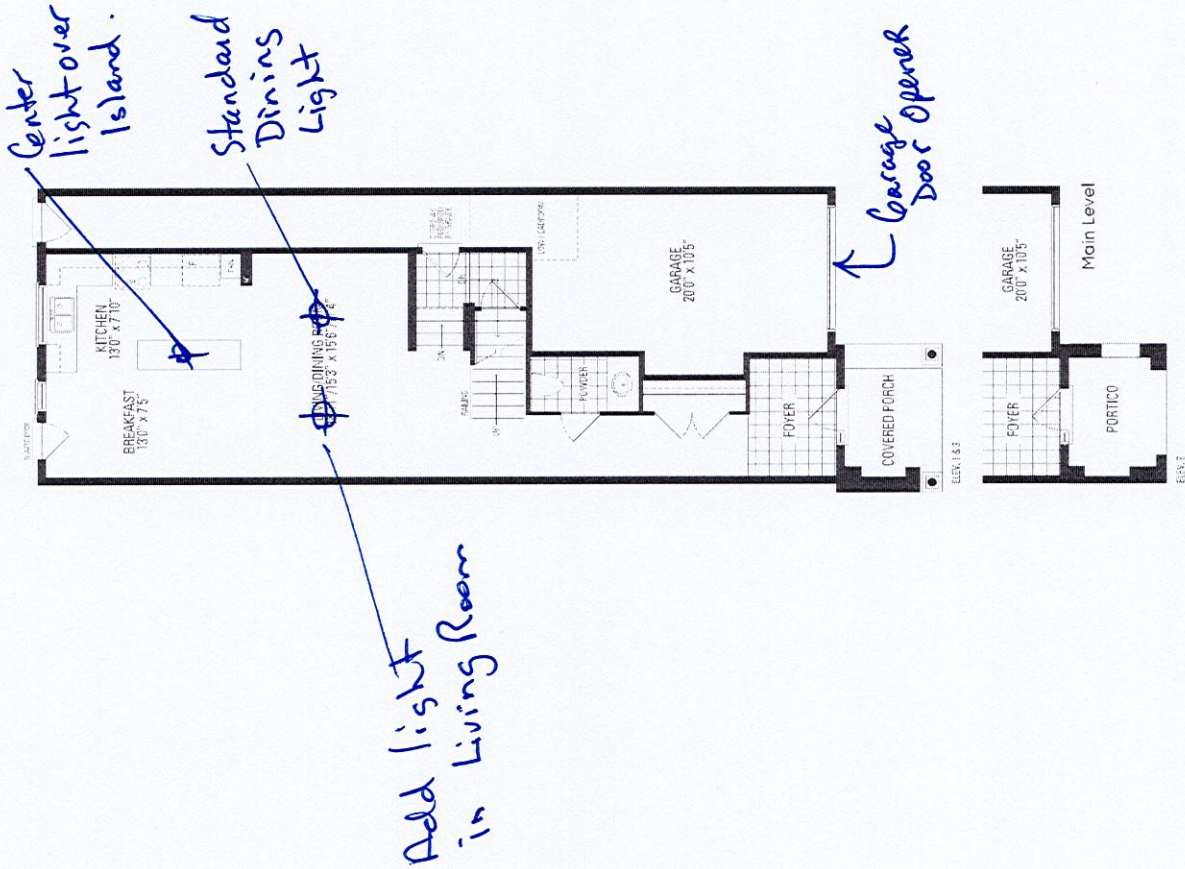

Orientation of home may be reversed and purchaser agrees to accept the same. Steps and porches may vary at any exterior entrance ways due to grading variance. Actual usable floor space may vary from the stated floor areas. All renderings are artist's concept. Dimensions, specifications and architectural detailing subject to modifications. Roofline and adjoining model types may vary due to siting. E. & O.E. October 2022