

CONSTRUCTION SUMMARY

Hazel Glenn - Barlassina Construction Inc.

RECEIVED

MAY 10 2023

TEL: RES.: 647-287-8025

PURCHASERS: Sunil MADHOTRA and Sandeep MADHOTRA

LOT / PHASE 66 / 1	REG. PLAN #	HOUSE TYPE Garden 3 Elev 1		
-----------------------	-------------	-------------------------------	--	--

CONSTRUCTION

1 - DELETE 1 ENLARGED BASEMENT WINDOW AT REAR OF HOUSE - AS PER DECK CONDITIONS 05May23 Note:		
3 - ENLARGE BASEMENT WINDOWS (MAY REQUIRE WINDOW WELLS) - WINDOW IS 30 INCHES X 24 INCHES 01Dec22 Note:		
1 - FIRST FLOOR INCREASE CEILING HEIGHT FROM 9 FEET TO 10 FEET 01Dec22 Note:		

PROMOTIONAL

1 - LESS BALANCE OF CREDIT FROM PURCHASER EXTRA SHEET IN OFFER 01Dec22 Note:	
---	--



This Document is Extremely Time Sensitive - Printed 9 May 23 at 14:08

Revised Prelim
- Basement
Window

Lot 66 BARLASSINA

Garden 3

ELEVATION 1 & 2 - 2,400 sq.ft. • ELEVATION 3 - 2,415 SQ.FT.

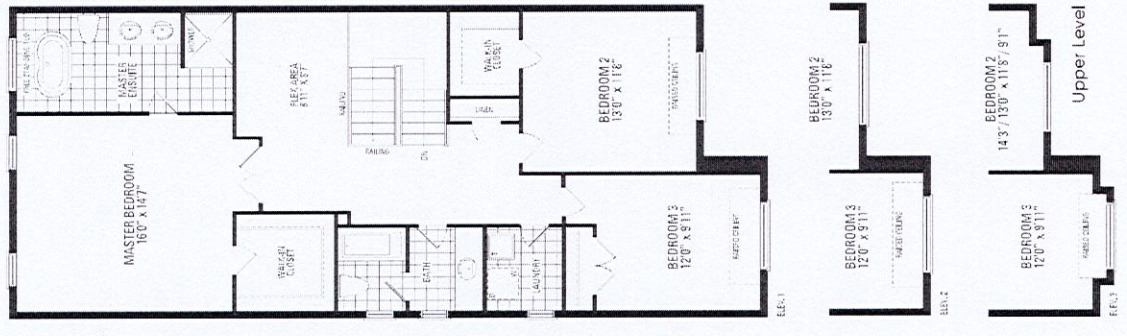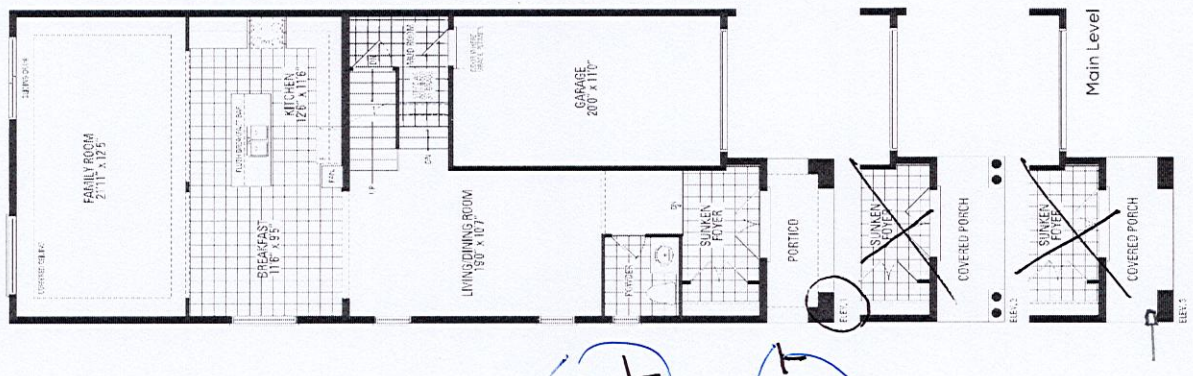

LOT 66

Orientation of home may be reversed and purchaser agrees to accept the same. Steps and porches may vary at any exterior entrance ways due to grading variance. Actual usable floor space may vary from the stated floor areas. All renderings are artist's concept. Dimensions, specifications and architectural detailing subject to modifications. Roofline and adjoining model types may vary due to siting. E. & O.E. October 2022