

CONSTRUCTION SUMMARY	
Hazel Glenn - Barlassina Construction Inc.	
PURCHASERS: Saritha Reddy TOOM and Ravinder Reddy TOOM	TEL: RES.: 647-449-3227

LOT / PHASE	REG. PLAN #	HOUSE TYPE		
80 / 1		Garden 3 Elev 1 (3 Bedroom)		

CONSTRUCTION

1 - DELETE 1 ENLARGED BASEMENT WINDOW AT REAR OF HOUSE - AS PER WALK OUT CONDITIONS'	
CREDIT \$650.00 BACK TO PROMOTIONAL PACKAGE IN REFERENCE TO PE #28033 05May23 Note:	Revised
3 - ENLARGE BASEMENT WINDOWS (MAY REQUIRE WINDOW WELLS) - WINDOW IS 30 INCHES X 24 INCHES	
05Dec22 Note:	

PROMOTIONAL

1 - NEW PROMO BALANCE \$8,700.00 05May23 Note:	
1 - LESS CREDIT FROM PURCHASER EXTRA SHEET IN OFFER 05Dec22 Note: PROMO BALANCE REMAINING \$8,050.00	

This Document is Extremely Time Sensitive - Printed 9 May 23 at 9:27



Cons.




Lot 80

Garden 3

ELEVATION 1 & 2 - 2,400 sq.ft. • ELEVATION 3 - 2,445 SQ.FT.

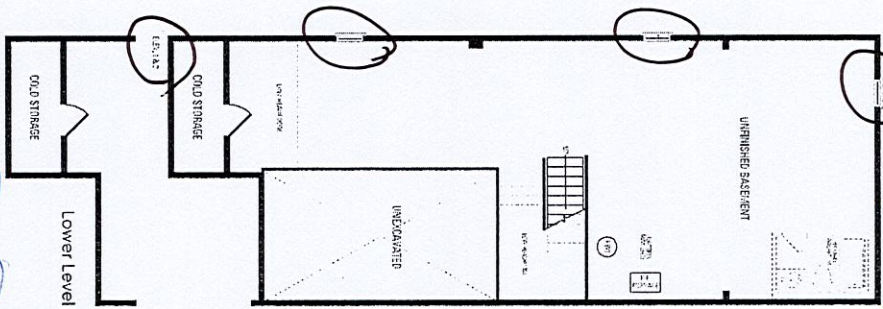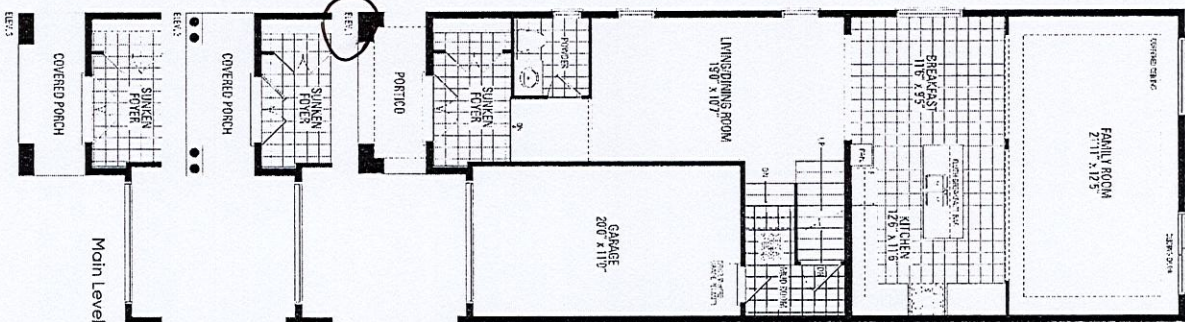

\* Enlarge Basement Windows

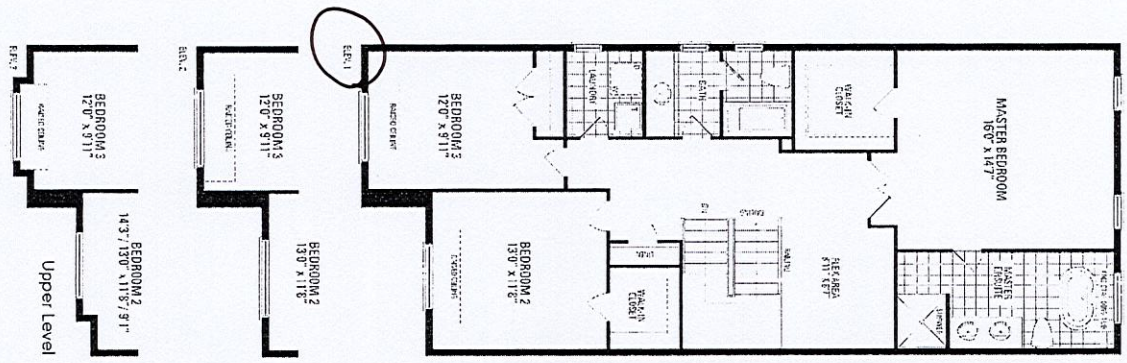

Orientation of home may be reversed and purchaser agrees to accept the same. Steps and porches may vary at any exterior entrance ways due to grading variance. Actual usable floor space may vary from the stated floor areas. All renderings are artist's concept. Dimensions, specifications and architectural detailing subject to modifications. Roofline and adjoining model types may vary due to siting. E. & O.E. October 2022

HAZEL GLENN AGENCY