

CONSTRUCTION SUMMARY		RECEIVED
Hazel Glenn - Barlassina Construction Inc.		MAY 19 2023
PURCHASERS: Saritha Reddy TOOM and Ravinder Reddy TOOM		TEL: RES.: 647-449-3227

LOT / PHASE 80 / 1	REG. PLAN #	HOUSE TYPE Garden 3 Elev 1 (3 Bedroom)		
-----------------------	-------------	---	--	--

CONSTRUCTION

1 - DELETE 1 ENLARGED BASEMENT WINDOW AT REAR OF HOUSE - AS PER WALK OUT CONDITIONS'  CREDIT \$650.00 BACK TO PROMOTIONAL PACKAGE IN REFERENCE TO PE #28033 05May23 Note:	
3 - ENLARGE BASEMENT WINDOWS (MAY REQUIRE WINDOW WELLS) - WINDOW IS 30 INCHES X 24 INCHES 05Dec22 Note:	

ELECTRICAL

1 - PLUG - ELECTRICAL PLUG 5FT FROM FLOOR FOR FUTURE WALL MOUNTED TV 17May23 Note: SEE SKETCH <div>Family Room</div>	
1 - LIGHT AND SWITCH - NO FIXTURE INCLUDED - LIVING ROOM 17May23 Note:	
1 - ABOVE KITCHEN ISLAND - ADD LIGHT AND SWITCH - NO FIXTURE INCLUDED 17May23 Note:	

PLUMBING

1 - HOSE BIB - EXTERIOR FROST FREE 17May23 Note: 1 @ REAR OF HOUSE	
1 - WATER LINE FOR FRIDGE - ROUGH-IN ONLY 17May23 Note:	

PROMOTIONAL

1 - PARTIAL REDEMPTION OF PROMOTIONAL PACKAGE \$1,775.00 BALANCE FORWARD \$6,925.00 TO BE USED AT A LATER DATE. ORIGINAL PROMOTIONAL PACKAGE OF \$10,000.00 AS PER SCHEDULE PE. 17May23 Note:	
1 - NEW PROMO BALANCE \$8,700.00 05May23 Note:	
1 - LESS CREDIT FROM PURCHASER EXTRA SHEET IN OFFER 05Dec22 Note: PROMO BALANCE REMAINING \$8,050.00	




This Document is Extremely Time Sensitive - Printed 17 May 23 at 11:41



Lot 80

# Garden 3

ELEVATION 1 & 2 - 2,400 sq.ft. • ELEVATION 3 - 2,400 sq.ft.

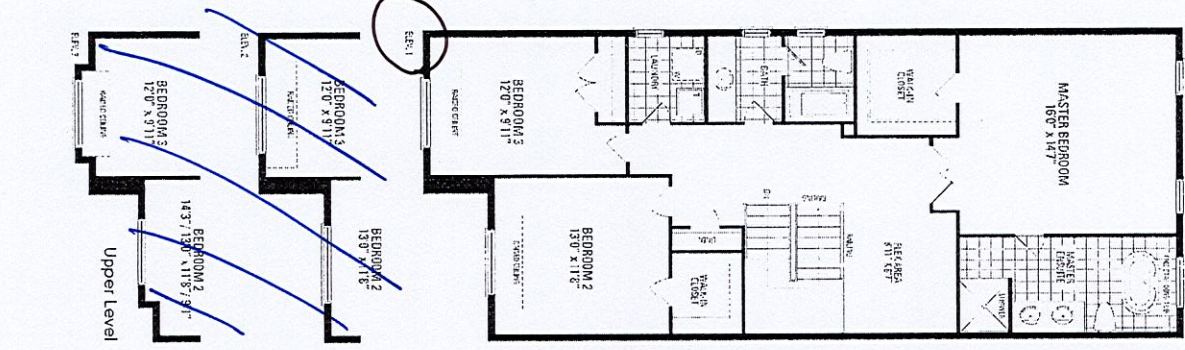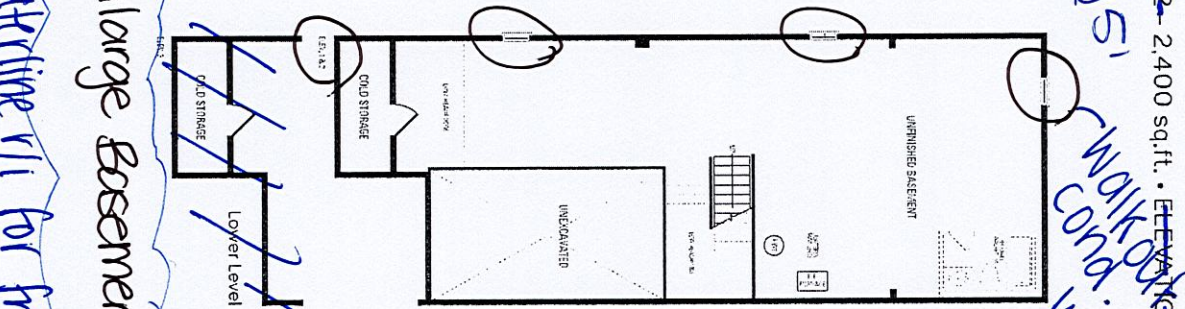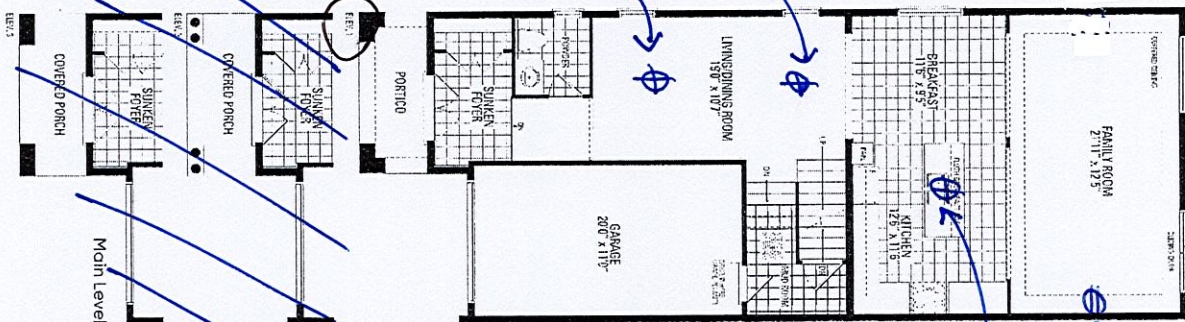

Orientation of home may be reversed and purchaser agrees to accept the same. Steps and porches may vary at any exterior entrance ways due to grading variance. Actual usable floor space may vary from the stated floor areas. All renderings are artist's concept. Dimensions, specifications and architectural detailing subject to modifications. Roofline and adjoining model types may vary due to siting. E. & O.E. October 2022

HAZEL GLENN  
ARCHT