

CONSTRUCTION SUMMARY

RECEIVED

Hazel Glenn - Barlassina Construction Inc.

MAY 25 2023

PURCHASERS: Sarita MAUDHOO and Sattish MAUDHOO

TEL: RES.: 647-970-6267

LOT / PHASE Block 122 TH43 / 1	REG. PLAN #	HOUSE TYPE Willow 3E Elev 2		
-----------------------------------	-------------	--------------------------------	--	--

ELECTRICAL

1 - PLUG - ELECTRICAL PLUG - 5 FEET FROM FINISHED FLOOR FOR FUTURE WALL MOUNTED TV - SEE SKETCH 29Apr23 Note:	
LIVING/DINING ROOM	
1 - LIGHT AND SWITCH - NO FIXTURE INCLUDED - LIVING ROOM 29Apr23 Note:	
1 - ABOVE KITCHEN ISLAND - ADD LIGHT AND SWITCH - NO FIXTURE INCLUDED 29Apr23 Note:	
1 - ELECTRIC VEHICLE ROUGH-IN PROVISION ONLY FOR FUTURE ELECTRIC CAR (CONDUIT FROM BASEMENT INTO JUNCTION BOX IN GARAGE WITH PULL STRING, NO WIRE) 29Apr23 Note:	

HEATING AND AIR CONDITIONING

1 - HUMIDIFER 29Apr23 Note:	
--------------------------------	--

PLUMBING

1 - WASHROOM - 3 PIECE ROUGH-IN IN BASEMENT 29Apr23 Note:	
--	--

PROMOTIONAL


1 - PARTIAL REDEMPTION OF PROMOTIONAL PACKAGE \$2,890.00 BALANCE FORWARD \$7,110.00 TO BE USED AT A LATER DATE. ORIGINAL PROMOTIONAL PACKAGE OF \$10,000.00AS PER SCHEDULE PE. 29Apr23 Note:	
---	--

This Document is Extremely Time Sensitive - Printed 15 May 23 at 9:38

BLK 122 TH 43

Willow 3E

ELEVATION 1 - 1,775 sq.ft. • ELEVATION 2 & 3 - 1,765 sq.ft.

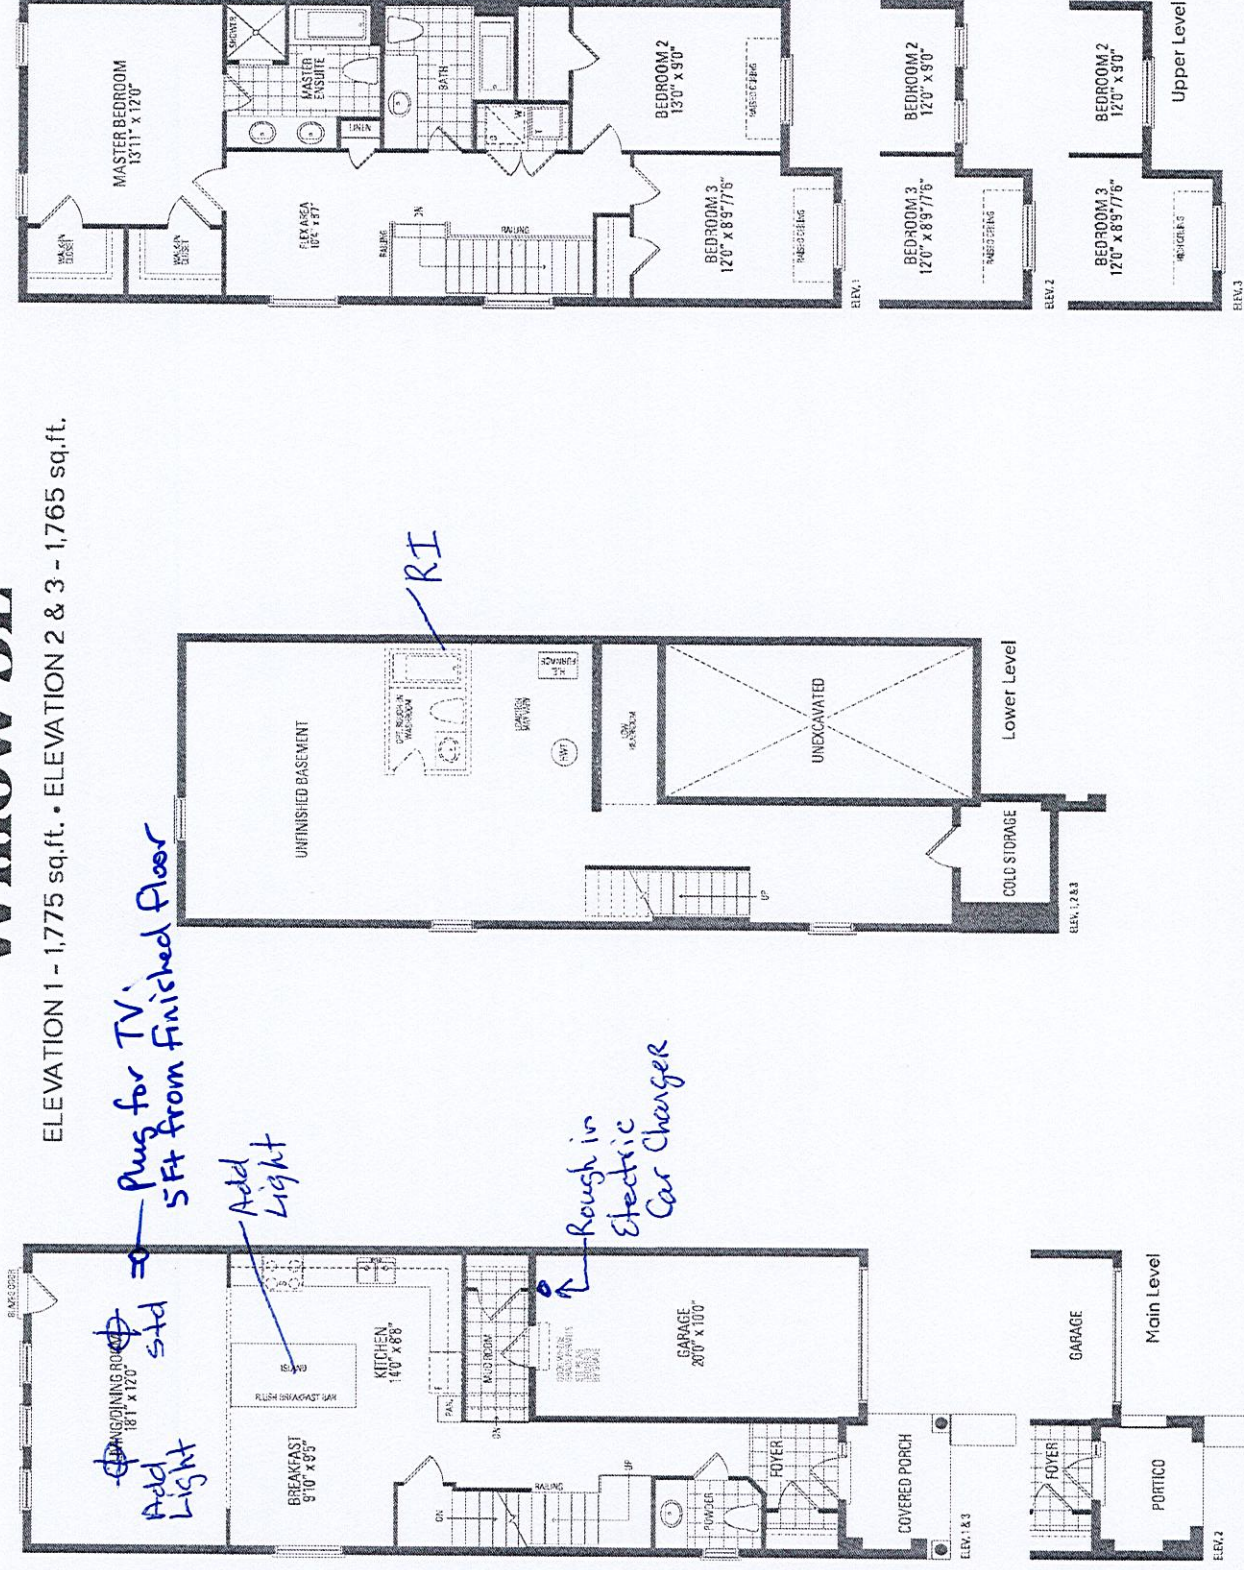

Orientation of home may be reversed and purchaser agrees to accept the same. Steps and porches may vary at any exterior entrance ways due to grading variance. Actual usable floor space may vary from the stated floor areas. All renderings are artist's concept. Dimensions, specifications and architectural detailing subject to modifications. Roofline and adjoining model types may vary due to siting. E. & O.E. October 2022