

CONSTRUCTION SUMMARY RECEIVED

Hazel Glenn - Barlassina Construction Inc.

MAY 25 2023

PURCHASERS: Mustafa Radhwan M Ali M ALI and Ghadah Bassam Ibrahim ALOMARI

TEL: RES.: 416-876-2011

LOT / PHASE 116 / 1	REG. PLAN #	HOUSE TYPE Garden 4 Elev 3		
------------------------	-------------	-------------------------------	--	--

ELECTRICAL

1 - STANDARD DINING ROOM LIGHT TO BE CENTERED BETWEEN LIVING AND DINING ROOM 23May23 Note:	
12 - POT LIGHT - LED - FIRST FLOOR INSTALLATION 23May23 Note: SEE SKETCH	
1 - PLUG - ELECTRICAL PLUG 5' FROM FLOOR FOR FUTURE WALL MOUTED TV 23May23 Note: SEE SKETCH	
1 - RELOCATE STANDARD KITCHEN LIGHT TO BE CENTERED OVER ISLAND 23May23 Note:	

MISCELLANEOUS

1 - GARAGE DOOR OPENER – LIFEMASTER 8155 WITH BELT DRIVE – INCLUDES 1 KEYPAD AND 2 HANDHELD CONTROLS - PRICE IS PER GARAGE DOOR 23May23 Note:	
--	--

PROMOTIONAL

1 - PARTIAL REDEMPTION OF PROMOTIONAL PACKAGE \$5,315.00. BALANCE FORWARD \$4,685.00 TO BE USED AT A LATER DATE. ORIGINAL PROMOTIONAL PACKAGE OF \$10,000.00 AS PER SCHEDULE PE. 23May23 Note:	
---	--

This Document is Extremely Time Sensitive - Printed 24 May 23 at 9:09

LOT 116




HAZEL
GLENN

HAZEL
GLENN

Garden 4

ELEVATION 1 = 2,610 sq.ft. • ELEVATION 2 & 3 = 2,629 sq.ft.

Includes 14 sq.ft. of open area

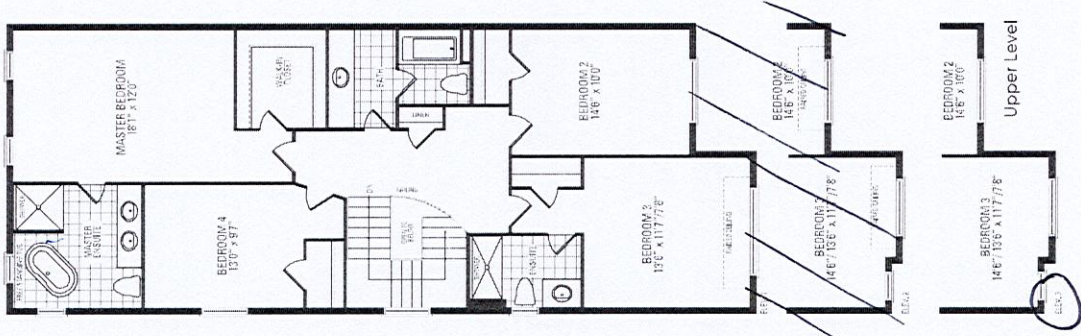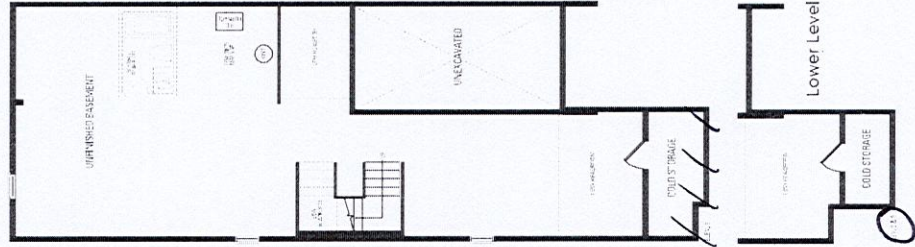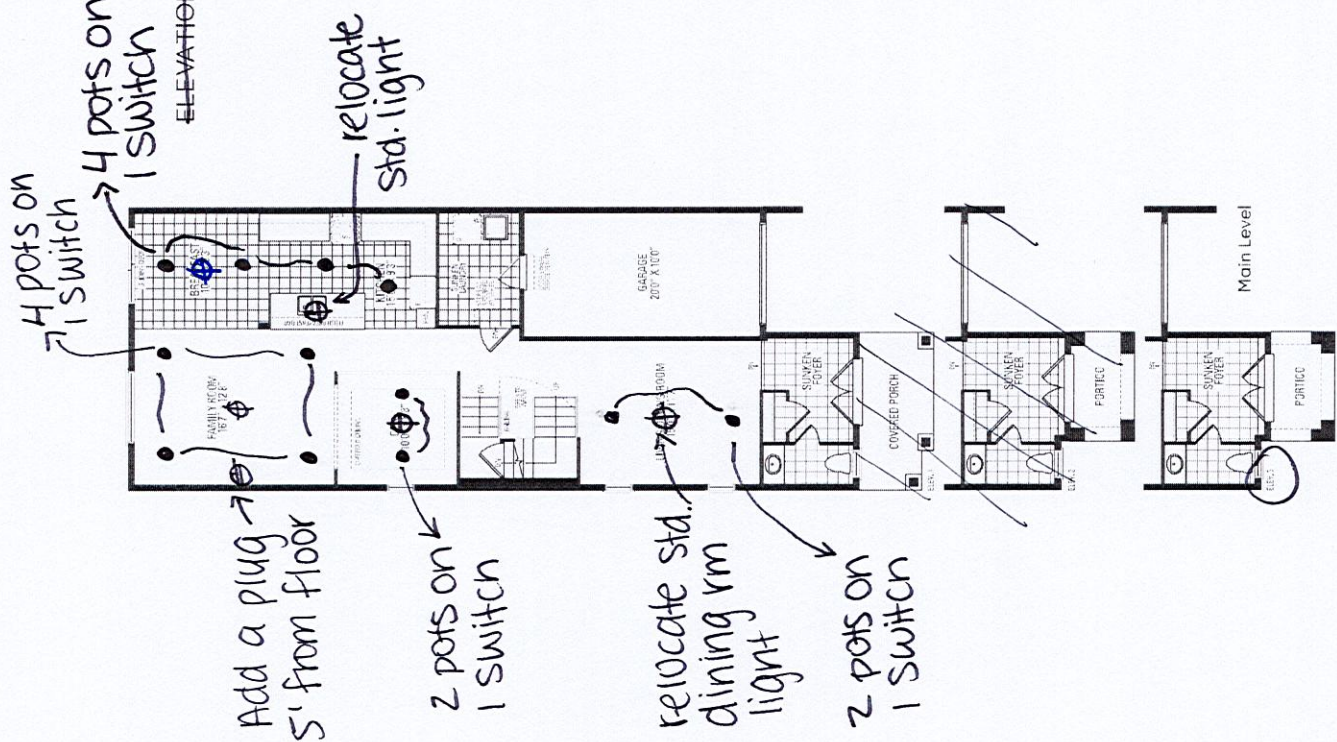

Orientation of home may be reversed and purchaser agrees to accept the same. Steps and porches may vary at any exterior entrance ways due to grading variance. Actual usable floor space may vary from the stated floor areas. All renderings are artist's concept. Dimensions, specifications and architectural detailing subject to modifications. Roofline and adjoining model types may vary due to siting. E. & O.E. October 2022

HAZEL
GLENN