

CONSTRUCTION SUMMARY		RECEIVED
Hazel Glenn - Barlassina Construction Inc.		MAY 25 2023
PURCHASERS: Auday NAMO and Maya JOVIC		TEL: RES.: 647-671-1948

LOT / PHASE	REG. PLAN #	HOUSE TYPE		
68 / 1		Garden 1 Elev 1 (4 Bedroom)		

CONSTRUCTION

1 - SMOOTH CEILINGS ON FIRST FLOOR 23May23 Note:	
---	--

ELECTRICAL

1 - LIGHT AND SWITCH - NO FIXTURE INCLUDED - LIVING ROOM 23May23 Note:	
1 - RELOCATE STANDARD KITCHEN LIGHT TO BE CENTERED OVER ISLAND 23May23 Note:	
1 - PLUG - ELECTRICAL PLUG WITH GFI AND SWITCH - FOR FESTIVE LIGHTING 23May23 Note:	
COVERED PORCH	
1 - ELECTRIC VEHICLE ROUGH-IN PROVISION ONLY FOR FUTURE ELECTRIC CAR (CONDUIT FROM BASEMENT INTO JUNCTION BOX IN GARAGE WITH PULL STRING, NO WIRE) 23May23 Note:	

HEATING AND AIR CONDITIONING

1 - HUMIDIFER 23May23 Note:	
--------------------------------	--

MISCELLANEOUS

1 - GARAGE DOOR OPENER – LIFEMASTER 8155 WITH BELT DRIVE – INCLUDES 1 KEYPAD AND 2 HANDHELD CONTROLS - PRICE IS PER GARAGE DOOR 23May23 Note:	
--	---

PROMOTIONAL

1 - PARTIAL REDEMPTION OF PROMOTIONAL PACKAGE \$9,990.00. BALANCE FORWARD \$10.00 TO BE USED AT A LATER DATE. ORIGINAL PROMOTIONAL PACKAGE OF \$10,000.00 AS PER SCHEDULE PE. 23May23 Note:	
--	--

This Document is Extremely Time Sensitive - Printed 24 May 23 at 9:09

Garden I

Std. dining room light →

Add a light in Living room →

Festive plug →

Floor plan details:

- LIVING/DINING ROOM 24'2" x 12'0"
- KITCHEN 13'0" x 9'5"
- BREAKFAST 9'5" x 9'0"
- GARAGE 20'0" x 11'0"
- SUNKEN FOYER
- POWDER
- COVERED PORCH
- SUNKEN FOYER
- COVERED PORCH
- Main Level

-relocate
std. light
above island

Electric
Vehicle r/l
(conduit)

Festive plug →


- * Smooth Ceilings on first floor
- * Humidifier

Orientation of home may be reversed and purchaser agrees to accept the same. Steps and porches may vary at any exterior entrance ways due to grading variance. Actual usable floor space may vary from the stated floor areas. All renderings are artist's concept. Dimensions, specifications and architectural detailing subject to modifications. Roofline and adjoining model types may vary due to siting. E. & O.E. October 2022

GLENN
HAZEL

11



Optional
4 Bedroom
Layout

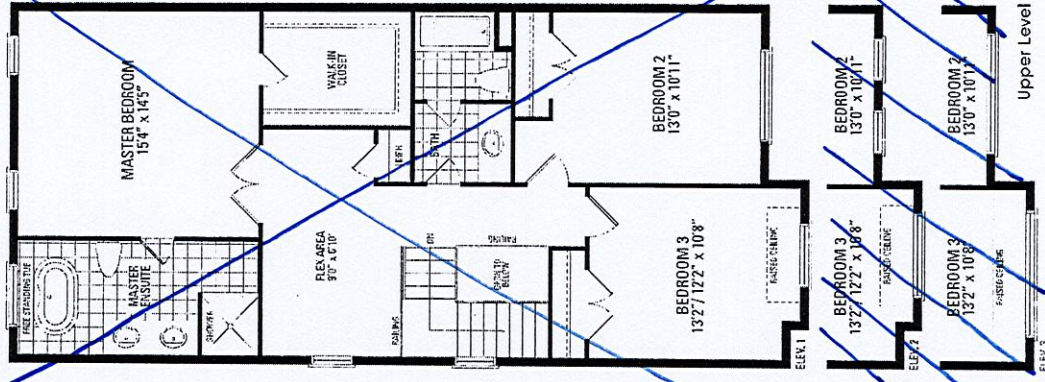

LOT #68

Garden 1

ELEVATION 1 & 2 - 2,190 sq.ft. · ELEVATION 3 - 2,194 sq.ft.
Includes 12 sq.ft. of open area

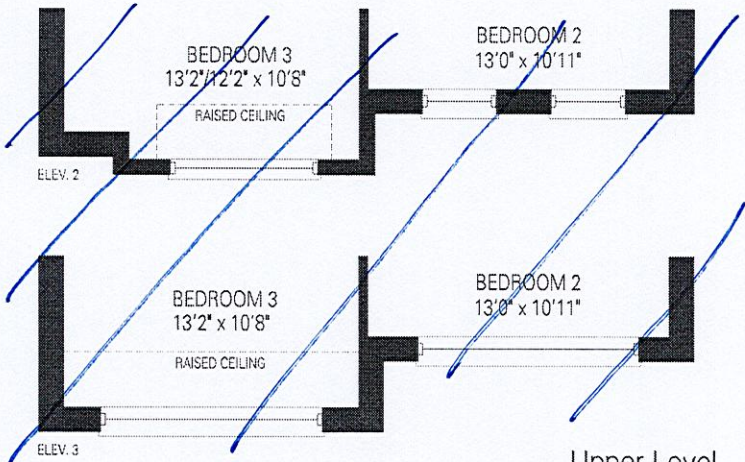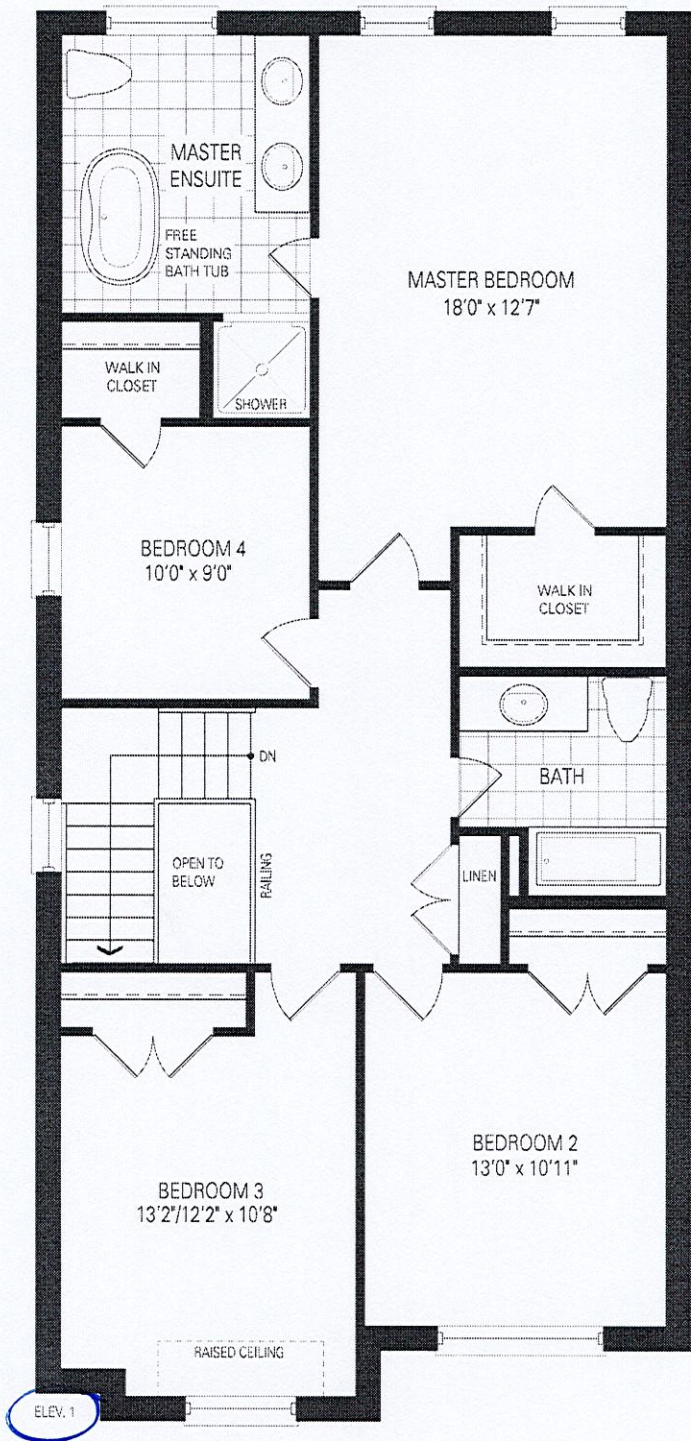

Upper Level
Optional 4 Bedroom Layout

Orientation of home may be reversed and purchaser agrees to accept the same. Steps and porches may vary at any exterior entrance ways due to grading variance. Actual usable floor space may vary from the stated floor areas. All renderings are artist's concept. Dimensions, specifications and architectural detailing subject to modifications. Roofline and adjoining model types may vary due to siting. E. & O.E. October 2022