

CONSTRUCTION SUMMARY			RECEIVED	
Palmetto - Zadorra Estates Corp.			JUN 14 2023	
PURCHASERS: Vivek KUMAR and Ankita SRIVASTAVA			TEL:	
LOT / PHASE	REG. PLAN #	HOUSE TYPE		
141 / 1		Carol 12 Elev 2		

CONSTRUCTION

1 - FIRST FLOOR INCREASE CEILING HEIGHT FROM 9 FEET TO 10 FEET 12Jun23 Note:	
2 - ENLARGED BASEMENT WINDOWS (MAY REQUIRE WINDOW WELLS) - WINDOW IS 30 INCHES X 24 INCHES ***SEE SKETCH*** 09Jun23 Note:	


PROMOTIONAL

1 - LESS BALANCE OF CREDIT FROM PURCHASER EXTRA SHEET IN OFFER 12Jun23 Note:	
1 - PARTIAL REDEMPTION OF PROMOTIONAL PACKAGE \$1,300.00 BALANCE FORWARD \$18,700.00 TO BE USED AT A LATER DATE. ORIGINAL PROMOTIONAL PACKAGE OF \$20,000.00 AS PER SCHEDULE PE. 09Jun23 Note:	

This Document is Extremely Time Sensitive - Printed 12 Jun 23 at 13:46

Carol 12 50' LOT

ELEVATION 1 3,230 sq.ft. • ELEVATION 2 3,238 sq.ft. • ELEVATION 3 3,224 sq.ft.
INCLUDES 15 SQ.FT. OF OPEN AREA

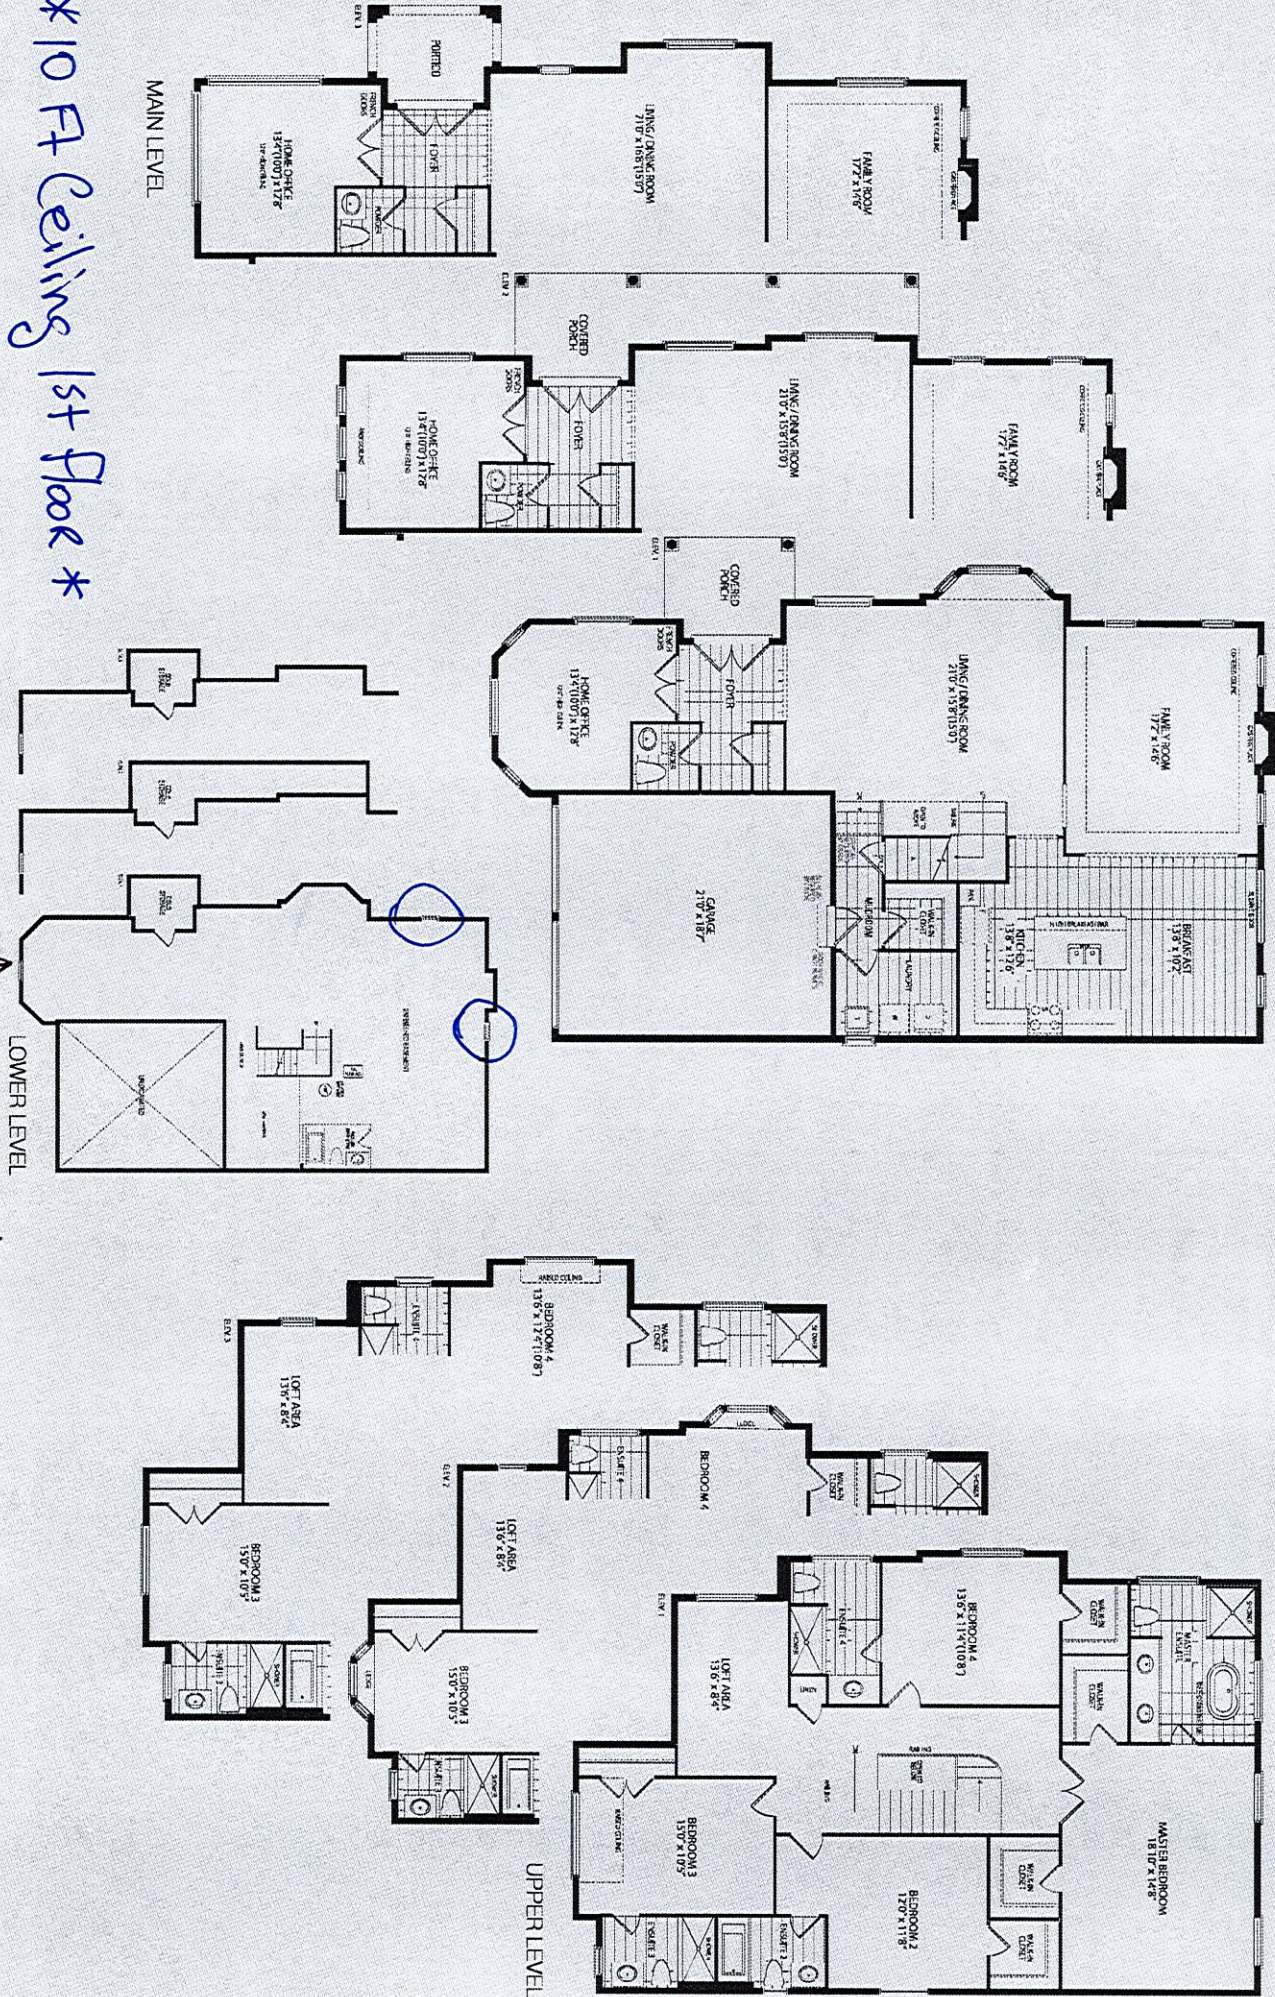

Orientation of home may be reversed and purchaser agrees to accept the same. Steps and porches may vary at any exterior entrance ways due to grading variance. Actual usable floor space may vary from the stated floor areas. All renderings are artist's concept. Dimensions, specifications and architectural detailing subject to modifications. Roofline and adjoining model types may vary due to siting. E. & O. E. May 2023