

"Preliminary"

CONSTRUCTION SUMMARY		RECEIVED
Palmetto - Zadorra Estates Corp.		
PURCHASERS: Antu SINGH and Chandra Bala DEVI		TEL:
JUN 15 2023		

LOT / PHASE	REG. PLAN #	HOUSE TYPE		
11 / 1		River 1 Elev 2		

CONSTRUCTION

2 - ENLARGED BASEMENT WINDOWS (MAY REQUIRE WINDOW WELLS) - WINDOW IS 30 INCHES X 24 INCHES	
12Jun23 Note:	

PROMOTIONAL

1 - PARTIAL REDEMPTION OF PROMOTIONAL PACKAGE \$1,300.00 BALANCE FORWARD \$8,700.00 TO BE USED AT A LATER DATE. ORIGINAL PROMOTIONAL PACKAGE OF \$10,000.00 AS PER SCHEDULE PE.	
12Jun23 Note:	

EXTRAS AS PER OFFER




The Vendor agrees that notwithstanding any other term or provision in this Agreement included in the Purchase Price and in addition to those items detailed in Schedule GP to the Agreement of Purchase and Sale, the Purchaser is entitled to a credit of Ten	
Worksheet Note:	

This Document is Extremely Time Sensitive - Printed 12 Jun 23 at 10:59

River 1 30' LOT

ELEVATION 1 2,190 sq.ft. • ELEVATION 2 2,190 sq.ft. • ELEVATION 3 2,194 sq.ft.
INCLUDES 18 SQ.FT. OF OPEN AREA

Lot 11
Zachorra

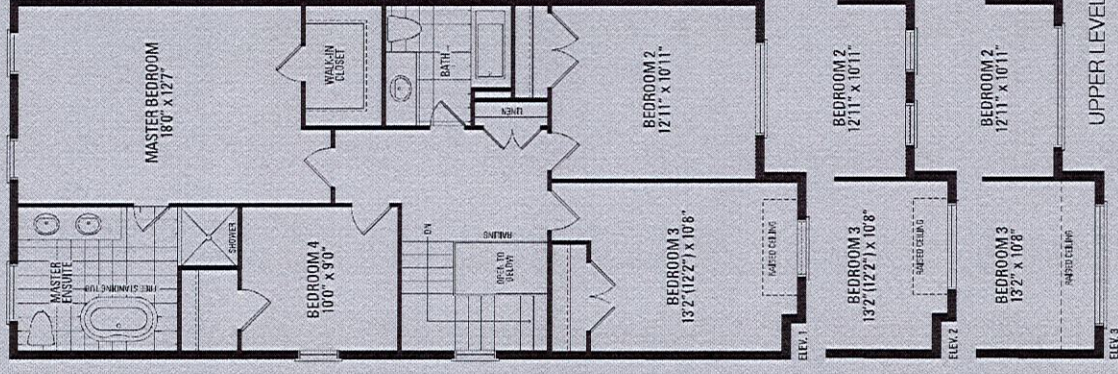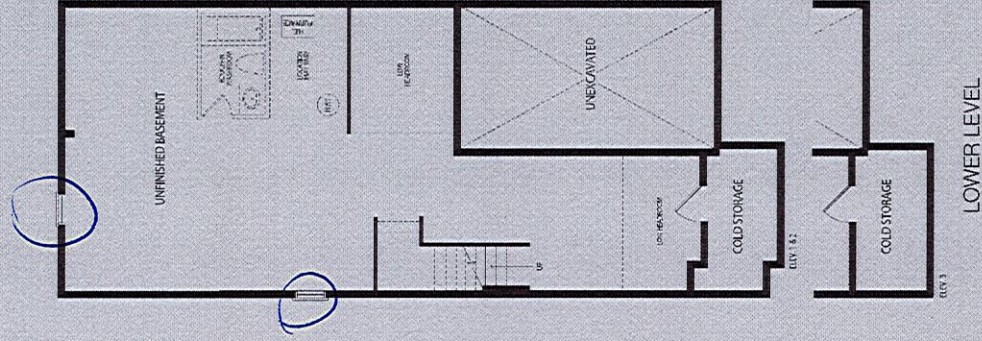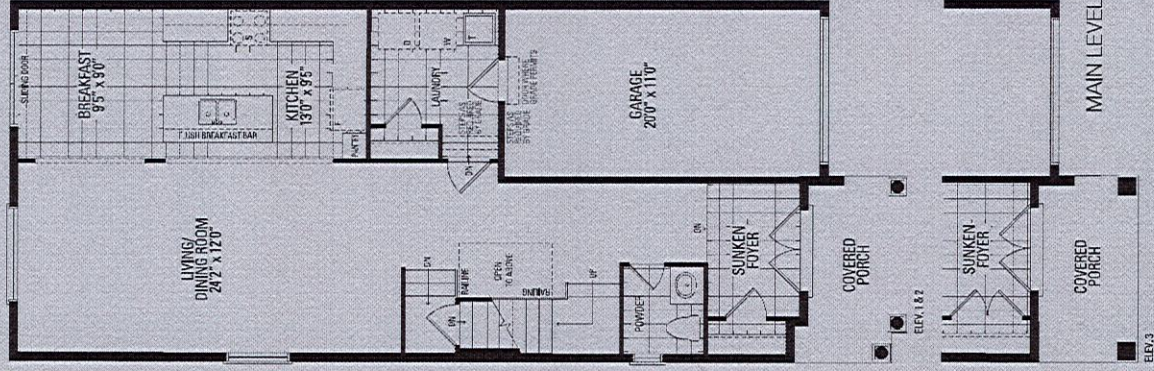

* ENLARGE BASEMENT *
WINDOWS *

Orientation of home may be reversed and purchaser agrees to accept the same. Steps and porches may vary at any exterior entrance ways due to grading variance. Actual usable floor space may vary from the stated floor areas. All renderings are artist's concept. Dimensions, specifications and architectural detailing subject to modifications. Roofline and adjoining model types may vary due to siting. E. & O. E. May 2023