

CONSTRUCTION SUMMARY

Palmetto - Zadorra Estates Corp.

PURCHASER: Xiu Fang HUANG

TEL: RES.: 647-998-8899

LOT / PHASE 166 / 1	REG. PLAN #	HOUSE TYPE Villa 2 Elev 2		
------------------------	-------------	------------------------------	--	--

CONSTRUCTION

3 - ENLARGED BASEMENT WINDOWS (MAY REQUIRE WINDOW WELLS) - WINDOW IS 30 INCHES X 24 INCHES 20Jun23 Note:	
1 - FIRST FLOOR INCREASE CEILING HEIGHT FROM 9 FEET TO 10 FEET 20Jun23 Note:	

PROMOTIONAL

1 - LESS CREDIT FROM PURCHASER EXTRA SHEET IN OFFER 20Jun23 Note:	
---	--


This Document is Extremely Time Sensitive - Printed 21 Jun 23 at 13:03

LOT #166

Villa 2 36' LOT

~~ELEVATION 1 2,527 sq.ft.~~ • ELEVATION 2 2,527 sq.ft. • ~~ELEVATION 3 2,523 sq.ft.~~
INCLUDES 10 SQ.FT. OF OPEN AREA

Enlarge basement windows

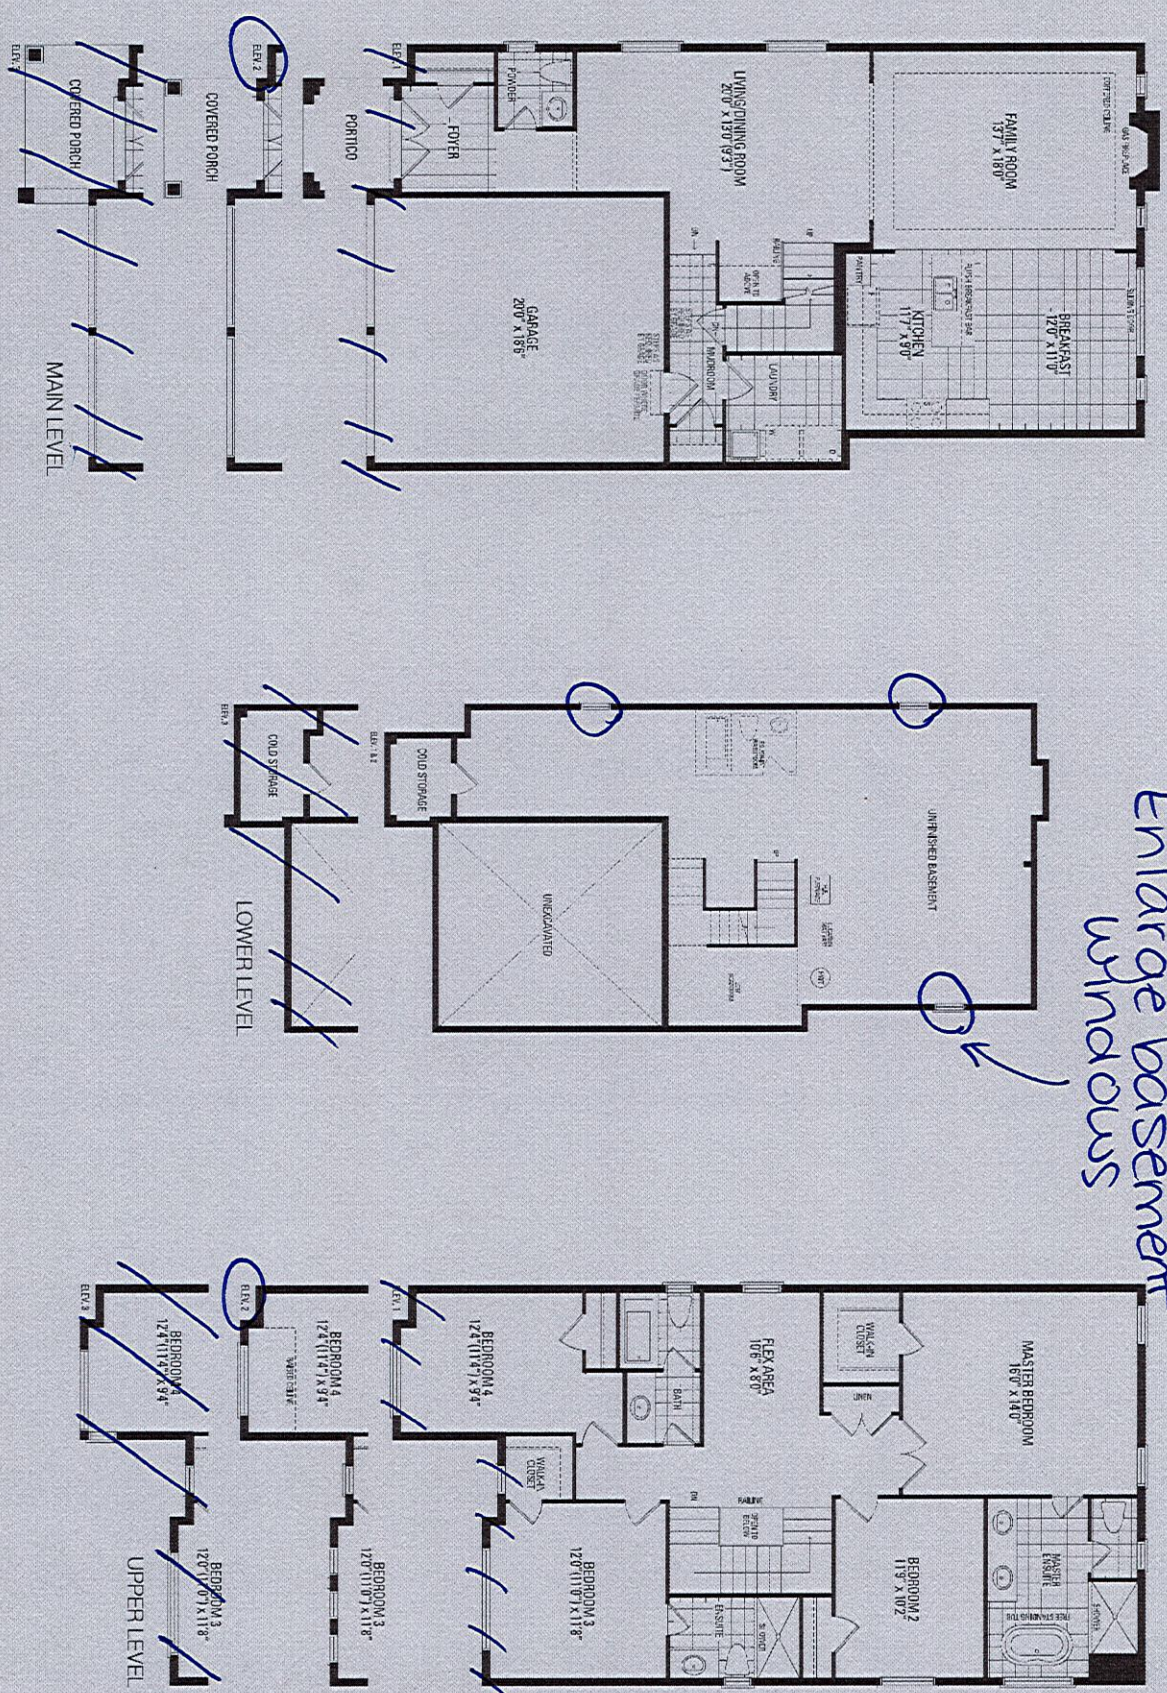

* 10'-0" ceiling height

Orientation of home may be reversed and purchaser agrees to accept the same. Steps and porches may vary at any exterior entrance ways due to grading variance. Actual usable floor space may vary from the stated floor areas. All renderings are artist's concept. Dimensions, specifications and architectural detailing subject to modifications. Roofline and adjoining model types may vary due to siting. E. & O. E. May 2023