

CONSTRUCTION SUMMARY

RECEIVED

Palmetto - Zadorra Estates Corp.

PURCHASERS: Paramjyothi PANDI and Teja Sree MAREEDU

JUL 04 2023

TEL: RES.: 647-861-0552

LOT / PHASE 144 / 1	REG. PLAN #	HOUSE TYPE Villa 2 Elev 1		
------------------------	-------------	------------------------------	--	--

CONSTRUCTION

3 - ENLARGED BASEMENT WINDOWS (MAY REQUIRE WINDOW WELLS) - WINDOW IS 30 INCHES X 24 INCHES 16Jun23 Note:	
---	--




PROMOTIONAL

1 - PARTIAL REDEMPTION OF PROMOTIONAL PACKAGE \$1,950.00 BALANCE FORWARD \$13,050.00 TO BE USED AT A LATER DATE. ORIGINAL PROMOTIONAL PACKAGE OF \$15,000.00 AS PER SCHEDULE PE. 16Jun23 Note:	
---	--

This Document is Extremely Time Sensitive - Printed 16 Jun 23 at 14:53

Villa 2 36' LOT

ELEVATION 1 2,527 sq.ft. • ELEVATION 2 2,527 sq.ft. • ELEVATION 3 2,523 sq.ft.
INCLUDES 10 SQ.FT. OF OPEN AREA

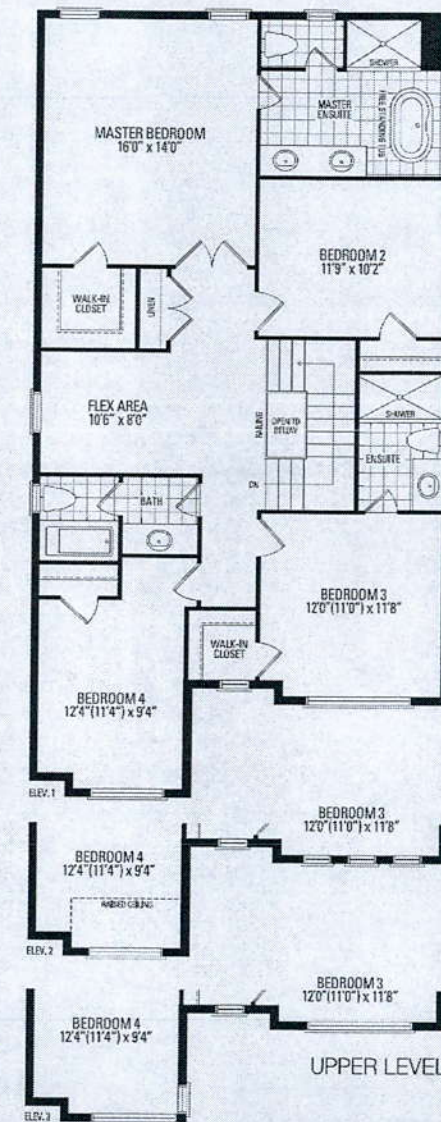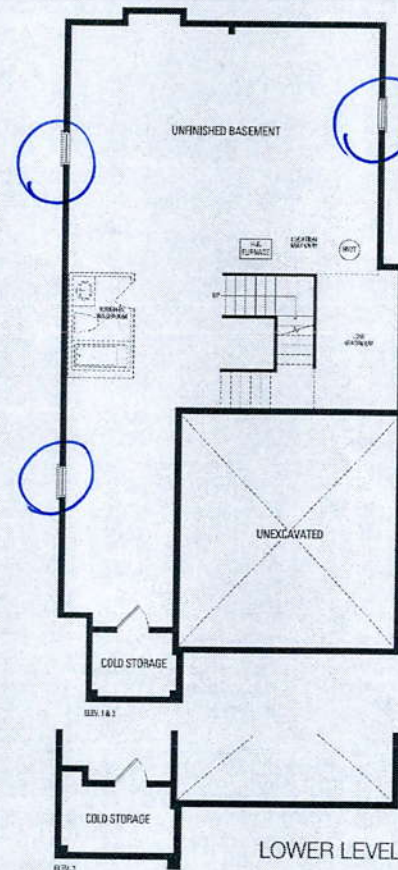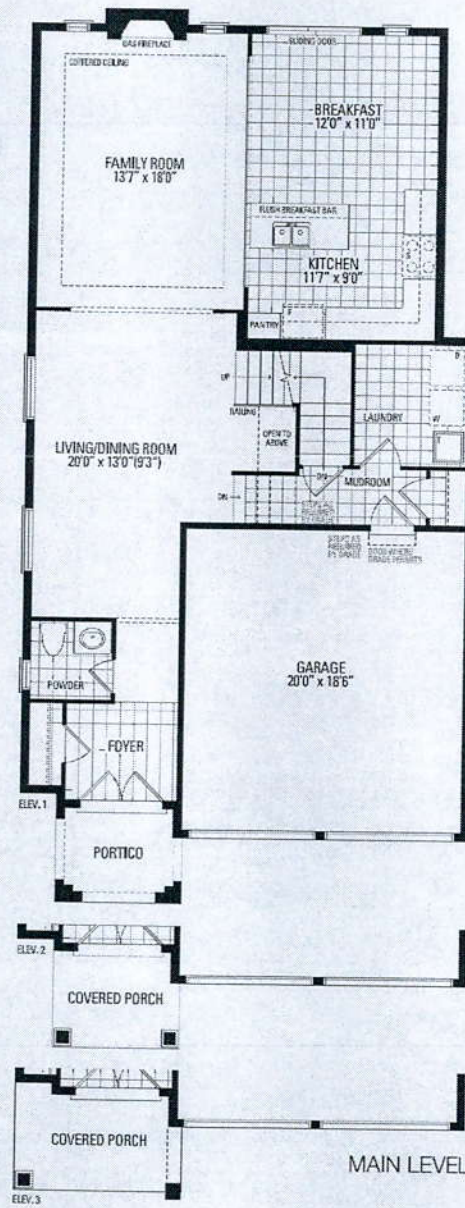

** Enlarge Basement Windows **