


- STORM CONNECTION  
--- SANITARY CONNECTION  
--- WATER CONNECTION  
H HYDRO CONNECTION  
□ DOUBLE CATCH BASIN  
□ CATCH BASIN  
H HYDRANT  
⊗ VALVE AND CHAMBER  
⊗ STREET SIGN
- △ ENTRANCE DOOR LOCATION  
▲ GARAGE DOOR LOCATION  
\* ENGINEERED FILL LOT  
● SANITARY MANHOLE  
○ STORM MANHOLE  
MAIL COMMUNITY MAILBOX  
○ DOWNSPOUT LOCATION  
← SWALE DIRECTION
- STREET LIGHT  
▲ TRANSFORMER  
⊗ CABLE TV PEDESTAL  
■ BELL PEDESTAL  
FG BELL/ROG. FLUSH TO GRADE  
H HYDRO METER  
G GAS METER  
⊗ AIR-CONDITIONING UNIT
- SP SUMP PUMP  
F.FLR. FINISHED FLOOR ELEVATION  
T/WALL TOP OF FOUNDATION WALL  
F.SLAB FIN. BASEMENT FLOOR SLAB  
U/FTG. UNDERSIDE FOOTING ELEVATION  
PROPOSED 3:1 SLOPE  
100.00 PROPOSED GRADE  
SW ×100.00 PROPOSED SWALE GRADE

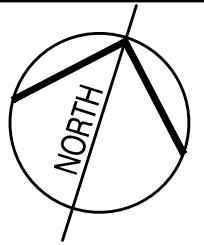

REVIEWED ONLY AS TO GENERAL COMPLIANCE WITH THE INTENT OF THE GRADING AND SERVICING DRAWINGS. THE ENGINEER DOES NOT WARRANT THAT THE INFORMATION CONTAINED ON THIS PLAN IS EITHER ACCURATE OR CORRECT. SOLE RESPONSIBILITY FOR CORRECT DESIGN, DETAILS AND DIMENSIONS WILL REMAIN WITH THE PARTY SUBMITTING THE DRAWING

- REVIEWED  
□ REVIEWED AS NOTED  
□ REVISE AND RESUBMIT

The MUNICIPAL INFRASTRUCTURE Group Ltd.


Date: Apr 11, 2023 By: Abdul Ahmadzai



No unprotected openings permitted within 1.2 metres of the lot line as per 9.10.14 of the Ontario Building Code.



45 MINUTE RATED WALL  
WITH SIDE YARD < 1.2m

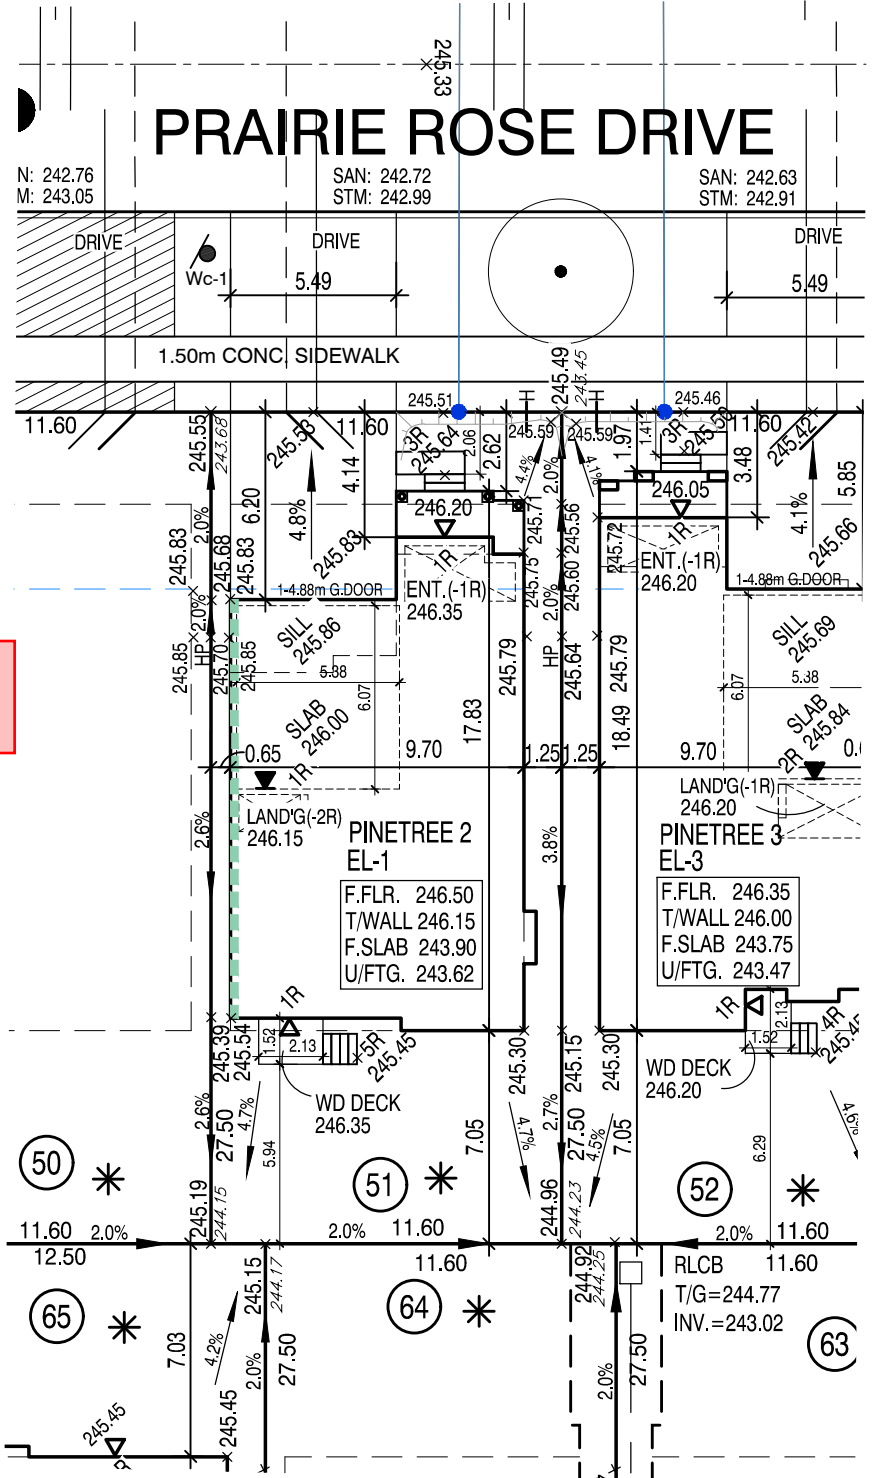

5		
4		
3		
2	APR. 03, 2023	REV. AS PER ENGINEERS COMMENTS & ISSUED FOR BUILDING PERMIT
1	MAR. 27, 2023	ISSUED FOR CLIENTS/ENGINEERS GRADING REVIEW.

REVISIONS:

#### BUILDING STATISTICS

REG. PLAN No.	65M-4737
ZONE	RWS2
LOT NUMBER	LOT 51
LOT AREA (m²)	319.00
BLDG AREA (m²)	151.34
LOT COVERAGE (%)	47.44%
MAX HEIGHT (3.5 STOREYS)	
No. OF STOREYS	2 STOREYS

I HEREBY CERTIFY THAT THE BUILDING TYPE, APPURTENANT GRADING, DRAINAGE AND SERVICING WORKS PROPOSED FOR LOT 51, PLAN 65M-4737 COMPLIES WITH SOUND ENGINEERING DESIGN AND THAT THE PROPOSED GRADING IS IN CONFORMITY WITH THE OVERALL GRADING PLANS REVIEWED AS SCHEDULES TO THE SUBDIVISION AGREEMENT AND WITH ADJACENT LANDS FOR BOTH DRAINAGE AND RELATIVE ELEVATIONS.

DATE: April 11, 2023. REVIEWED: A.A. Ahmadzai



SCALE 1:250



ROUNDEL HOMES INC. (PH-2)

PROJ. No. 23-01

MUNICIPAL ADDRESS

LOT No. 51

PRAIRIE ROSE DRIVE



REG. PLAN

PART OF LOT 29,  
CONCESSION 2  
(GEOGRAPHIC TOWNSHIP OF MARKHAM, COUNTY OF YORK)  
CITY OF RICHMOND HILL 65M-4737  
REGIONAL MUNICIPALITY OF YORK

THE CONTRACTOR SHALL CHECK AND VERIFY ALL DIMENSIONS AND CONDITIONS ON SITE BEFORE PROCEEDING WITH CONSTRUCTION. ANY DISCREPANCIES SHALL BE REPORTED TO JARDIN DESIGN GROUP INC. PRIOR TO COMMENCEMENT OF WORK. JARDIN DESIGN GROUP INC. IS NOT RESPONSIBLE FOR THE ACCURACY OF SURVEY, STRUCTURAL OR ENGINEERING INFORMATION SHOWN ON THESE DRAWINGS OR FOR CONSTRUCTION STARTED PRIOR TO THE ISSUANCE OF A BUILDING PERMIT. REFER TO THE APPROPRIATE ENGINEERING DRAWINGS BEFORE PROCEEDING WITH WORK.

The undersigned has reviewed and takes responsibility for this design and has the qualifications and meets the requirements set out in the Ontario Building Code to be a designer

QUALIFICATION INFORMATION  
Required unless design is exempt under Division C, Subsection 3.2.4 of the building code

Walter Botte 21031

NAME SIGNATURE BCIN

REGISTRATION INFORMATION  
Required unless design is exempt under Division C, Subsection 3.2.4 of the building code

jardin design group inc. 27763

FIRM NAME BCIN

jardin  
DESIGN GROUP INC.

64 JARDIN DR. SUITE 3A  
VAUGHAN ONT. L4K 3P3  
TEL: 905.660.3877 FAX: 905.660.3713  
EMAIL: info@jardindesign.ca

05/24/2023

RECEIVED

Per: Joshua Nabua