

CONSTRUCTION SUMMARY

Palmetto - Zadorra Estates Corp.

RECEIVED

JUL 18 2023

TEL: RES.: 514-586-8950

PURCHASERS: Naresh KUMAR and Laila KUMARI

LOT / PHASE 55 / 1	REG. PLAN #	HOUSE TYPE Rose 6 Elev 3 (5 Bedroom)		
-----------------------	-------------	---	--	--

CONSTRUCTION

2 - ENLARGED BASEMENT WINDOWS (MAY REQUIRE WINDOW WELLS) - WINDOW IS 30 INCHES X 24 INCHES 13Jul23 Note:	
--	--

PROMOTIONAL


1 - PARTIAL REDEMPTION OF PROMOTIONAL PACKAGE \$1,300.00 BALANCE FORWARD \$13,700.00 TO BE USED AT A LATER DATE. ORIGINAL PROMOTIONAL PACKAGE OF \$15,000.00 AS PER SCHEDULE PE. 13Jul23 Note:	
--	--

This Document is Extremely Time Sensitive - Printed 13 Jul 23 at 8:29

Lot 55 Zadora

Rose 6 40' LOT

ELEVATION 1 3,215 sq.ft. • ELEVATION 2 3,197 sq.ft. • ELEVATION 3 3,197 sq.ft.
INCLUDES 11 SQ.FT. OF OPEN AREA.

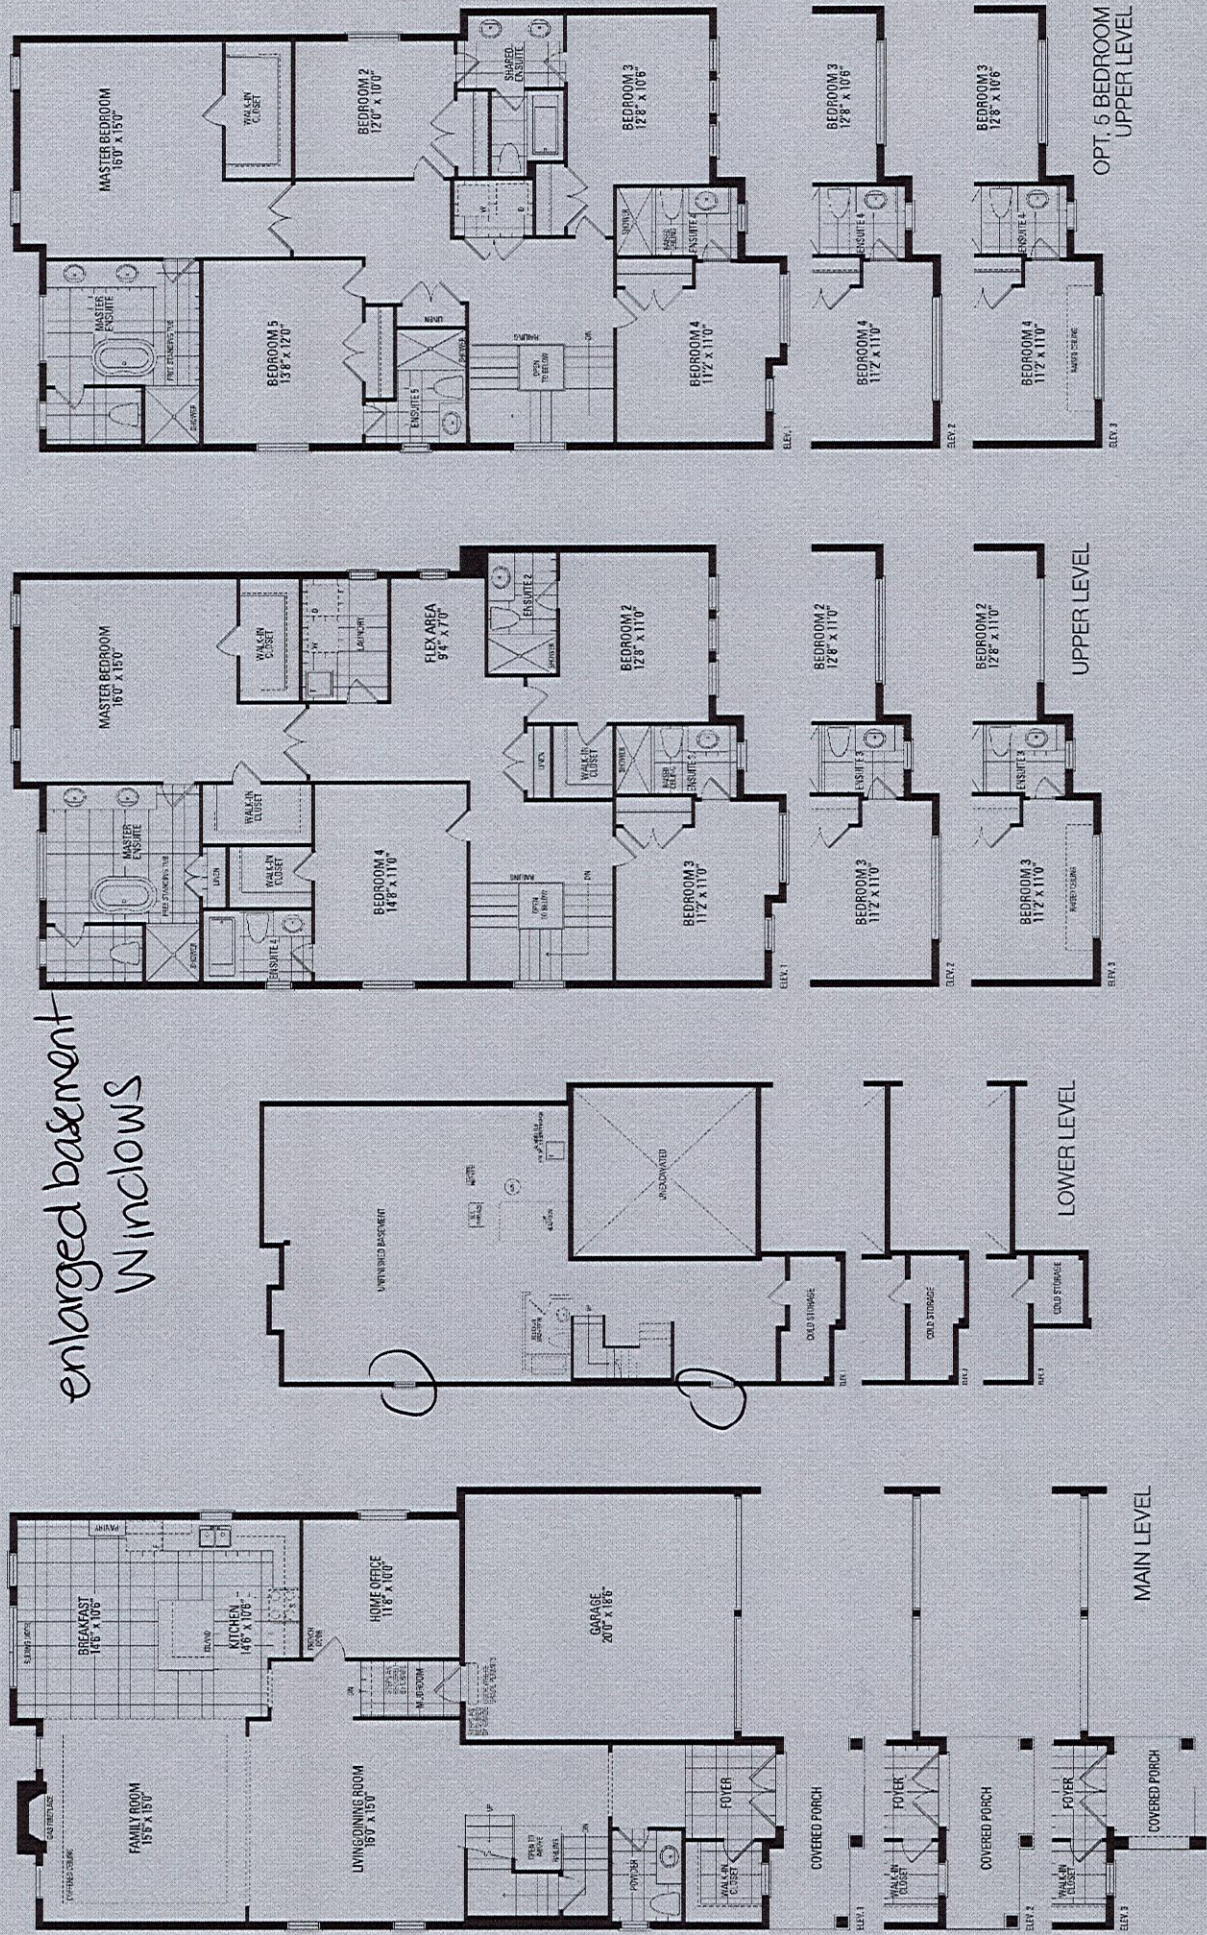

Orientation of home may be reversed and purchaser agrees to accept the same. Steps and porches may vary at any exterior entrance ways due to grading variance. Actual usable floor space may vary from the stated floor areas. All renderings are artist's concept. Dimensions, specifications and architectural detailing subject to modifications. Roofline and adjoining model types may vary due to siting. E. & O. E. May 2023