

PRELIMINARY

CONSTRUCTION SUMMARY

RECEIVED

Palmetto - Zadorra Estates Corp.

JUL 24 2023

TEL: RES.: 647-866-7249

PURCHASER: Senthuran VITHTHIYAPASKARAN

LOT / PHASE 6 / 1	REG. PLAN #	HOUSE TYPE River 11 Elev 1		
----------------------	-------------	-------------------------------	--	--

CONSTRUCTION

3 - ENLARGED BASEMENT WINDOWS (MAY REQUIRE WINDOW WELLS) - WINDOW IS 30 INCHES X 24 INCHES 21Jul23 Note:	
---	--

PROMOTIONAL



1 - PARTIAL REDEMPTION OF PROMOTIONAL PACKAGE \$1,950 BALANCE FORWARD \$8,050 TO BE USED AT A LATER DATE. ORIGINAL PROMOTIONAL PACKAGE OF \$10,000 AS PER SCHEDULE PE. 21Jul23 Note:	
--	--

This Document is Extremely Time Sensitive - Printed 21 Jul 23 at 13:46

River II 30' LOT
FOR LOT 6 Zadorra

ELEVATION 1 2,139 sq.ft. • ELEVATION 2 2,139 sq.ft. • ELEVATION 3 2,139 sq.ft.
INCLUDES 10 SQ.FT. OF OPEN AREA

enlarged
Basement windows

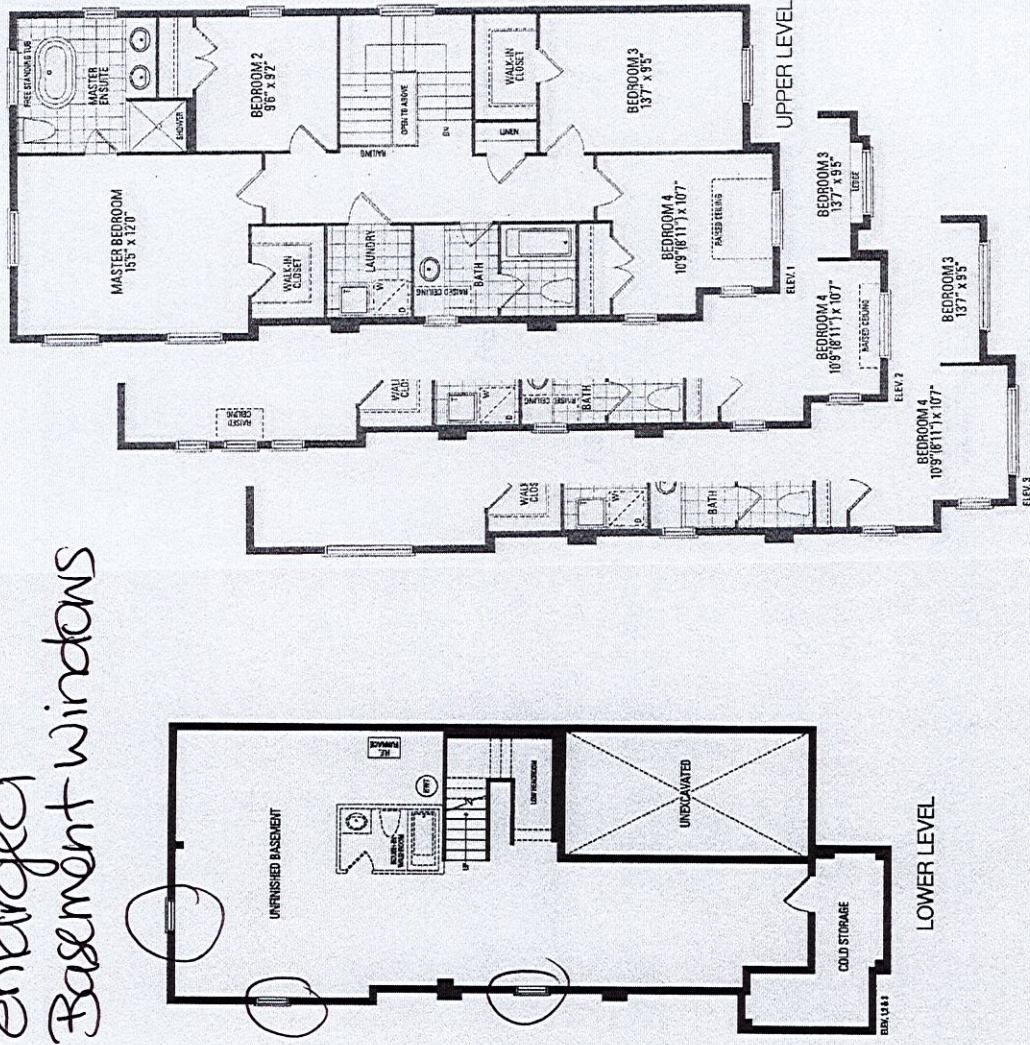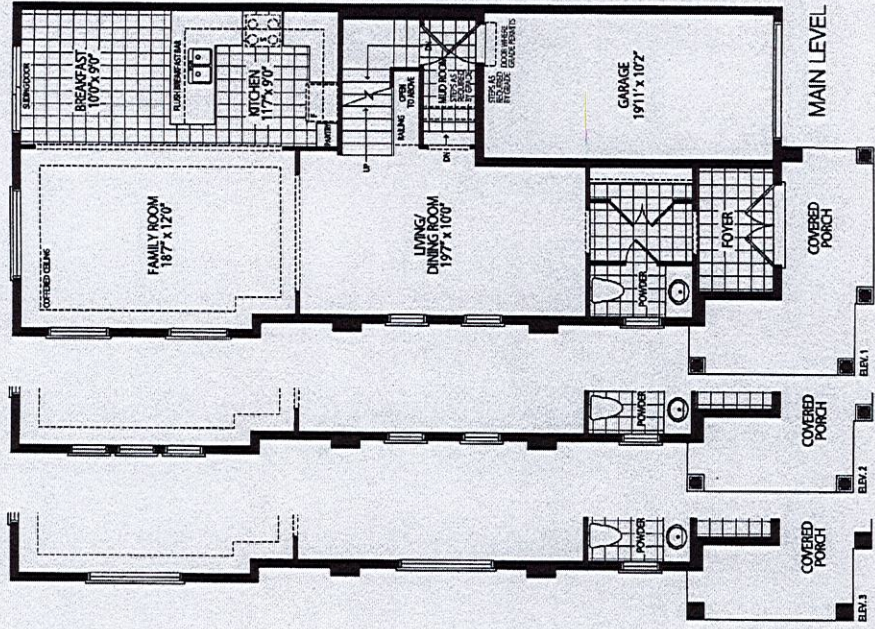

Orientation of home may be reversed and purchaser agrees to accept the same. Steps and porches may vary at any exterior entrance ways due to grading variance. Actual usable floor space may vary from the stated floor areas. All renderings are artist's concept. Dimensions, specifications and architectural detailing subject to modifications. Roofline and adjoining model types may vary due to siting. E. & O. E. ~~1-15-2022~~

Rev. 2023 June