

CONSTRUCTION SUMMARY		AUG 24 2023	
Palmetto - Zadorra Estates Corp.		TEL: RES.: 647-380-0869	
PURCHASERS: Liventh MUTHIAH and Muthiah MARIMUTHU			

LOT / PHASE	REG. PLAN #	HOUSE TYPE		
63 / 1		Rose 12 Elev 2		

CONSTRUCTION

1 - FIRST FLOOR INCREASE CEILING HEIGHT FROM 9 FEET TO 10 FEET 18Aug23 Note:	
4 - ENLARGED BASEMENT WINDOWS (MAY REQUIRE WINDOW WELLS) - WINDOW IS 30 INCHES X 24 INCHES 18Aug23 Note:	

PROMOTIONAL


1 - LESS CREDIT FROM PURCHASER EXTRA SHEET IN OFFER 18Aug23 Note:	
--	--

This Document is Extremely Time Sensitive - Printed 18 Aug 23 at 14:33

LOT #63

Rose 12 40' LOT

ELEVATION 1 3,162 sq.ft. • ELEVATION 2 3,162 sq.ft. • ELEVATION 3 3,162 sq.ft.

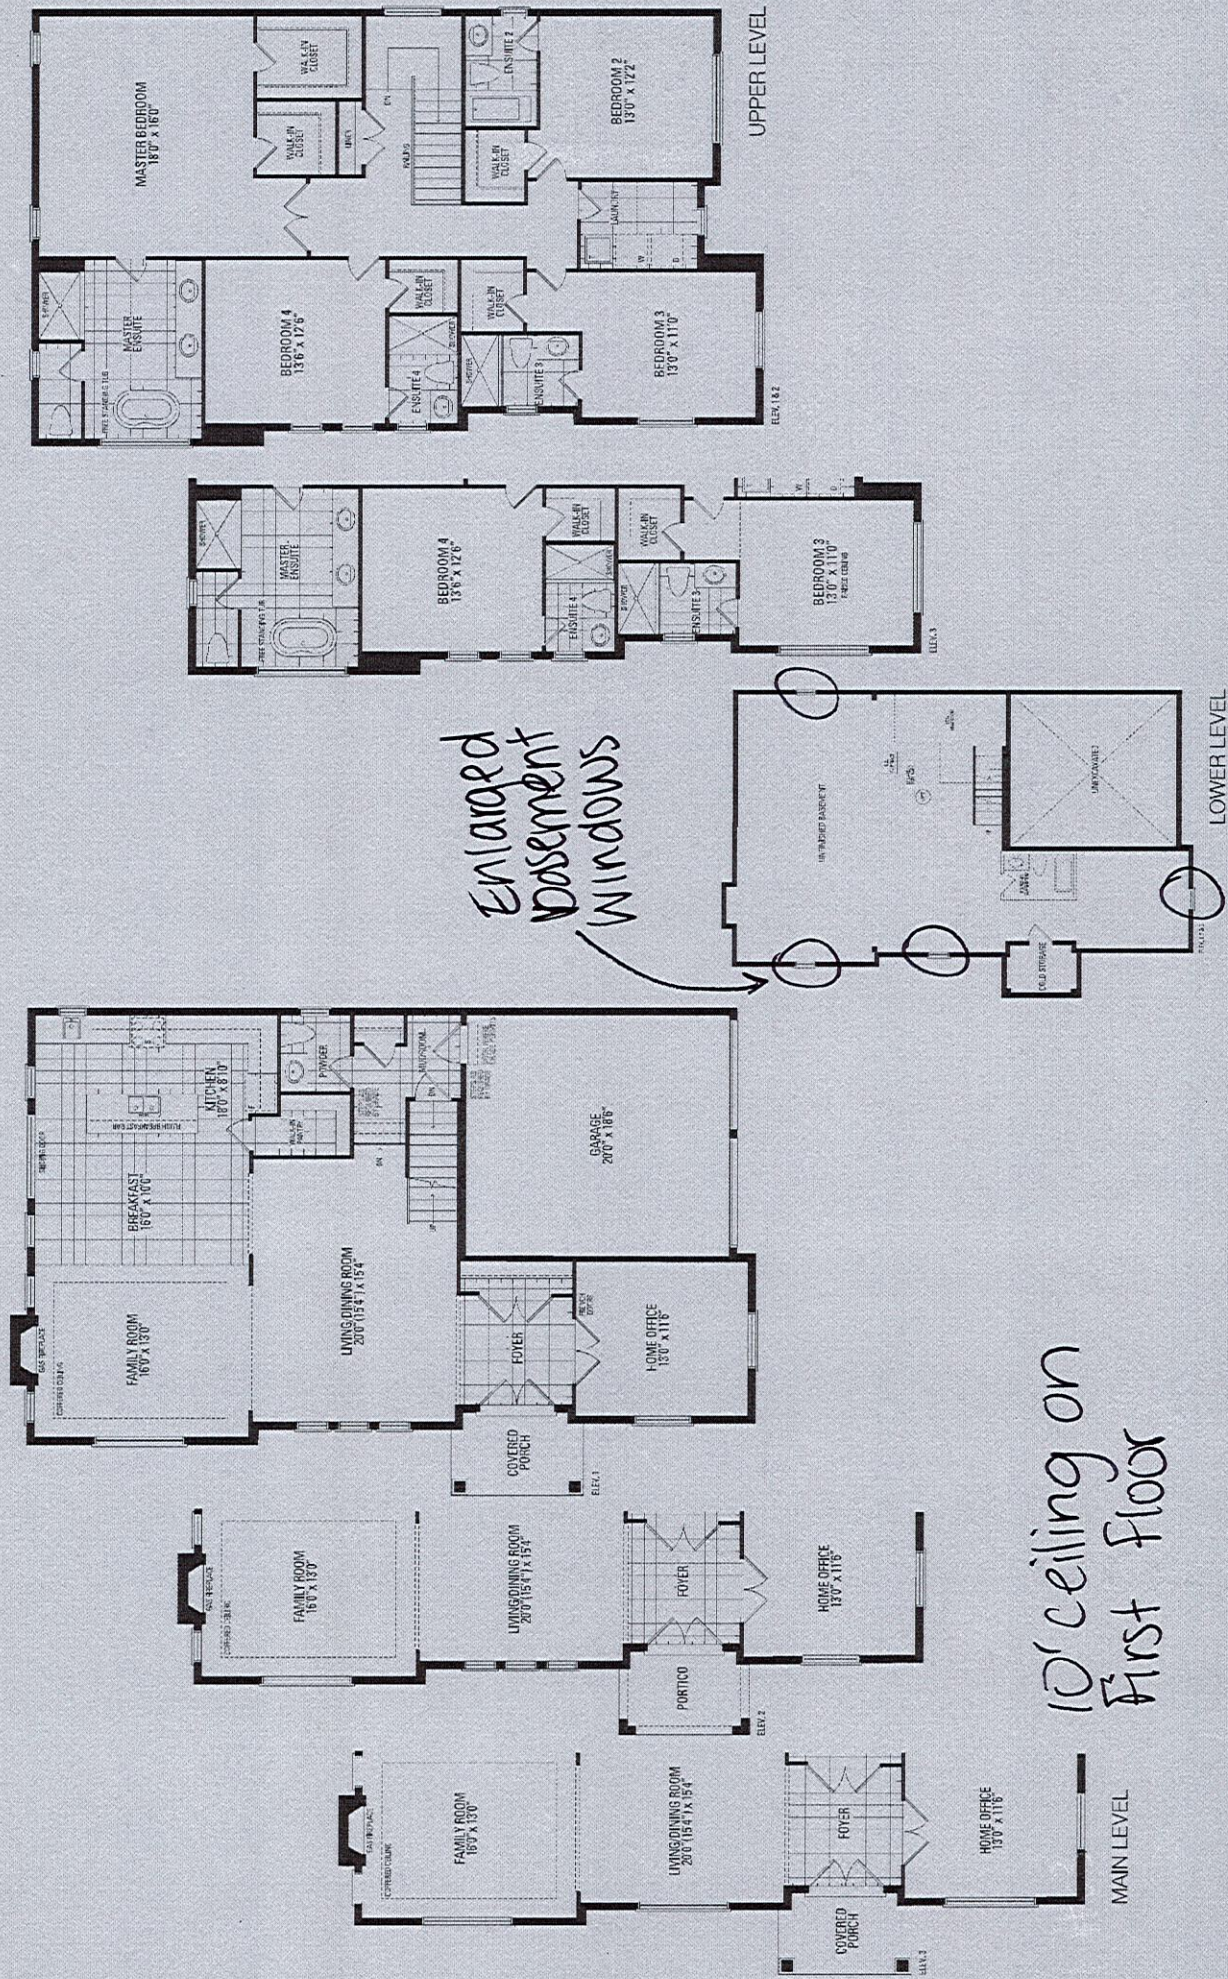

Orientation of home may be reversed and purchaser agrees to accept the same. Steps and porches may vary at any exterior entrance ways due to grading variance. Actual usable floor space may vary from the stated floor areas. All renderings are artist's concept. Dimensions, specifications and architectural detailing subject to modifications. Poolline and adjoining model types may vary due to siting. E. & O. E. May 2023