

CONSTRUCTION SUMMARY				
Palmetto - Zadorra Estates Corp.				
PURCHASER: Dakshina Murthy NAMANI			TEL: RES.: 514-702-1773	

LOT / PHASE	REG. PLAN #	HOUSE TYPE		
9 / 1		River 6 Elev 3		

ELECTRICAL

1 - STANDARD DINING ROOM LIGHT TO BE CENTERED BETWEEN LIVING AND DINING ROOM 18Sep23 Note:	
1 - RELOCATE STANDARD KITCHEN LIGHT TO BE CENTERED OVER ISLAND 18Sep23 Note:	

PLUMBING

1 - WATER LINE FOR FRIDGE - ROUGH-IN ONLY 18Sep23 Note:	
--	--

PROMOTIONAL

1 - PARTIAL REDEMPTION OF PROMOTIONAL PACKAGE \$395.00. BALANCE FORWARD \$9,605.00 TO BE USED AT A LATER DATE. ORIGINAL PROMOTIONAL PACKAGE OF \$10,000.00 AS PER SCHEDULE PE. 18Sep23 Note:	
---	--

EXTRAS AS PER OFFER


The Vendor agrees that notwithstanding any other term or provision in this Agreement included in the Purchase Price and in addition to those items detailed in Schedule GP to the Agreement of Purchase and Sale, the Purchaser is entitled to a credit of Ten Worksheet Note:	
---	--

This Document is Extremely Time Sensitive - Printed 18 Sep 23 at 15:30

LOT #9

River 6 30' LOT

ELEVATION 1 2,610 sq.ft. • ELEVATION 2 2,615 sq.ft. • ELEVATION 3 2,615 sq.ft.
INCLUDES 14 SQ.FT. OF OPEN AREA

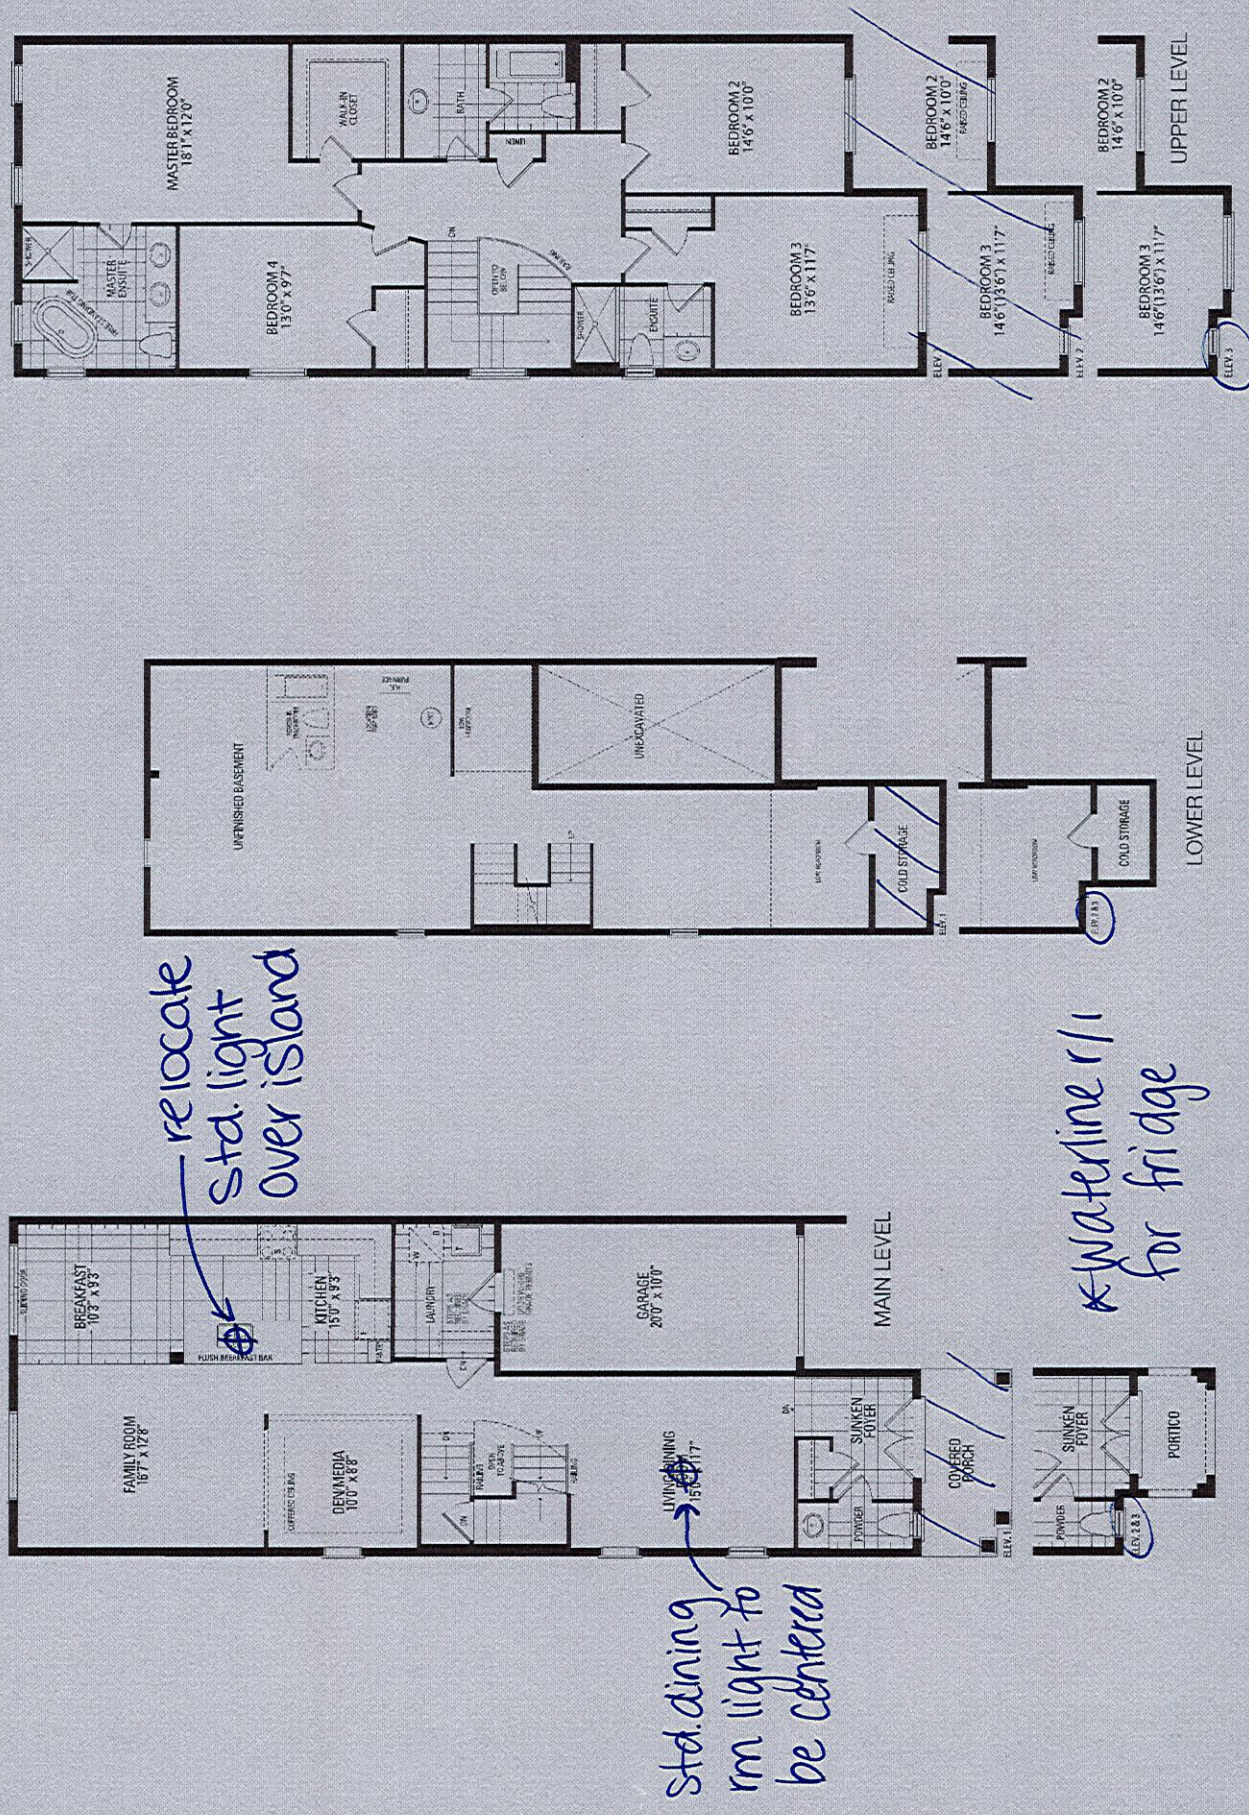

Orientation of home may be reversed and purchaser agrees to accept the same. Steps and porches may vary at any exterior entrance ways due to grading variance. Actual usable floor space may vary from the stated floor areas. All renderings are artist's concept. Dimensions, specifications and architectural detailing subject to modifications. Roofline and adjoining model types may vary due to siting. E. & O. E. May 2023