

CONSTRUCTION SUMMARY				
Palmetto - Zadorra Estates Corp.				
PURCHASERS: Shair Baz SHAH and Hina Mir BAZ			RECEIVED OCT 12 2023	TEL: RES.: 306-715-8443
LOT / PHASE 37 / 1	REG. PLAN #	HOUSE TYPE Villa 2 Elev 1		

CONSTRUCTION

1 - FIRST FLOOR INCREASE CEILING HEIGHT FROM 9 FEET TO 10 FEET 13Jul23 Note:	
3 - ENLARGED BASEMENT WINDOWS (MAY REQUIRE WINDOW WELLS) - WINDOW IS 30 INCHES X 24 INCHES 12Jul23 Note:	

ELECTRICAL

1 - RELOCATE STANDARD KITCHEN LIGHT TO BE CENTERED OVER ISLAND 10Oct23 Note:	
1 - STANDARD DINING ROOM LIGHT TO BE CENTERED BETWEEN LIVING AND DINING ROOM 10Oct23 Note:	

HEATING AND AIR CONDITIONING

1 - HUMIDIFER 10Oct23 Note:	
-----------------------------------	--

MISCELLANEOUS

1 - GARAGE DOOR OPENER – LIFTMASTER 8155 WITH BELT DRIVE – INCLUDES 1 KEY PAD & 2 HANDHELD CONTROLS - PRICE IS FOR TWO GARAGE DOORS 10Oct23 Note:	
---	--

PROMOTIONAL

1 - LESS BALANCE OF CREDIT FROM PURCHASER EXTRA SHEET IN OFFER 13Jul23 Note:	
1 - PARTIAL REDEMPTION OF PROMOTIONAL PACKAGE \$1,950.00. BALANCE FORWARD \$13,050.00 TO BE USED AT A LATER DATE. ORIGINAL PROMOTIONAL PACKAGE OF \$15,000.00 AS PER SCHEDULE PE. 12Jul23 Note:	

EXTRAS AS PER OFFER

The Vendor agrees that notwithstanding any other term or provision in this Agreement included in the Purchase Price and in addition to those items detailed in Schedule GP to the Agreement of Purchase and Sale, the Purchaser is entitled to a credit of Fif Worksheet Note:	
--	--

This Document is Extremely Time Sensitive - Printed 10 Oct 23 at 15:14

LOT #37

Villa 2 36' LOT


ELEVATION 1 2,527 sq.ft. • ELEVATION 2 2,527 sq.ft. • ELEVATION 3 2,523 sq.ft.

INCLUDES 10 SQ.FT. OF OPEN AREA

Enlarged
Basement
Windows

relocate
std. light

std. dining
rm light to
be centered

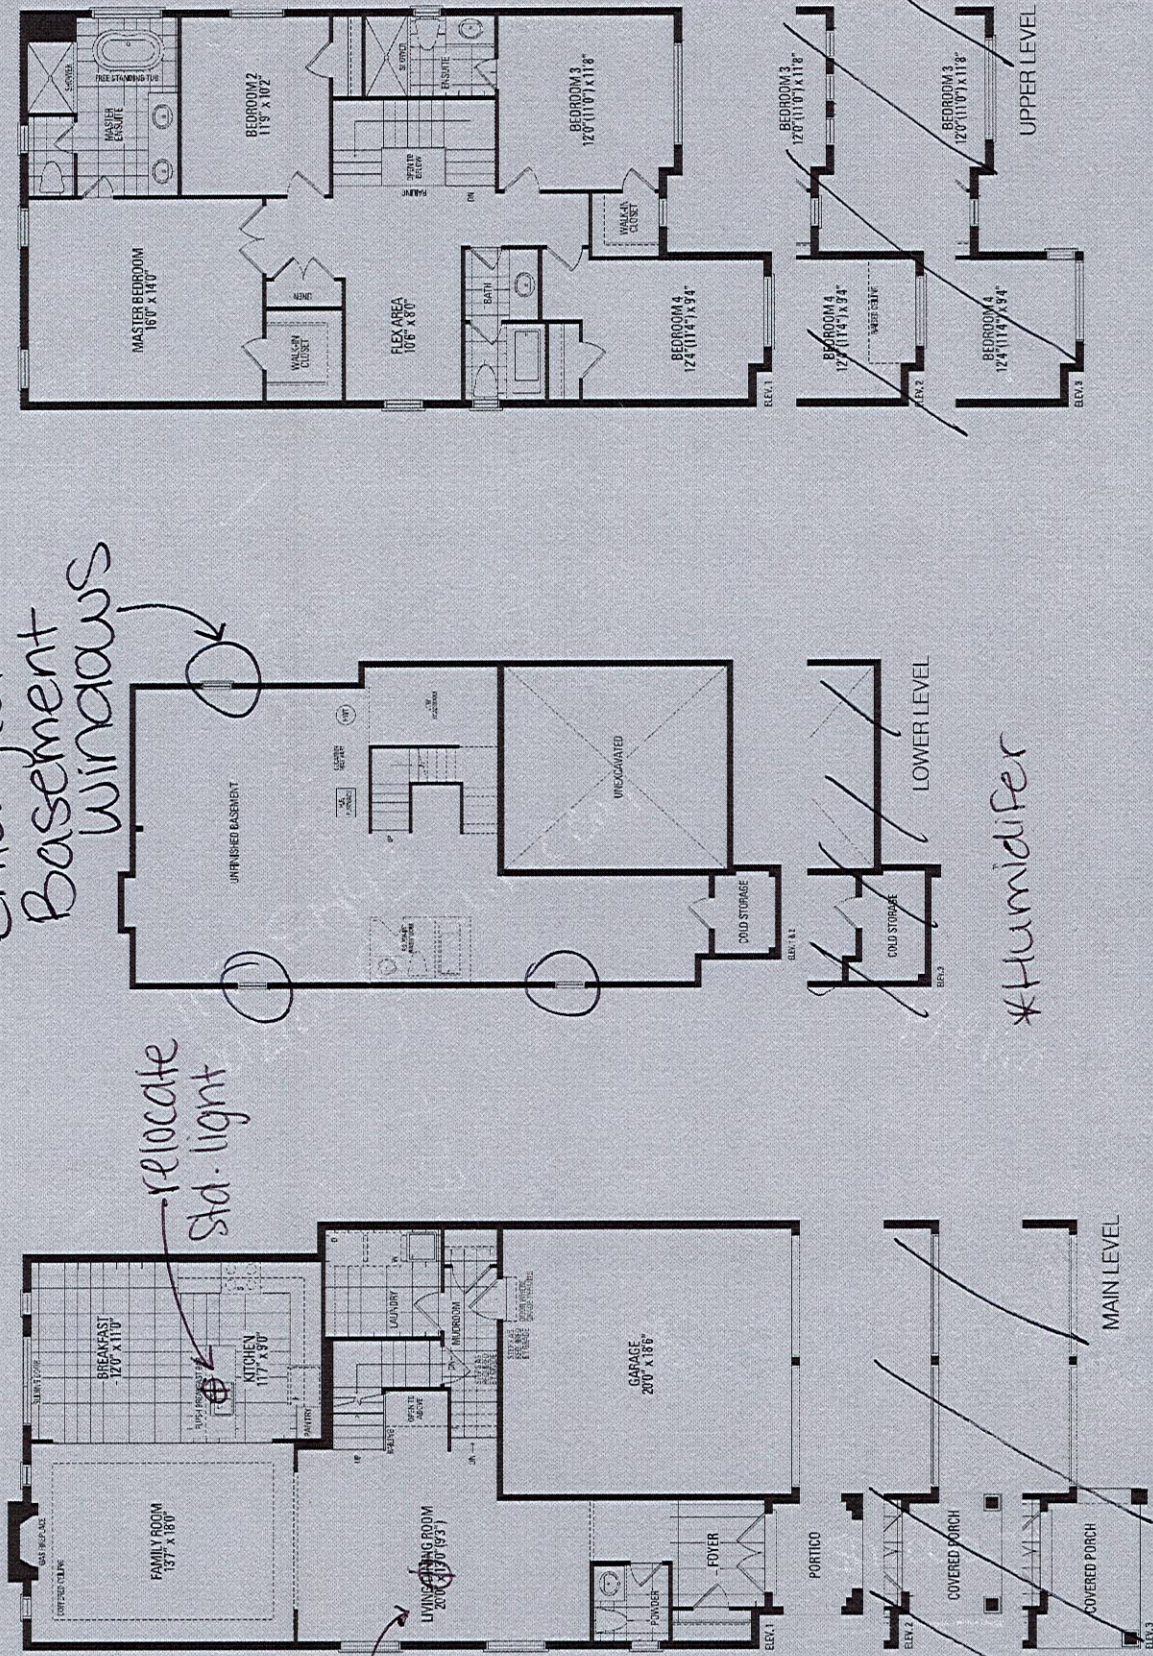

10' Ceiling on first floor