Greenpark.

PRELIMINARY UPGRADES

		ONSTRUCTION SUMMARY Palmetto - Zadorra Estates Corp.		7 2023		
PURCHASERS: Sefiu Olale	kan YEKINI and Opeyer	mi Monsurat YEKINI	001 1	, 2020	TEL: RES	.: 647-869-5031
LOT / PHASE	REG. PLAN#	HOUSE TYPE				
25 / 1		River 1 Elev 1				
CONSTRUCTION						
	C WINDOWS (MAY DE	EQUIRE WINDOW WELLS) - WINDOW IS 30	NCHES Y	24 INCH	FS	
02Oct23 Note:	I WINDOWS (MAT RE	EQUIRE WINDOW WELLS) - WINDOW 15 30	INCITES A	24 INCII	LS	
020ci25 Note.						
ELECTRICAL						
1 - ABOVE KITCHEN ISLA	ND - ADD LIGHT AND	SWITCH - NO FIXTURE INCLUDED				
13Oct23 Note:						
1 - LIGHT AND SWITCH - N	NO FIXTURE INCLUD	ED - LIVING ROOM				
13Oct23 Note:						
1 - POT LIGHT - TUB/SHOV	WER POT LIGHT					
13Oct23 Note: MAIN B						
HEATING AND AIR CO	NDITIONING					
1 - HUMIDIFER						
13Oct23 Note:						
DDOMOTIONAL *						
PROMOTIONAL						
1 - PARTIAL REDEMTION	OF PROMOTIONAL P.	ACKAGE \$1.835.00. BALANCE FORWARD \$2	21.865.00 To	O BE US	ED AT A LA	ATER

This Document is Extremely Time Sensitive - Printed 13 Oct 23 at 10:45

1 - PARTIAL REDEMTION OF PROMOTIONAL PACKAGE \$1,300.00. BALANCE FORWARD \$23,700.00 TO BE USED AT A LATER

DATE. ORIGINAL PROMOTIONAL PACKAGE OF \$25,000.00 AS PER SCHEDULE PE.


DATE. ORIGINAL PROMOTIONAL PACKAGE OF \$25,000.00 AS PER SCHEDULE PE.

13Oct23 Note:

02Oct23 Note:

River 1 30° LOT

ELEVATION 1 2,190 sq.ft. • ELEVATION 2 2,190 sq.ft. • ELEVATION 3 2,194 sq.ft

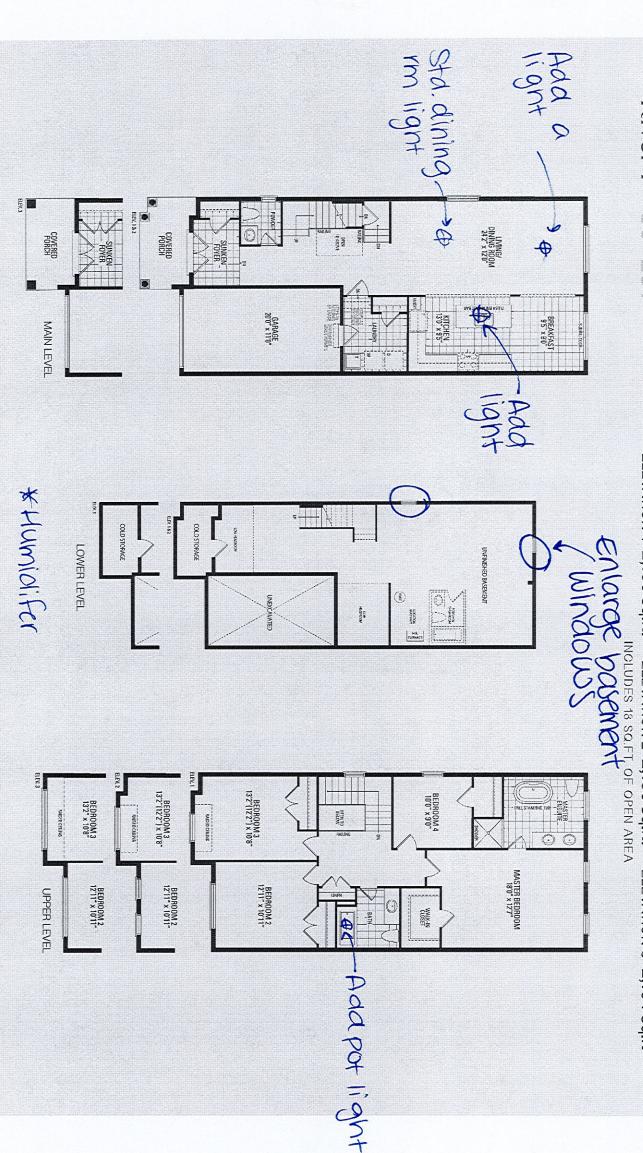

Orientation of home may be reversed and purchaser agrees to accept the same. Steps and porches may vary at any exterior entrance ways due to grading variance. Actual usable floor space may vary from the stated floor areas. All renderings are artist's concept. Dimensions, specifications and architectural detailing subject to modifications. Roofline and adjoining model types may vary due to siting. E. & O. E. May 2023 4